

INDEX OF SHEETS


1	TITLE SHEET
2	GENERAL NOTES
3	PROPOSED IMPROVEMENT
4	PROPOSED IMPROVEMENT
STATE OF VERMONT
AGENCY OF TRANSPORTATION



FEDERAL AID PRIMARY

PROPOSED IMPROVEMENT
TOWN OF LONDONDERRY
COUNTY OF WINDHAM
VT RTE II

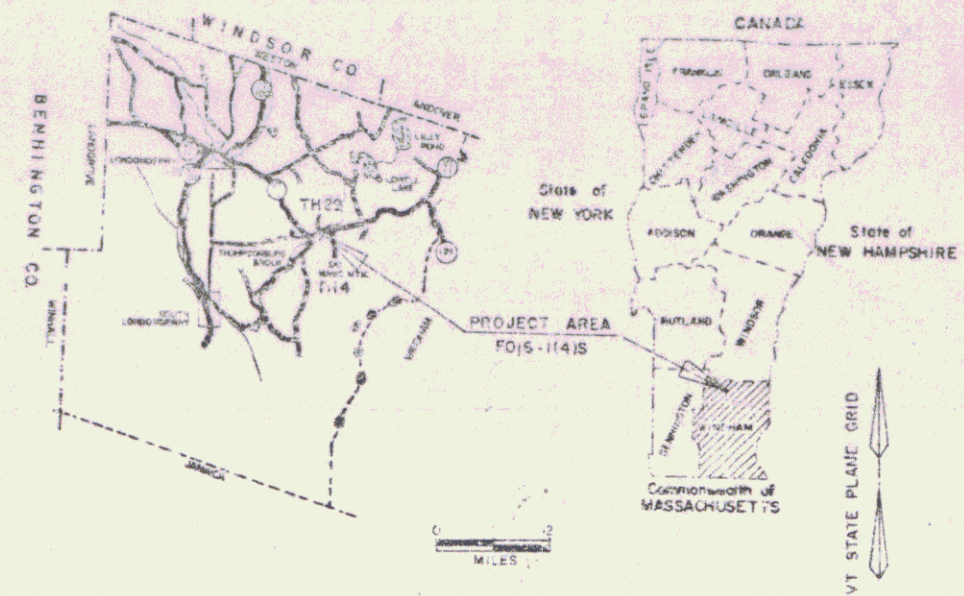

R.O.W. PLANS

BEGINNING AT A POINT ON VT RTE II APPROXIMATELY 4.621 MILES EASTERLY OF THE
LANDGROVE - LONDONDERRY TOWN LINE AND PROCEEDING EASTERLY FOR 0.098 MILES

EST 1960 ADT	= 2030
EST 2000 ADT	= 4230
EST 1960 DHV	= 290
EST 2000 DHV	= 590
D	= 52% EB
T	= 13% IDH
V	= 50 MPH

LENGTH OF ROADWAY 516.00 FEET = 0.098 MILES
LENGTH OF BRIDGE 0.0000 FEET = 0.000 MILES
LENGTH OF PROJECT 516.00 FEET = 0.098 MILES
LENGTH OF ROW PROJECT 800.00 FEET = 0.152 MILES

END R.O.W. PROJECT
F 016-1(4) S REV. STA. 250+00 @



BEGIN R.O.W. PROJECT
F 016-1(4) S REV. STA. 242+00 @

CONVENTIONAL SIGNS

COUNTY LINE	---
TOWN LINE	---
LIMITS OF ACCESS	---
POINT OF ACCESS	X
FENCE LINE	---
STONE WALL	---
TRAVELED WAY	---
GUARD RAIL	---
RAILROAD	---
SURVEY LINE	---
CULVERT	---
POWER POLE	○
TELEPHONE POLE	○
TREES	○
CONTROL OF ACCESS	---
PROPERTY LINE	---
R.O.W. TAKING LINE	---
SLOPE RIGHTS	○ SR ○
TOP OF CUT	○
TOP OF SLOPE	○

DATUM

VERTICAL	NVD 1988
HORIZONTAL	N.A.

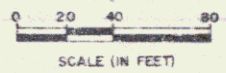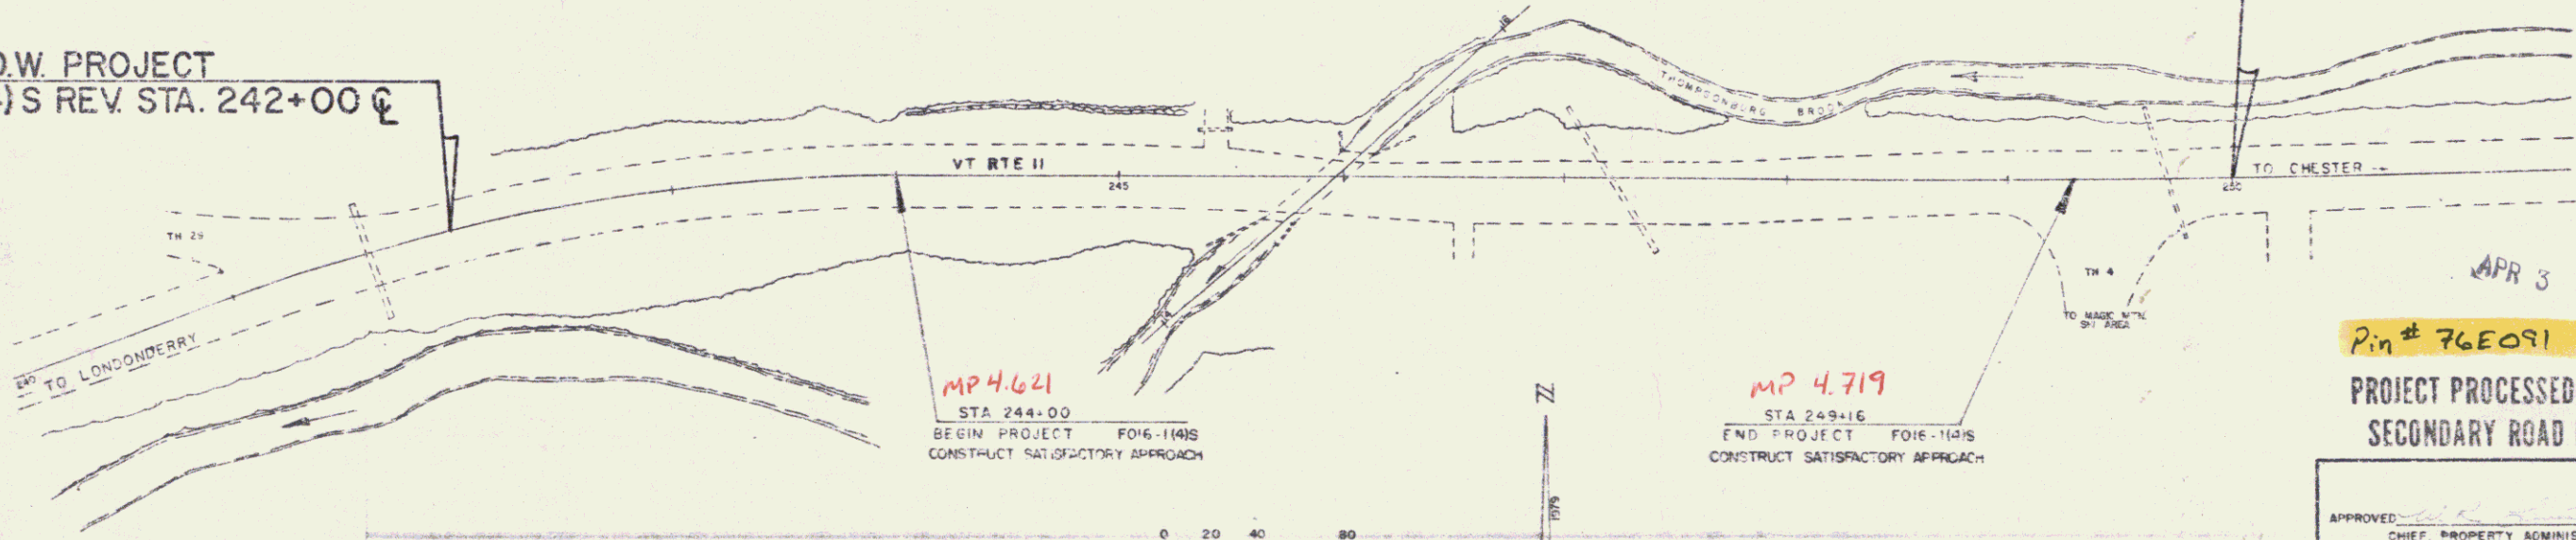

*NOT BUILT as of
2/21/90 possibly not
acquired 25*

These plans are subject to such engineering changes as may be required by the Federal Highway Administration or the Director of Engineering and Construction.
Construction is to be carried on in accordance with these plans and the Standard Specifications for Highway and Bridge Construction dated March, 1976, as approved by the Federal Highway Administration on October 27, 1976 for use on this project, including all subsequent revisions and such revised specifications and special provisions as are incorporated in these plans.

APR 3 1987
Pin # 76E091

PROJECT PROCESSED UNDER
SECONDARY ROAD PLAN,

APPROVED: _____ DATE 6-18-88
CHIEF, PROPERTY ADMINISTRATION

SUBMITTED BY: _____
DIRECTOR OF ENGINEERING AND CONSTRUCTION

APPROVED: S.J. O'NEILL DATE JULY 22 1987
DIRECTOR OF ENGINEERING AND CONSTRUCTION

DEPARTMENT OF TRANSPORTATION
FEDERAL HIGHWAY ADMINISTRATION

APPROVED: _____ DATE _____
DIVISION ADMINISTRATOR

PROJECT F. N. 016-1(4)S

SHEET 1 OF 6 SHEETS