


*Just Claim Deed
to Ronaldo J & Mary Jane Provost
Recorded 5/19/80 BK 29, Pg 334*

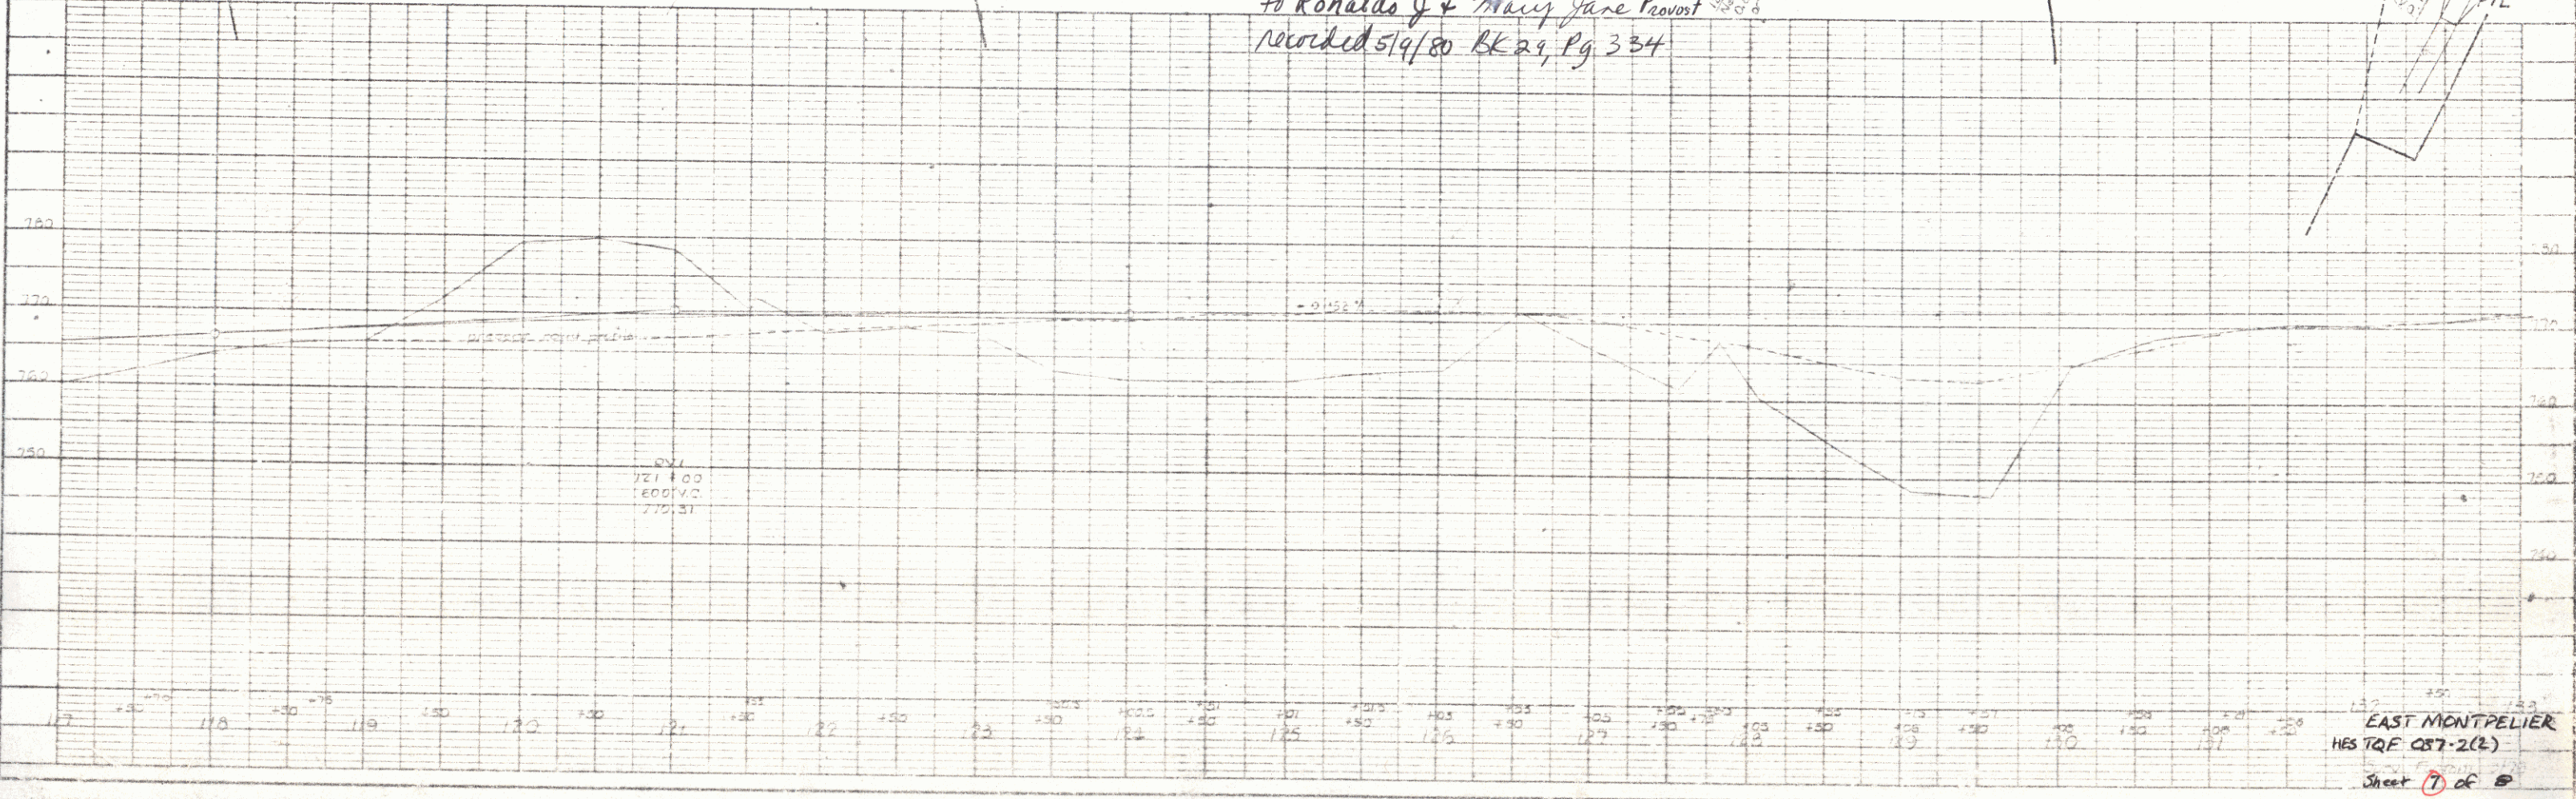

PLAN

DATE	1/15/80
BY	J.M.
CHECKED BY	J.M.
SCALE	AS SHOWN
PROJECT	STATE ROAD 102
LOCATION	STATE ROAD 102
DESCRIPTION	CONSTRUCTION OF ROAD

PROFILE

DATE	1/15/80
BY	J.M.
CHECKED BY	J.M.
SCALE	AS SHOWN
PROJECT	STATE ROAD 102
LOCATION	STATE ROAD 102
DESCRIPTION	CONSTRUCTION OF ROAD