


PLAN  
 SHEET NO. 5  
 OF 6  
 PROJECT TQS 0217(2)  
 STA. 75+00 Q

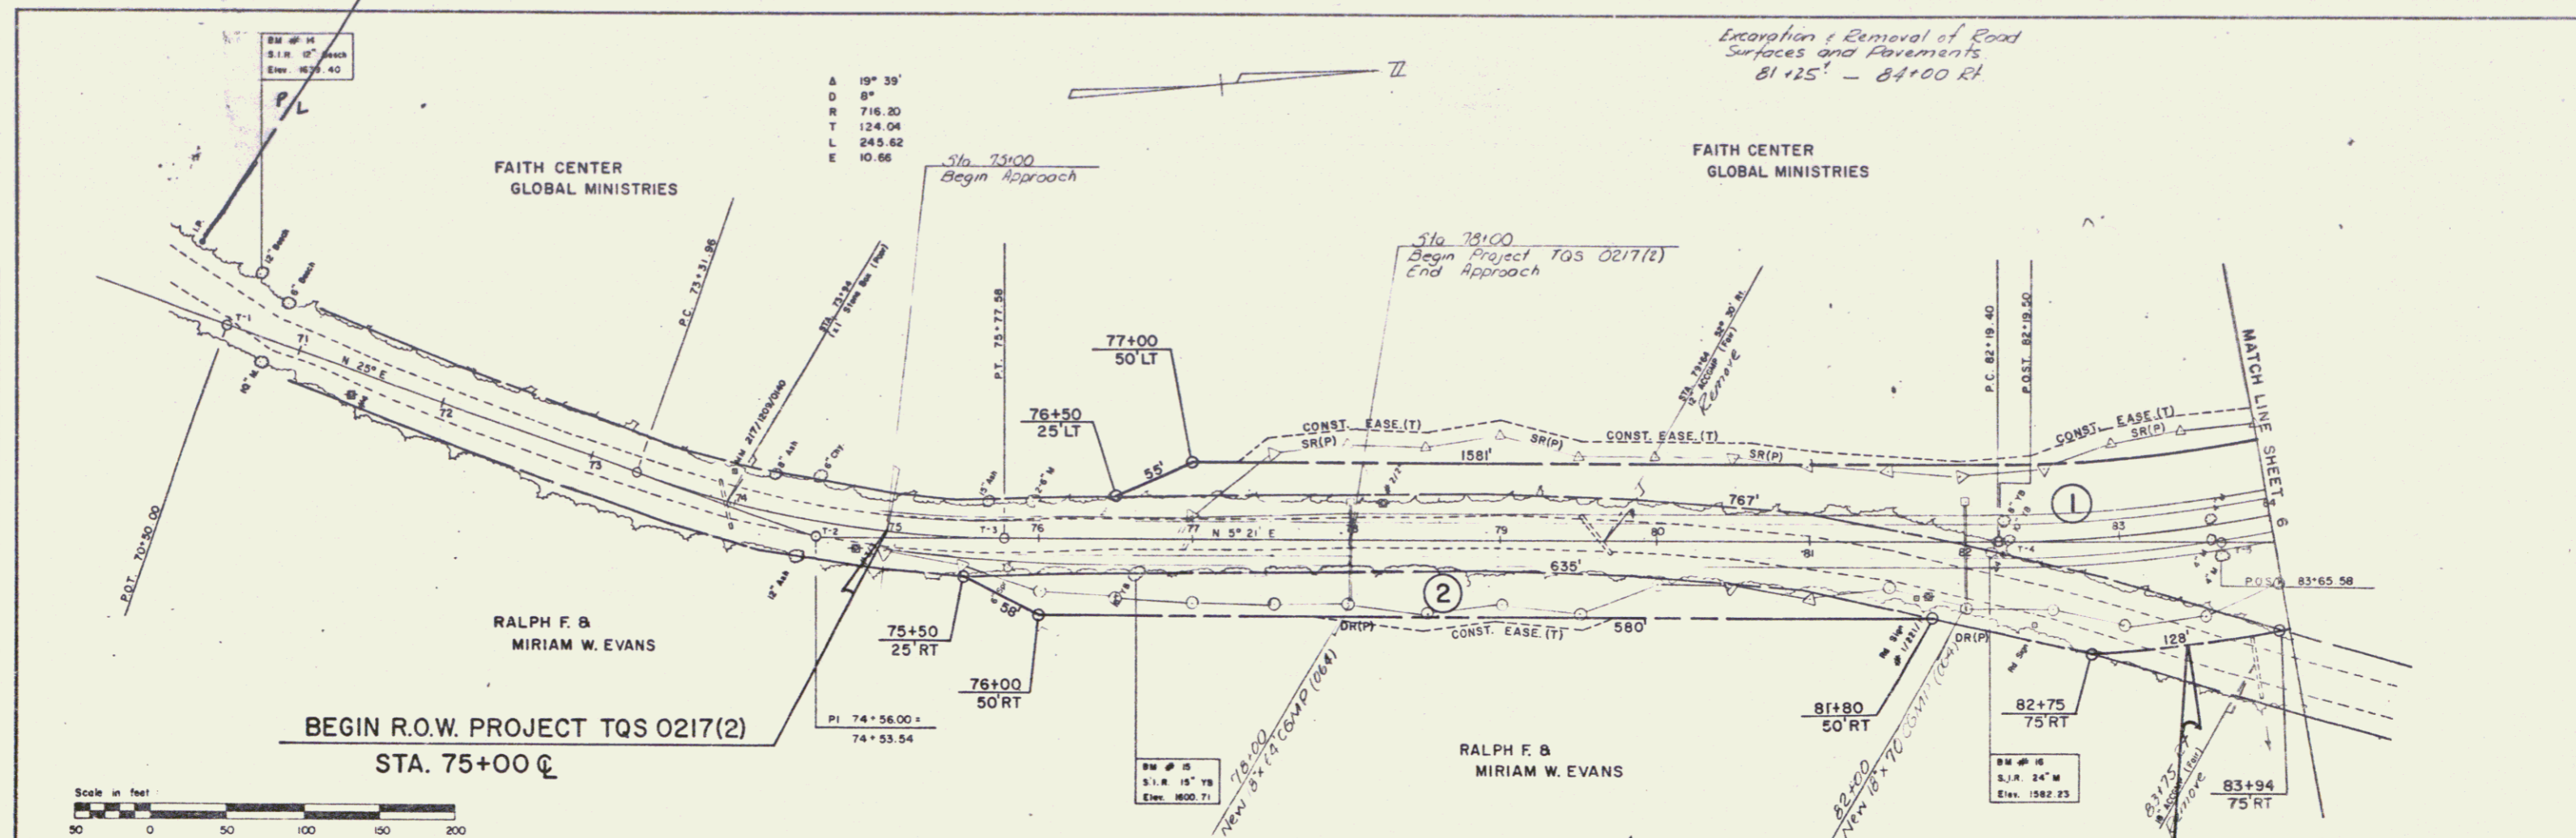

PROFILE  
 SHEET NO. 5  
 OF 6  
 PROJECT TQS 0217(2)  
 STA. 75+00 Q

