

PLAN	DATE
NO. 1	
BY	
CHECKED	
APPROVED	
DATE	

PROFILE	DATE
NO. 1	
BY	
CHECKED	
APPROVED	
DATE	

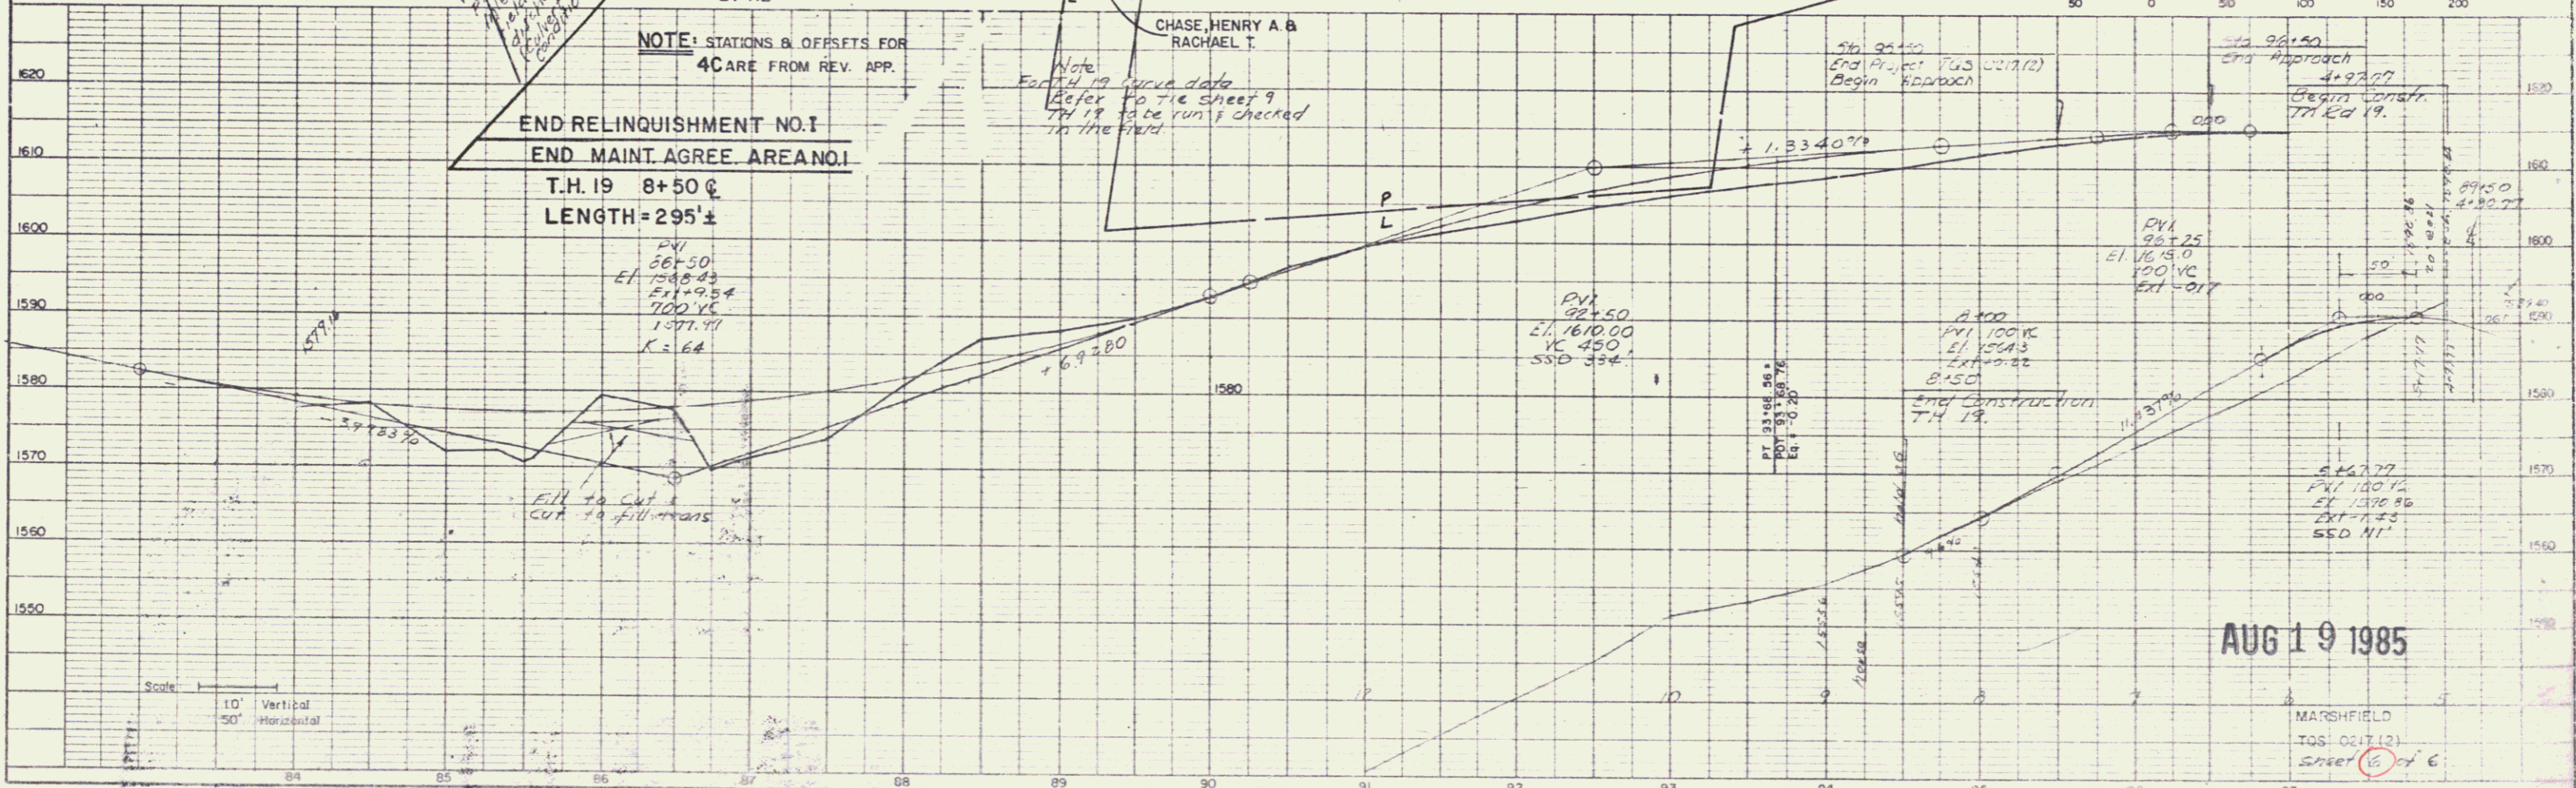
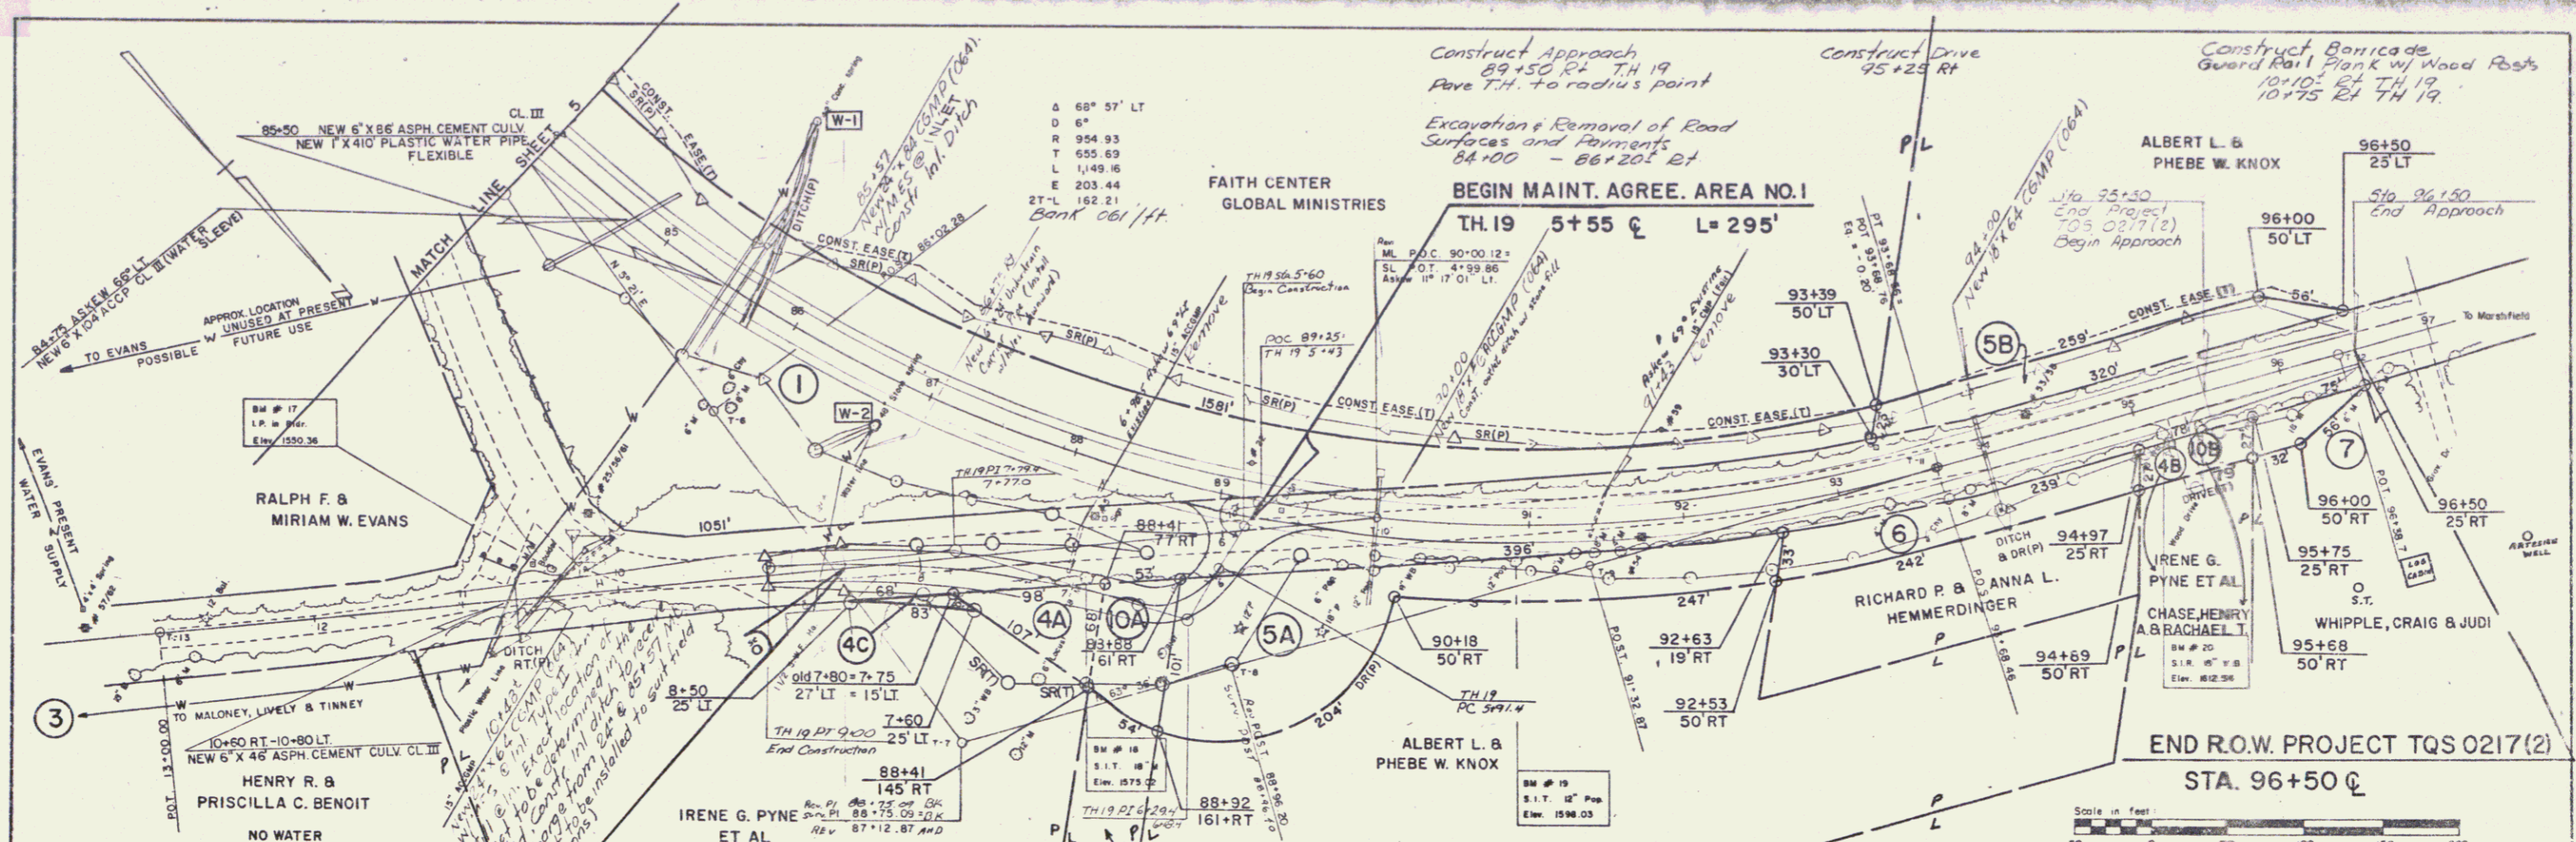


PLATE 1 - PLAN PROFILE  
K&S ENGINEERS & ARCHITECTS

AUG 19 1985

MARSHFIELD  
TQS 0217(2)  
Sheet 15 of 6

5