
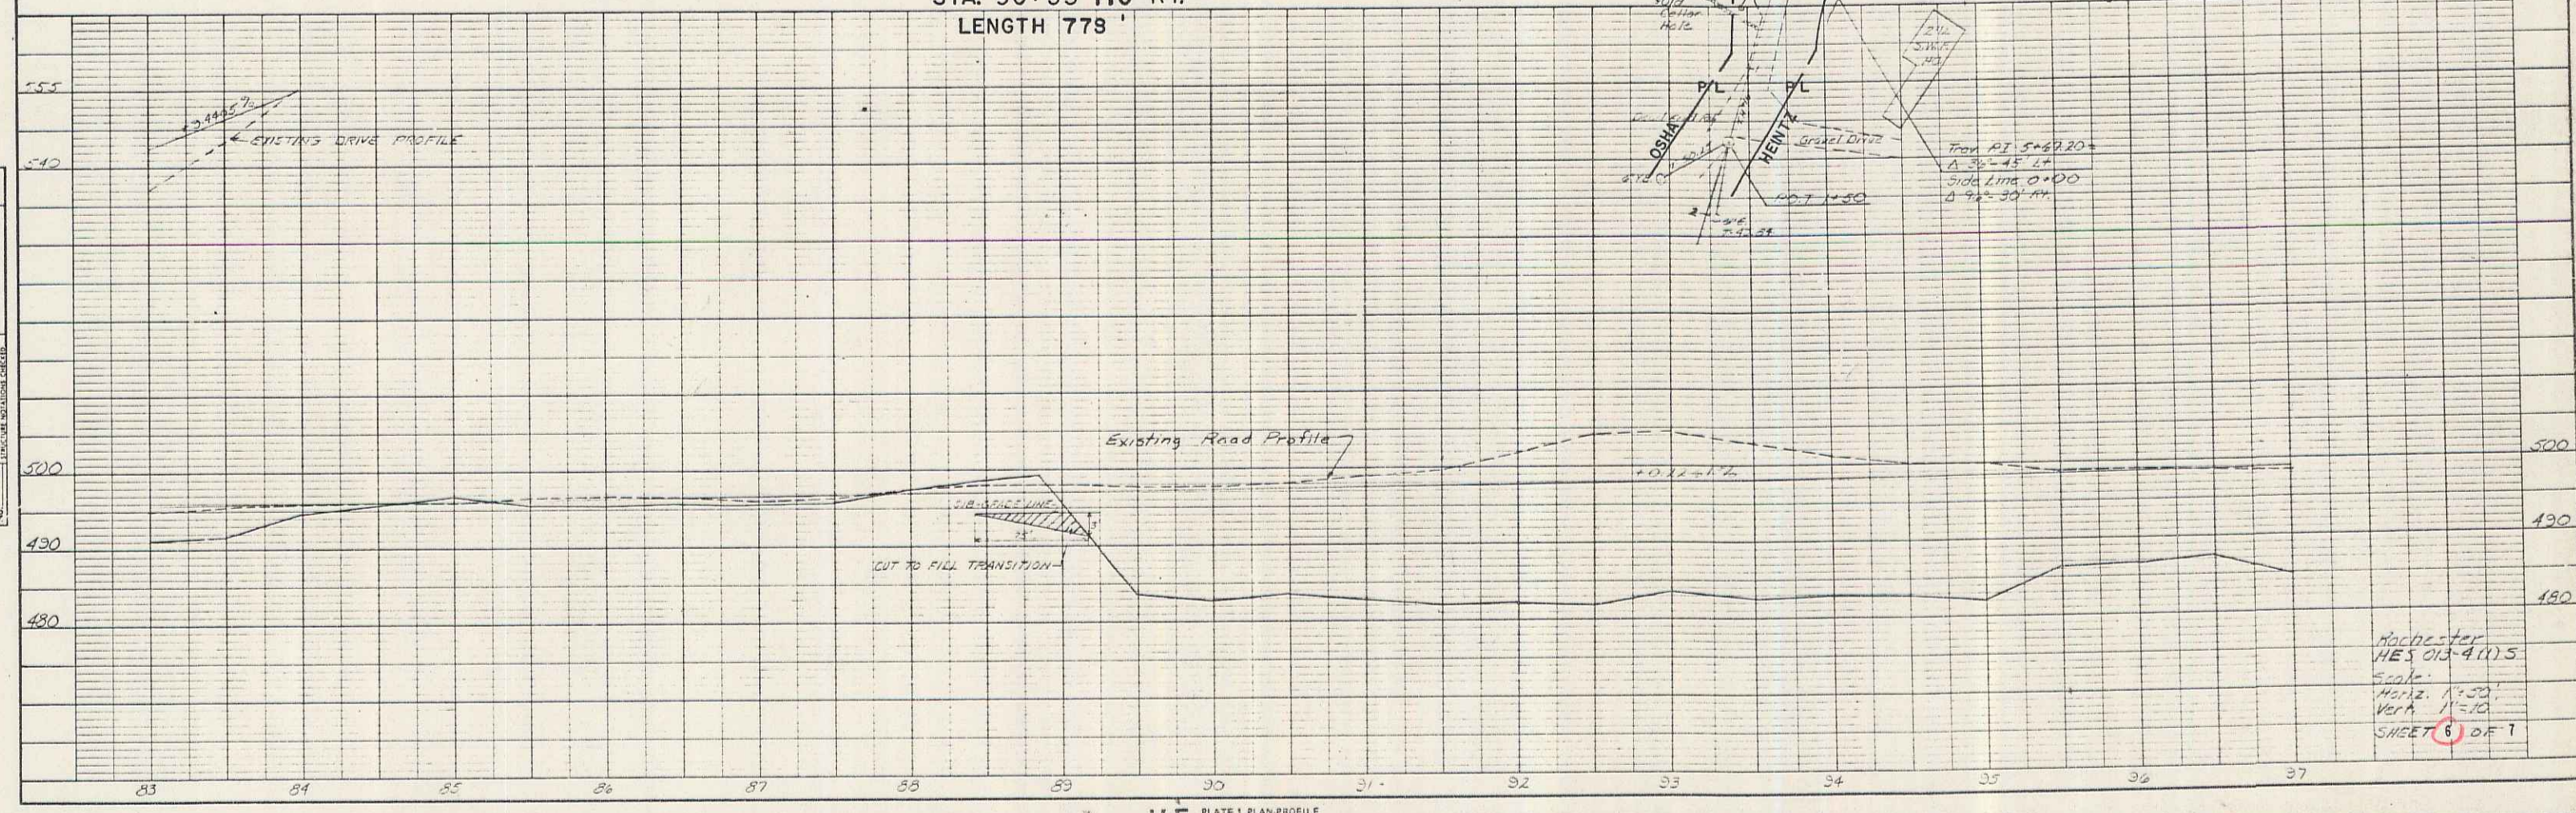


PLAN
 DATE: _____
 DRAWN BY: _____
 CHECKED BY: _____
 TITLE: _____

PROFILE
 DATE: _____
 DRAWN BY: _____
 CHECKED BY: _____
 TITLE: _____

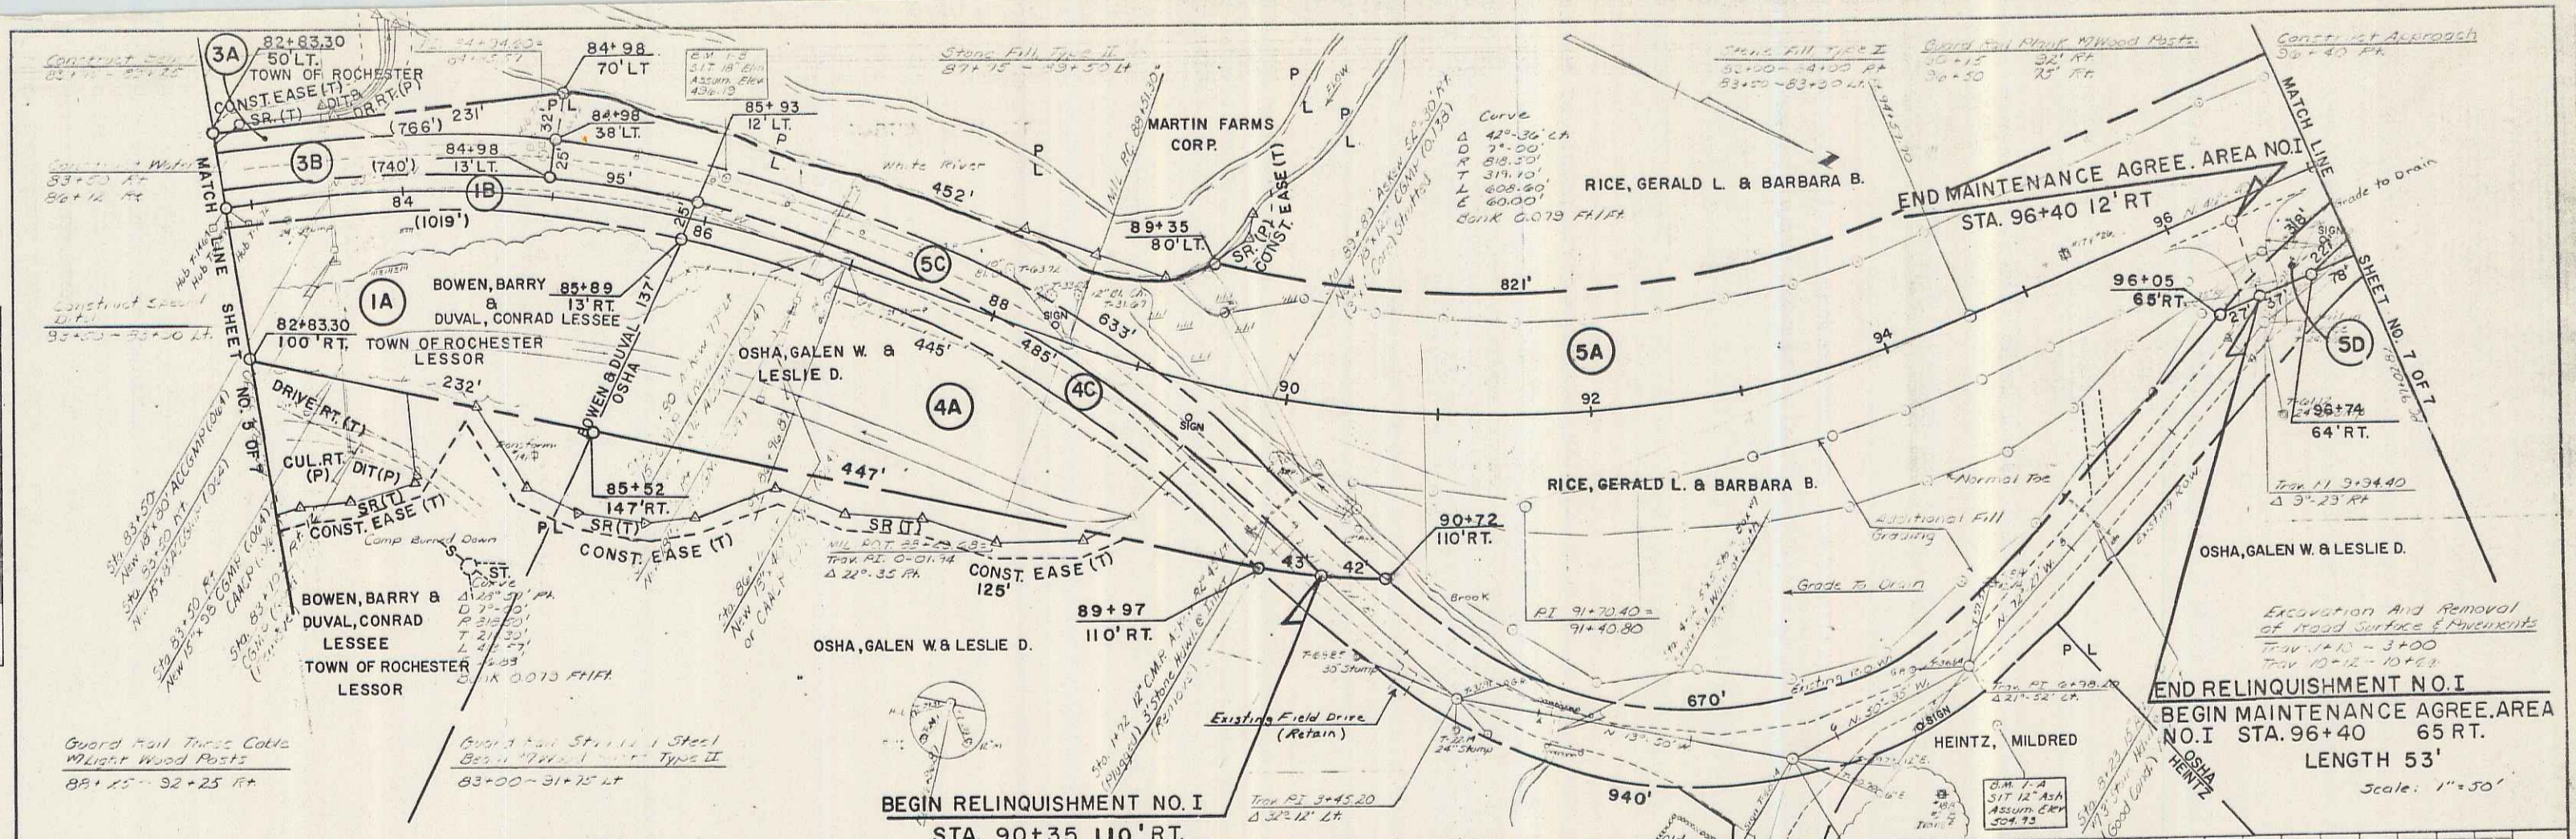

BEGIN RELINQUISHMENT NO. I
 STA. 90+35 110' RT.
 LENGTH 778'

END RELINQUISHMENT NO. I
 BEGIN MAINTENANCE AGREE. AREA NO. I
 STA. 96+40 65 RT.
 LENGTH 53'

Rochester
 HES 013-4(1) S
 Scale: 1"=50'
 Ver. A 11-10
 SHEET 6 OF 7