


POOR ORIGINAL COPY

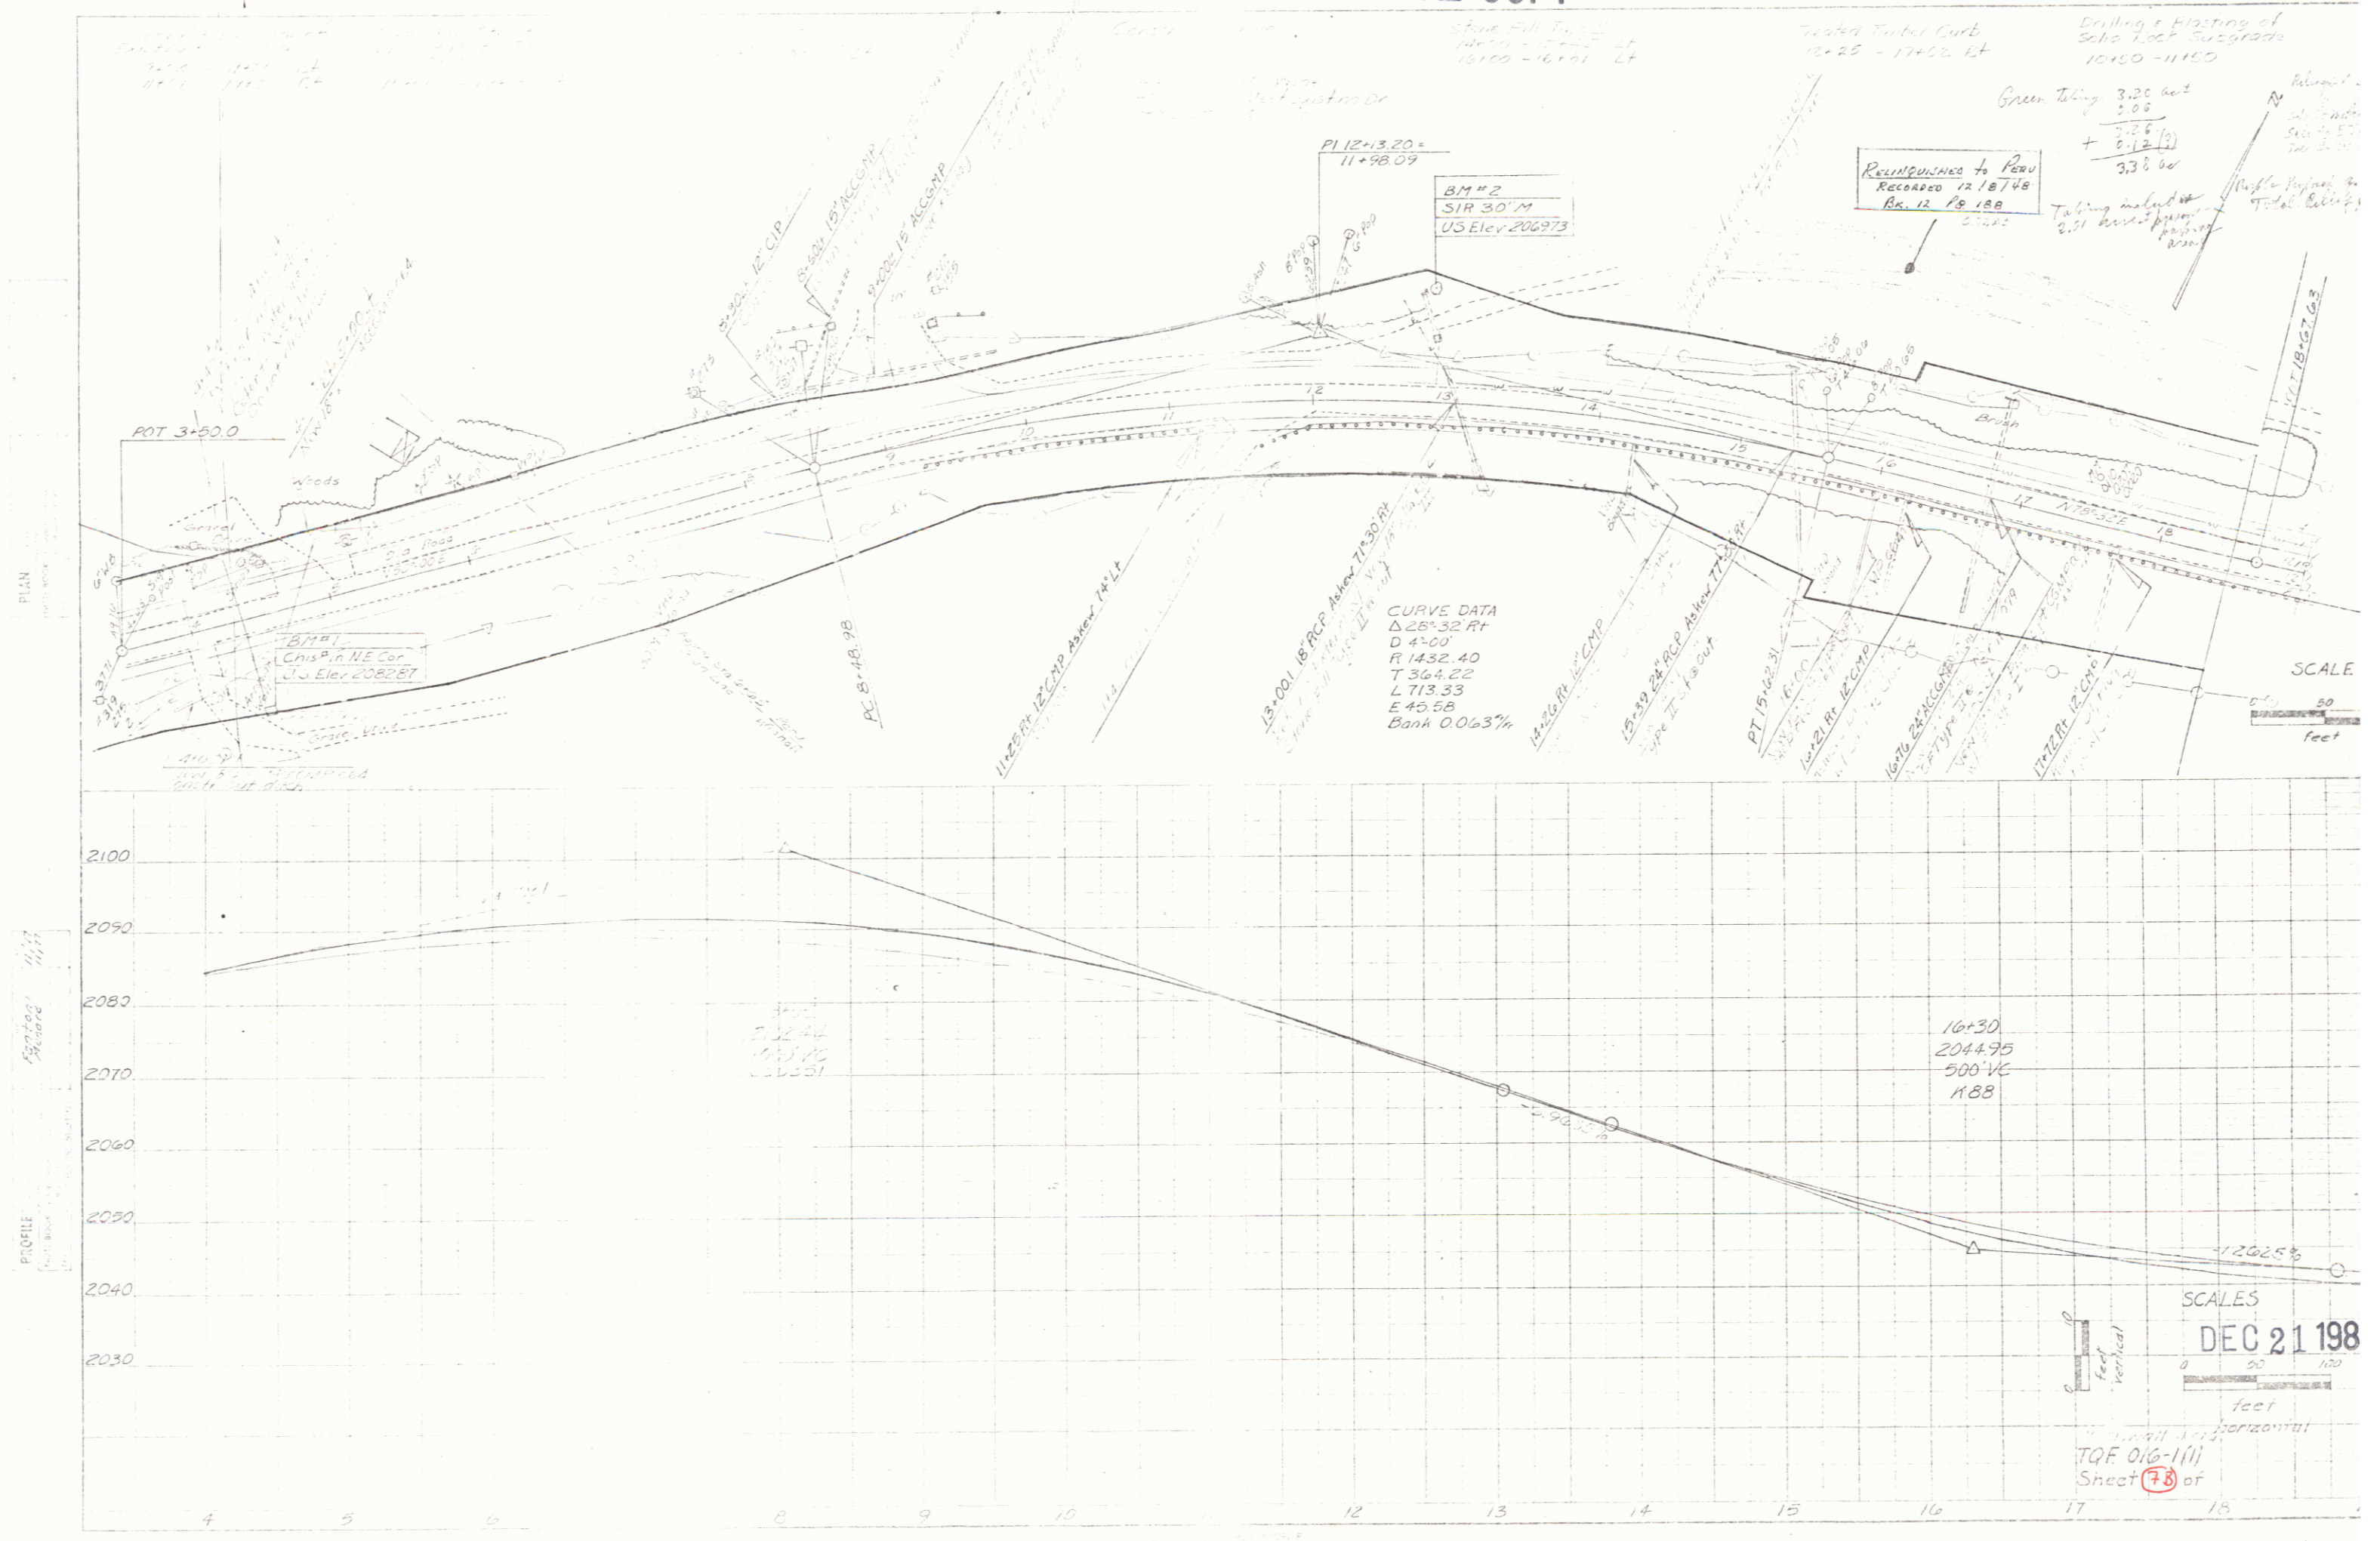

DEC 21 198

TQE 016-111
Sheet 7 of

10