


POOR ORIGINAL COPY

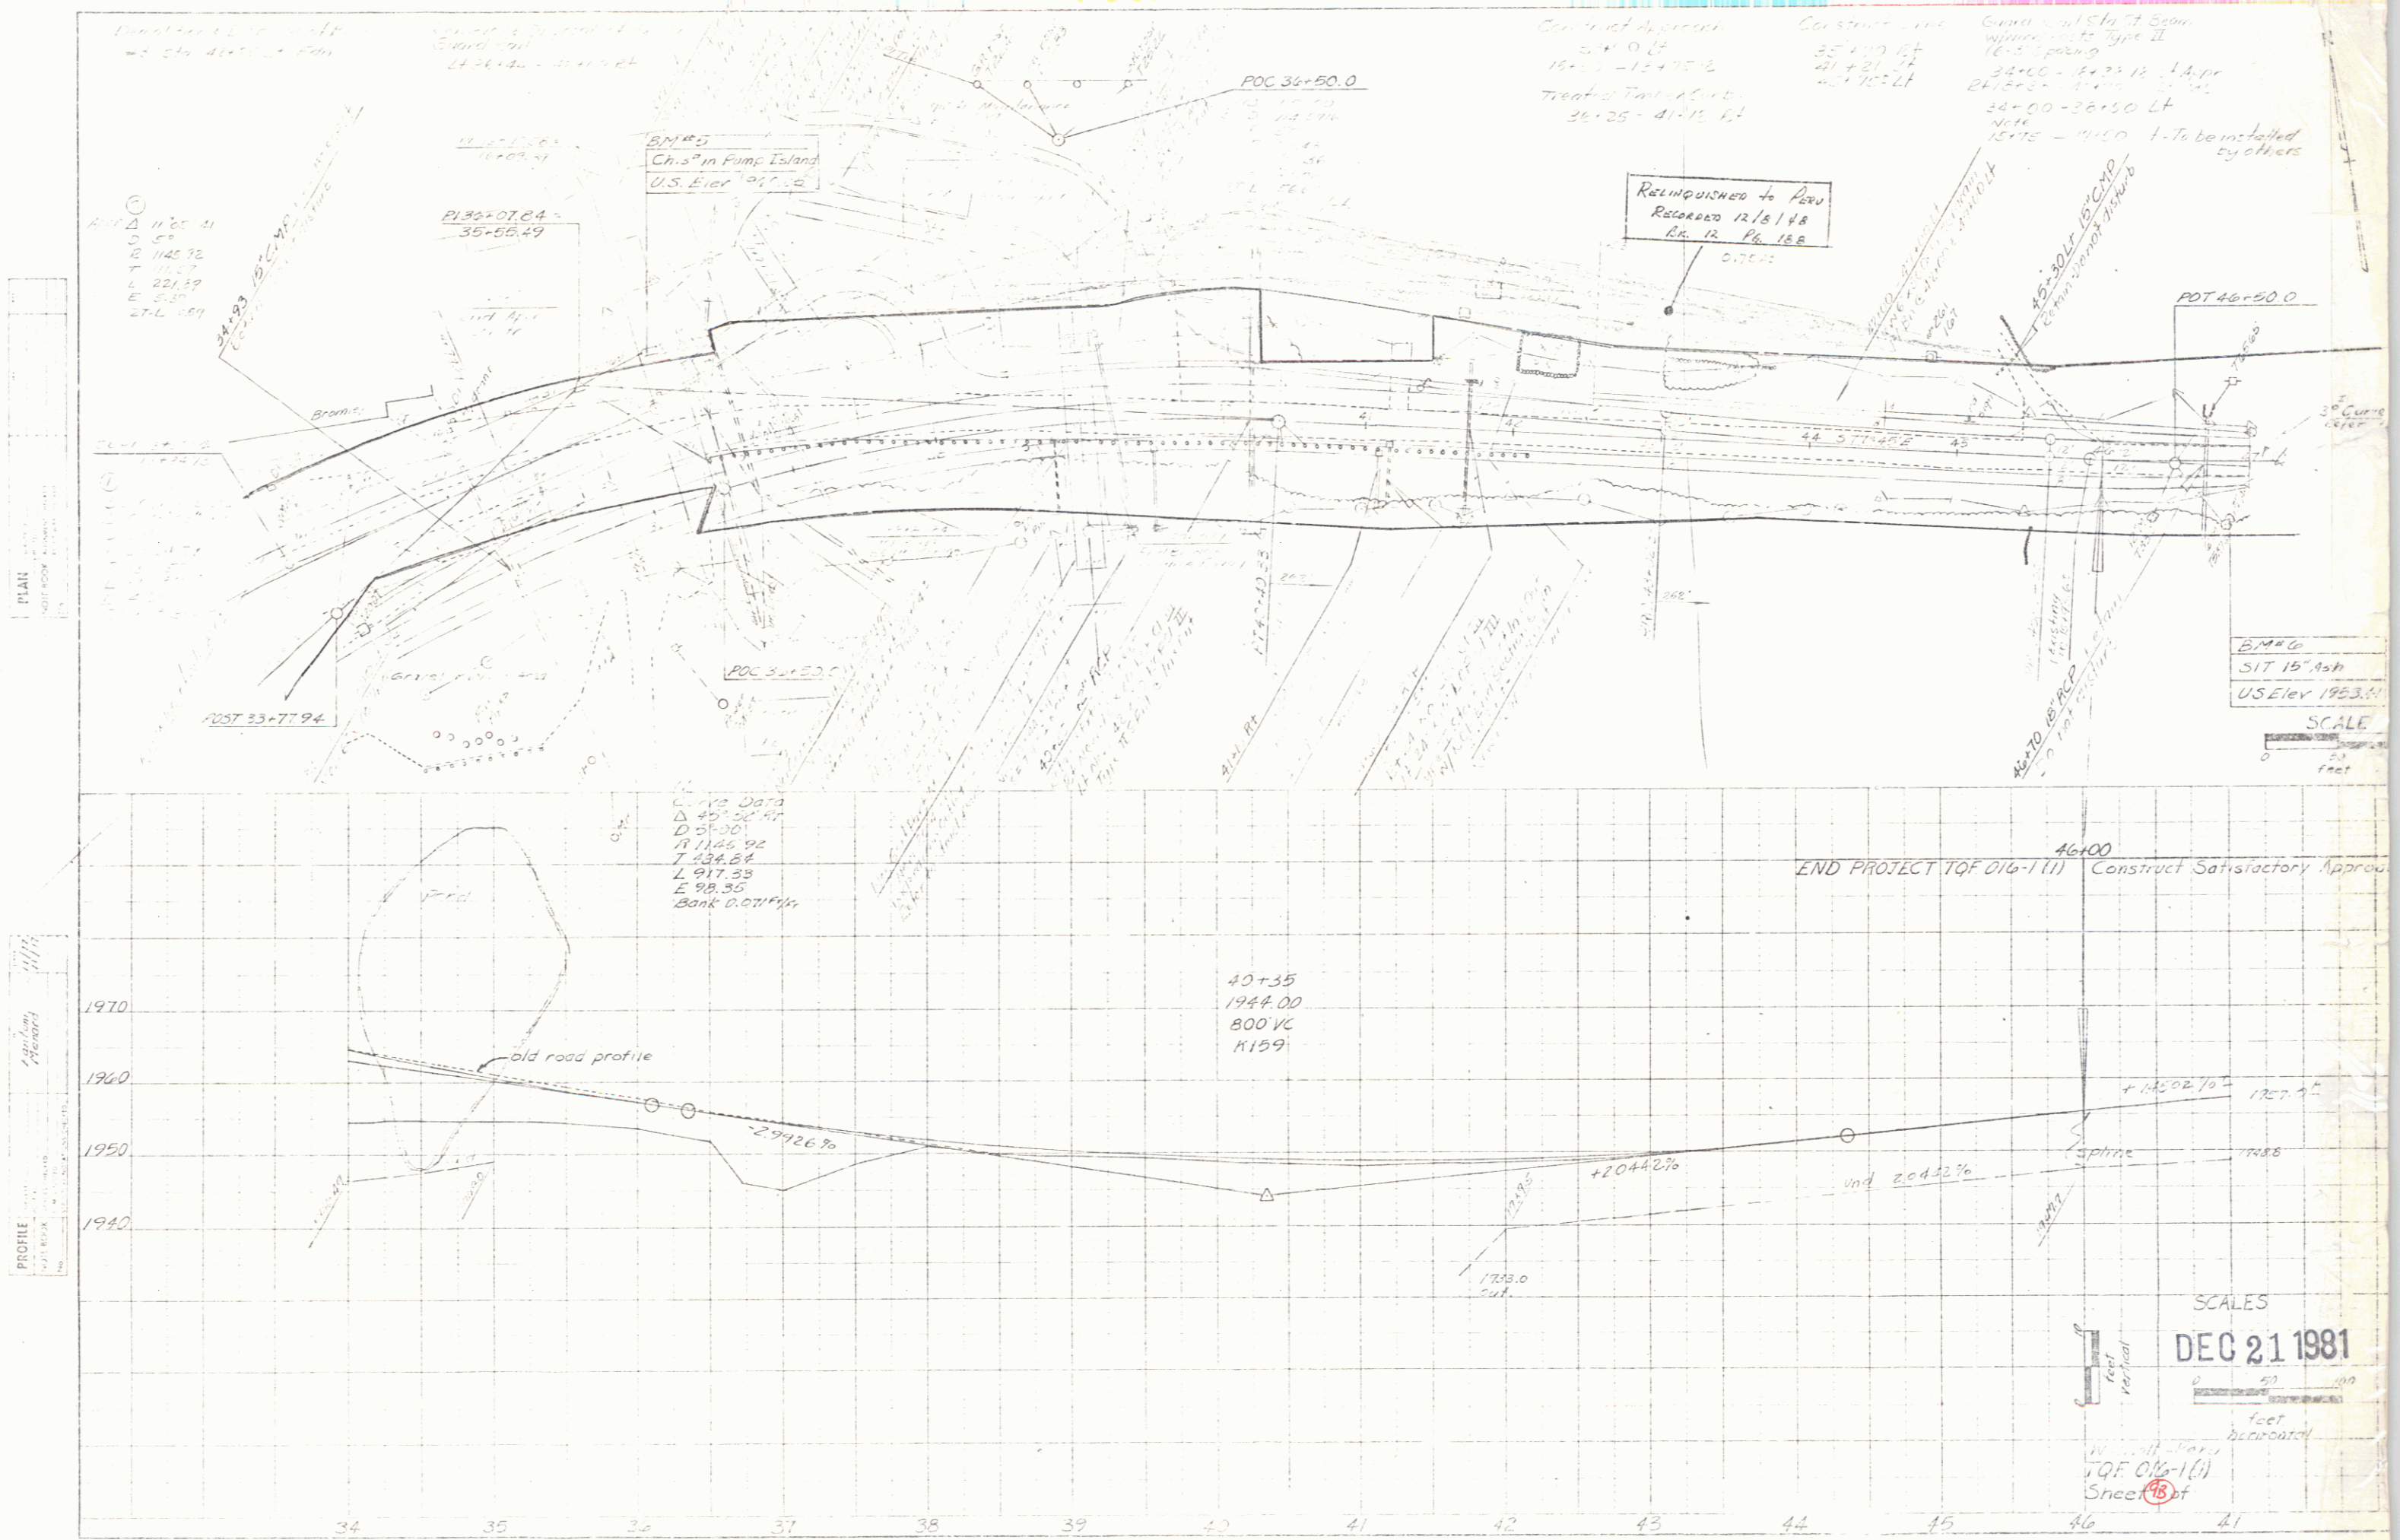

DEC 21 1981