



PLAN	INSTRUMENT	DATE
	NOTE BOOK	
	BY	
	SCALE	

PROFILE	INSTRUMENT	DATE
	NOTE BOOK	
	BY	
	SCALE	

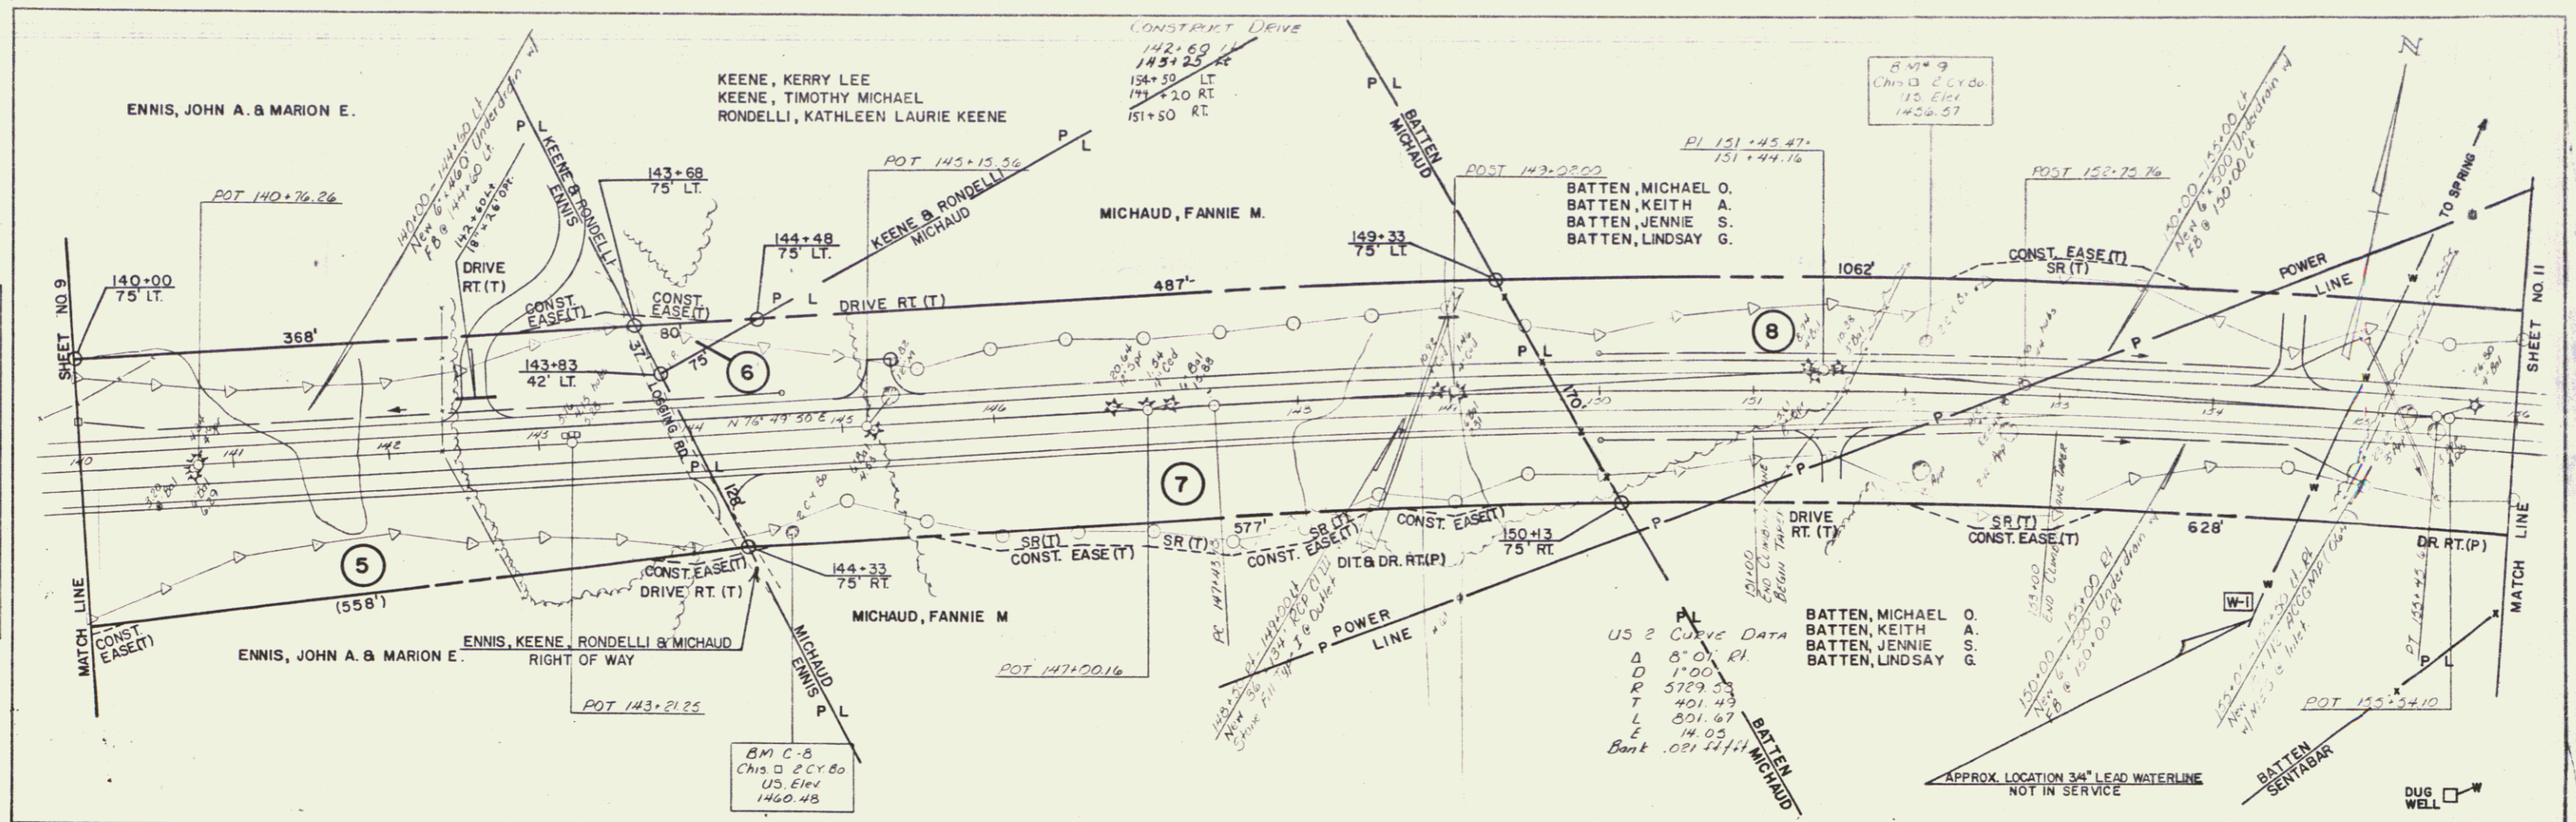

US 2 CURVE DATA
 Δ 8° 00' RI.
 D 1' 00"
 R 5729.53
 T 401.43
 L 501.67
 E 141.03
 Bank .0214411

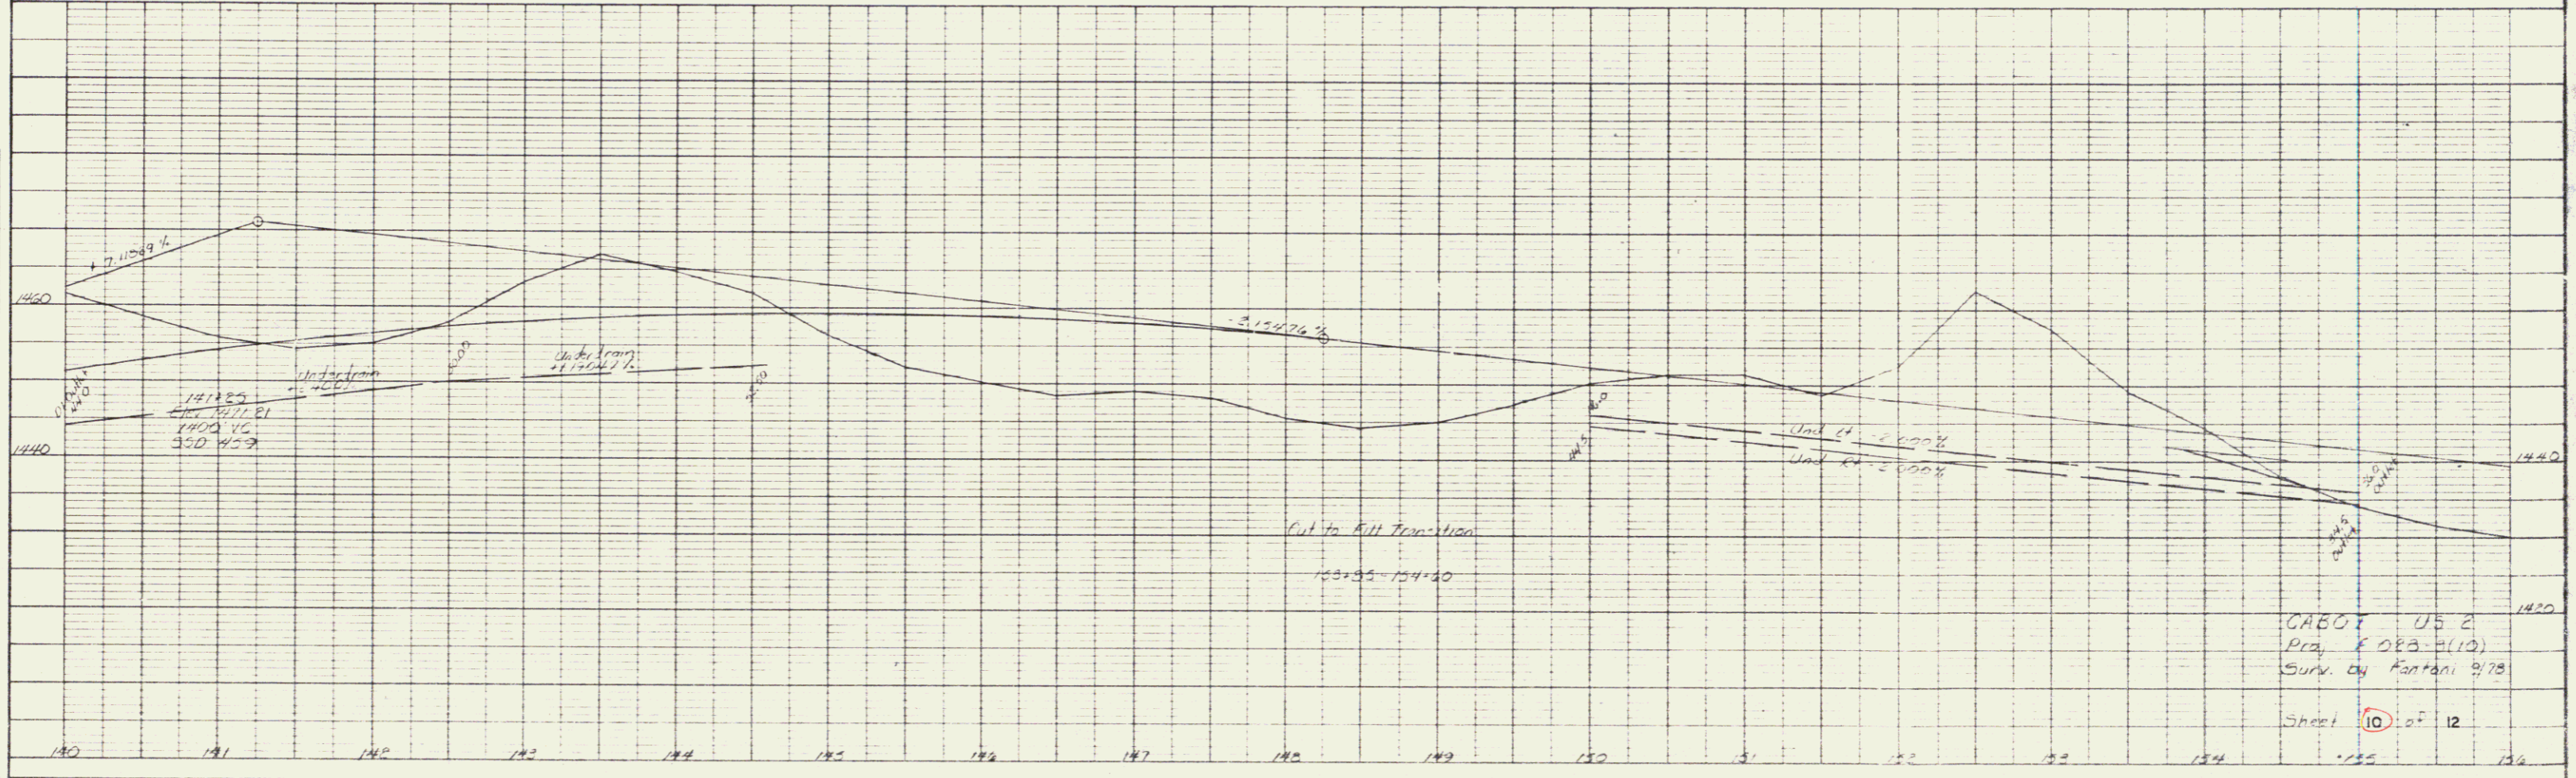

K-E PLATE 1, PLAN/PROFILE
 SCALE 1/4\"/>

CABOT US 2
 Proj. # 083-1(10)
 Surv. by Kanton 9/78
 Sheet 10 of 12