
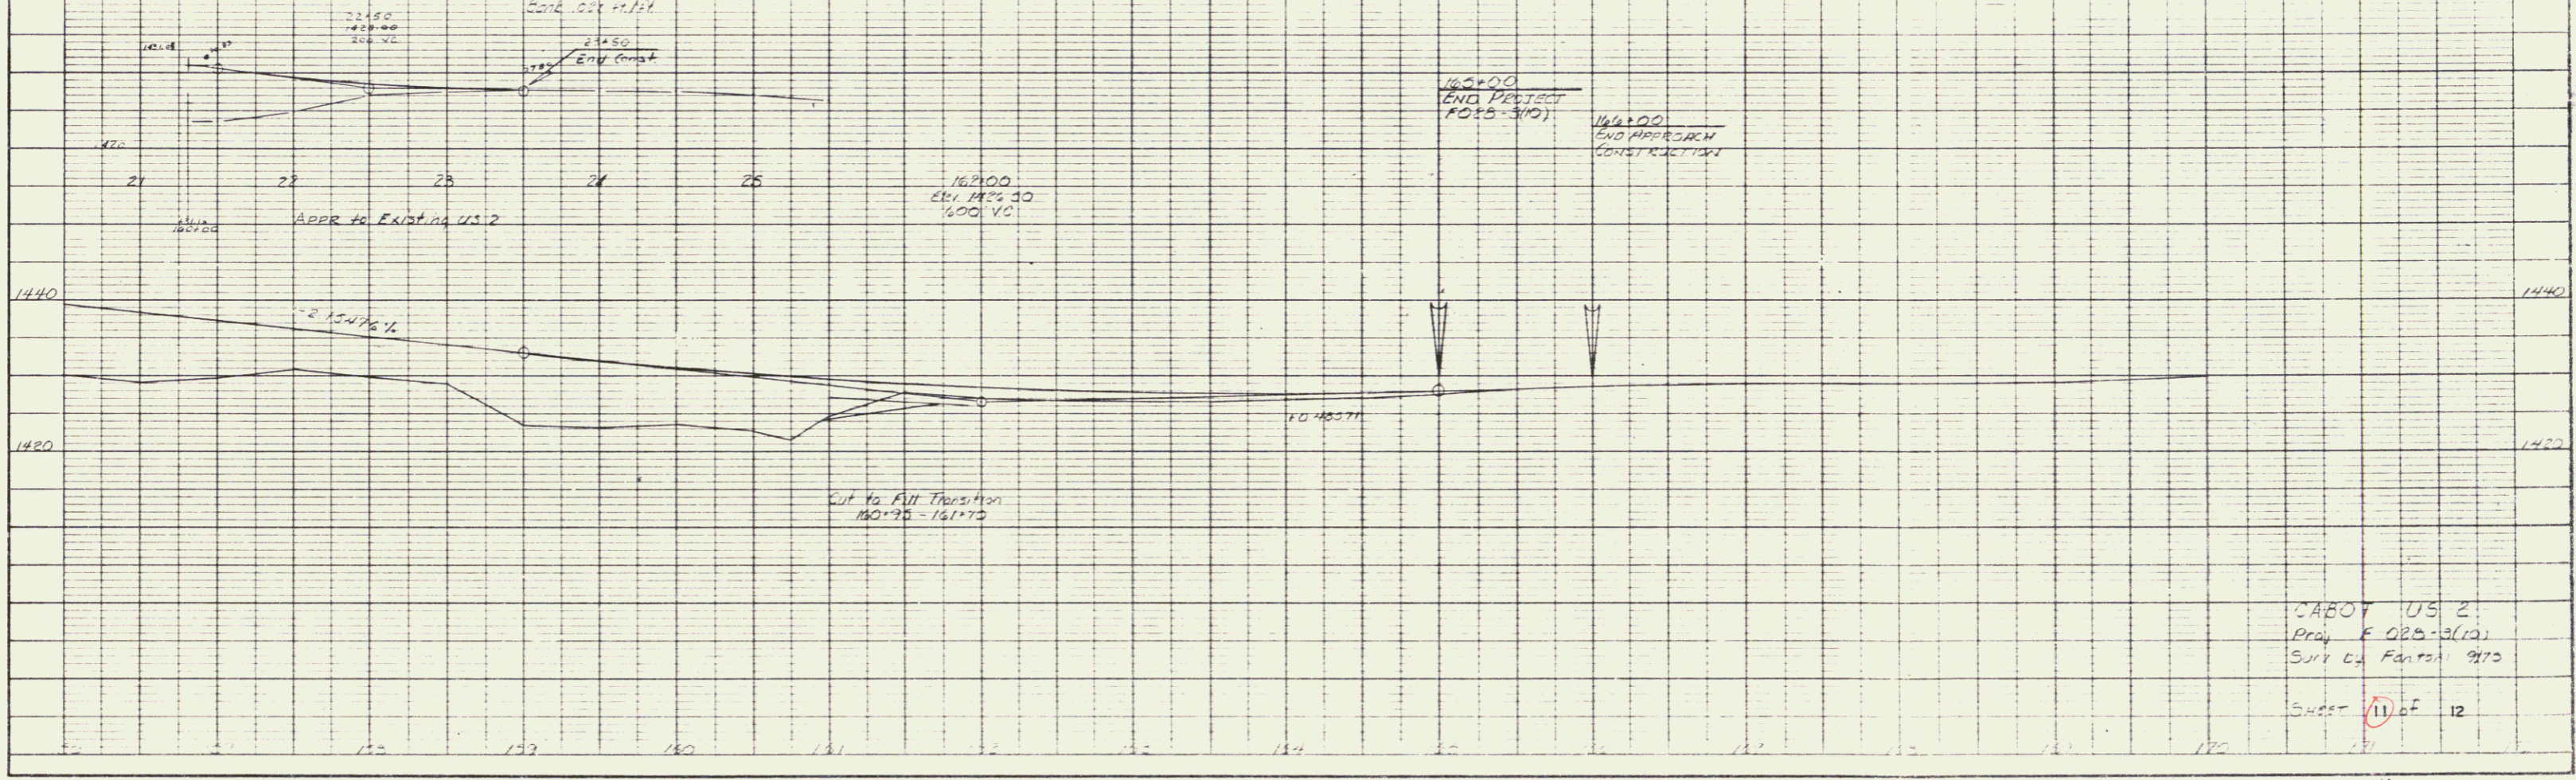


**PLAN**  
 SHEET NO. 11  
 DATE: 11/15/73  
 DRAWN BY: J. B. BATTEN  
 CHECKED BY: M. O. BATTEN  
 IN CHARGE: M. O. BATTEN  
 PROJECT: F 028-3(10) STA. 166+00

**PROFILE**  
 SHEET NO. 11  
 DATE: 11/15/73  
 DRAWN BY: J. B. BATTEN  
 CHECKED BY: M. O. BATTEN  
 IN CHARGE: M. O. BATTEN  
 PROJECT: F 028-3(10) STA. 166+00

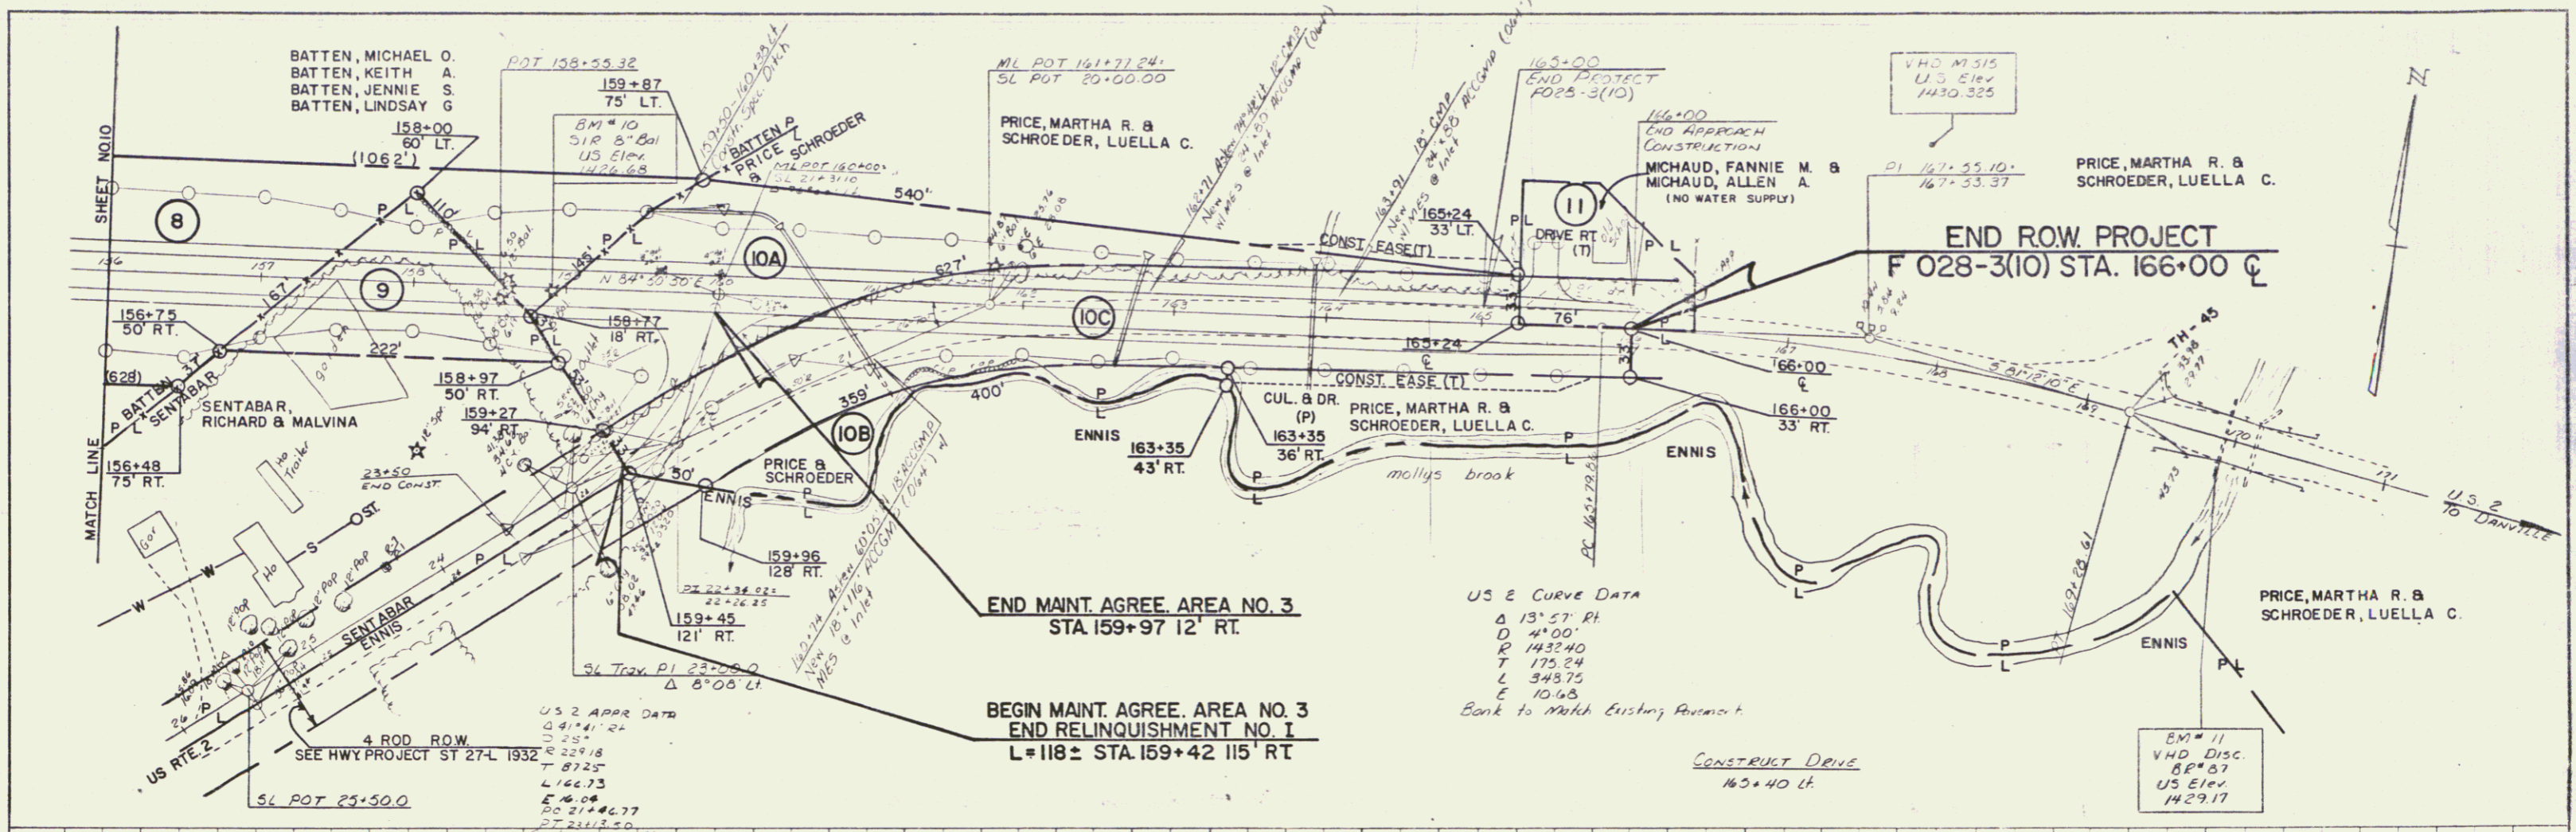

CADOT US 2  
 Proj. F 028-3(10)  
 SUR. CD. PARTIAL 973  
 SHEET 11 OF 12