


FILED
NOTES

FILED
NOTES

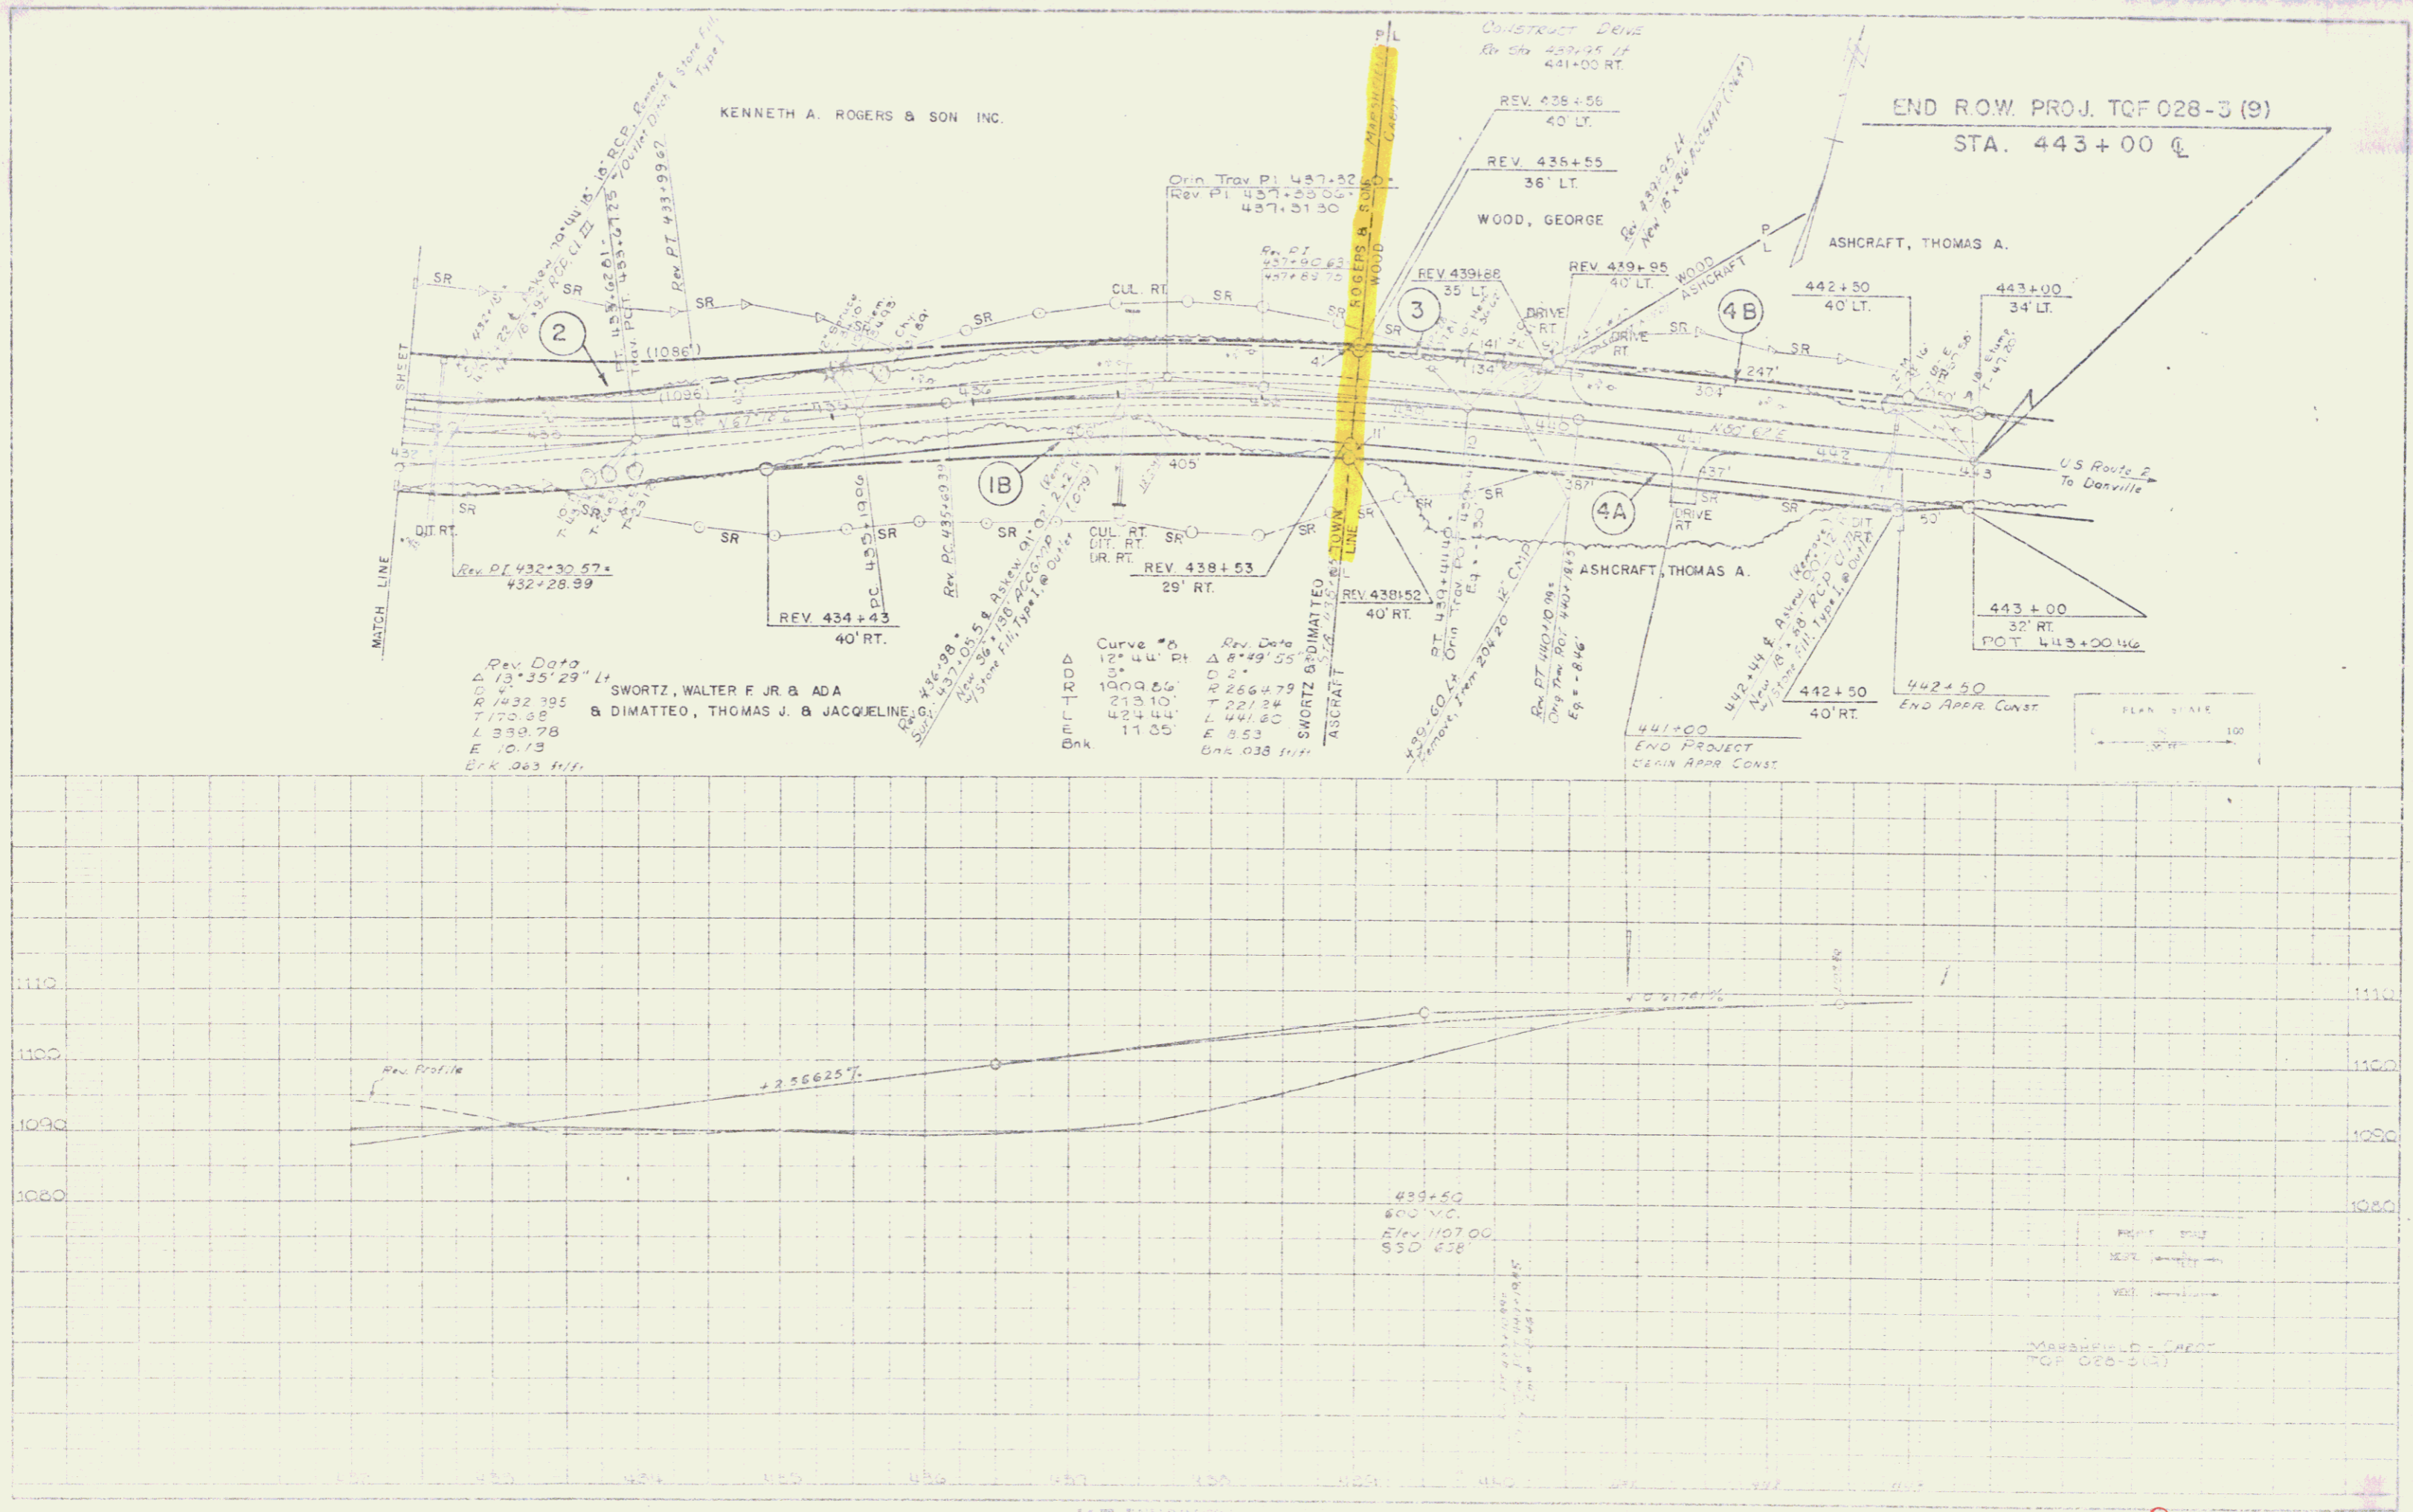

Rev. Data
 Δ 13° 35' 29" Lt
 D 1432.395
 T 170.88
 L 359.78
 E 10.73
 B.K. 363 H/F

SWORTZ, WALTER F. JR. & ADA
 & DIMATTEO, THOMAS J. & JACQUELINE

Curve #	Rev. Data
12° 44' 18"	Δ 8° 49' 55"
100.0	D 3.0
213.10	T 2664.79
424.44	L 221.24
11.05	E 853.0
	B.K. 038 H/F



PRINT THIS
 NOTE
 VERT. CURVE
 MARSHFIELD - CHECK
 TOP 028-5(3)