


PLAN
 DATE: _____
 DRAWN BY: _____
 CHECKED BY: _____
 IN CHARGE: _____
 PROJECT: _____
 SHEET NO. 12A OF _____


PROFILE
 DATE: _____
 DRAWN BY: _____
 CHECKED BY: _____
 IN CHARGE: _____
 PROJECT: _____
 SHEET NO. 12A OF _____

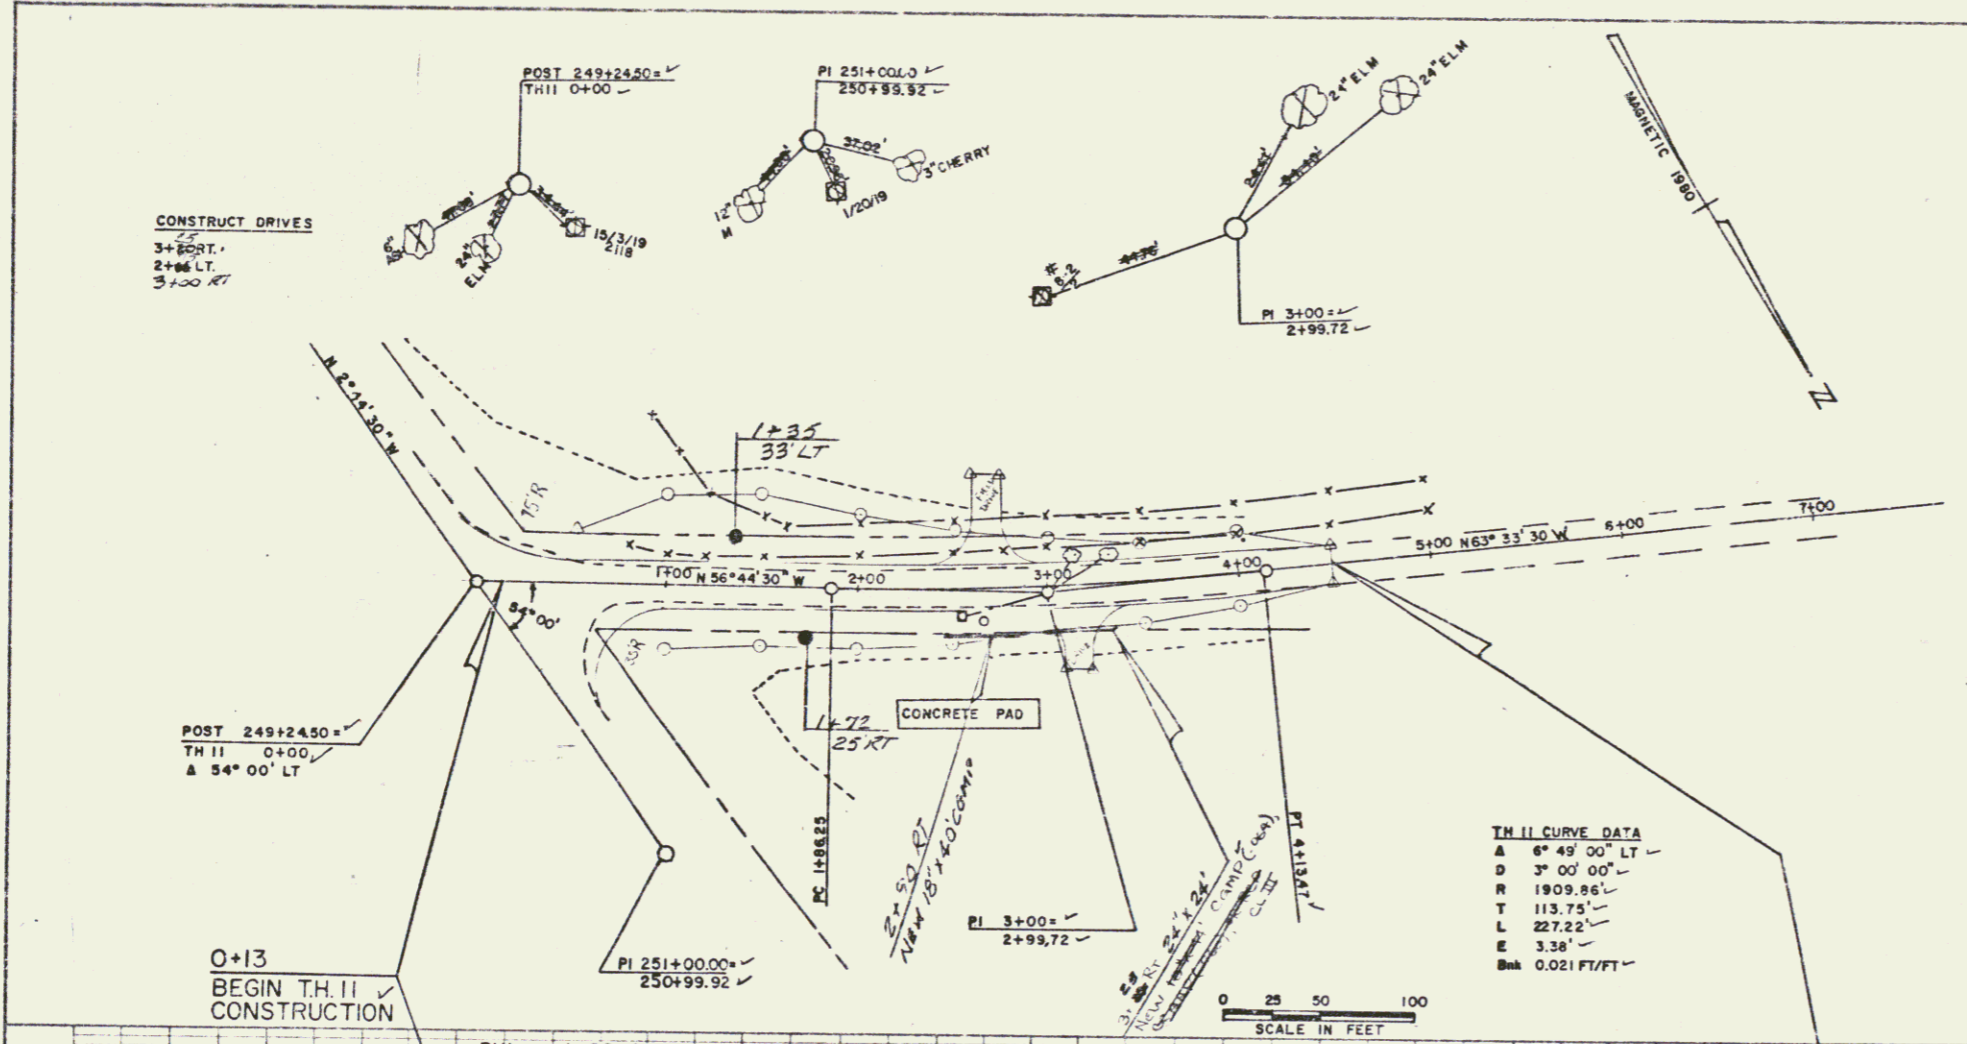


TH II CURVE DATA
 A = 6° 49' 00" LT
 D = 3' 00' 00"
 R = 1909.86'
 T = 113.75'
 L = 227.22'
 E = 3.38'
 Bk = 0.021 FT/FT

P.V.I. = 1+00
 ELEV. = 420.55
 L = 150
 S.S.D. = 170

P.V.I. = 3+75
 ELEV. = 395.80
 L = 150
 K = 25

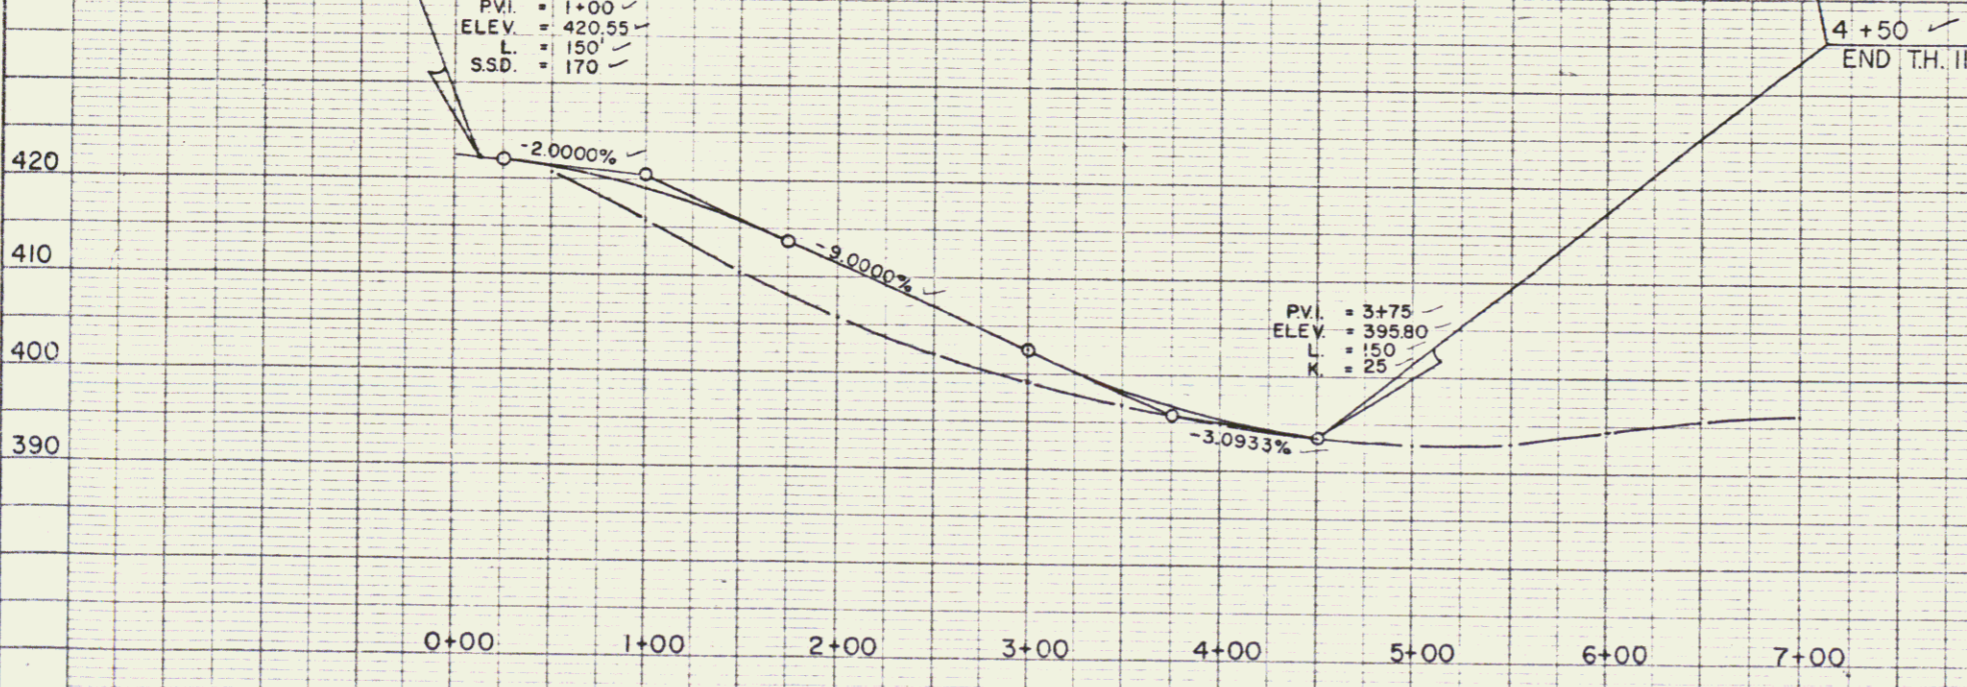

SCALE
 VERTICAL 1" = 10'
 HORIZONTAL 1" = 50'

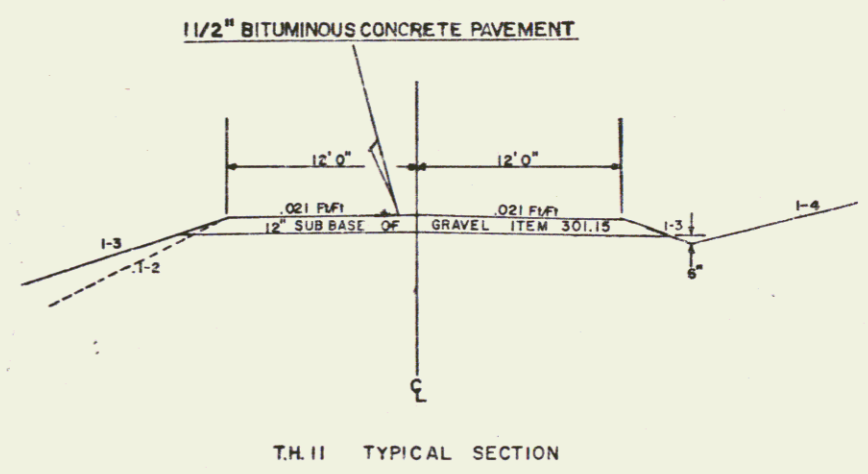

JUN 14 1985

BRANDON
 HES-TGF 019-3(15)
 11-80
 SHEET 12A OF _____