


Tree to be Saved
 Tree to be Removed
 Item 475.50 REMOVING SIGNS Sta. 231+20 RT.
 ITEM 570'S SETTING SALVAGED POSTS Sta. 231+20-24 RT.
 Construct Drive 225+60 RT
 227+35 LT


THE ROWLAND E. ROBINSON MEMORIAL ASSOCIATION, INC.

PLAN
 SHEET NO.
 DATE
 DRAWN BY
 CHECKED BY
 IN CHARGE ENGINEER
 NO.

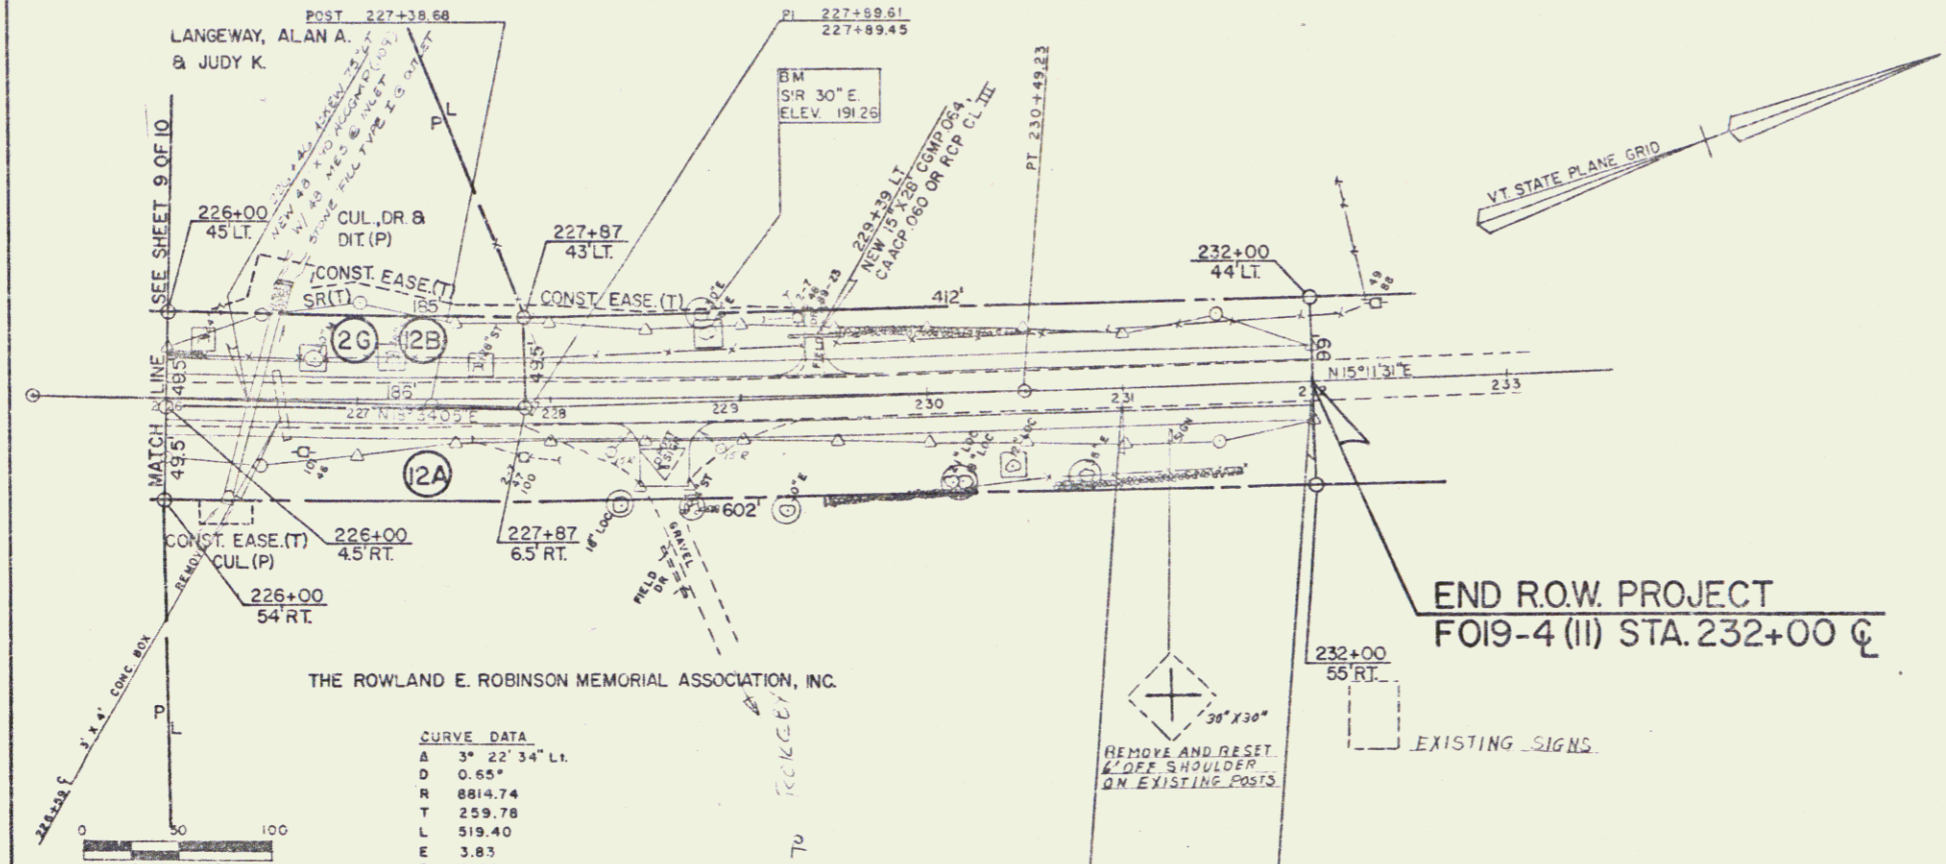

CURVE DATA

A	3° 22' 34" L.I.
D	0.65'
R	8814.74'
T	259.78'
L	519.40'
E	3.83'
BNK	0.021 FWT

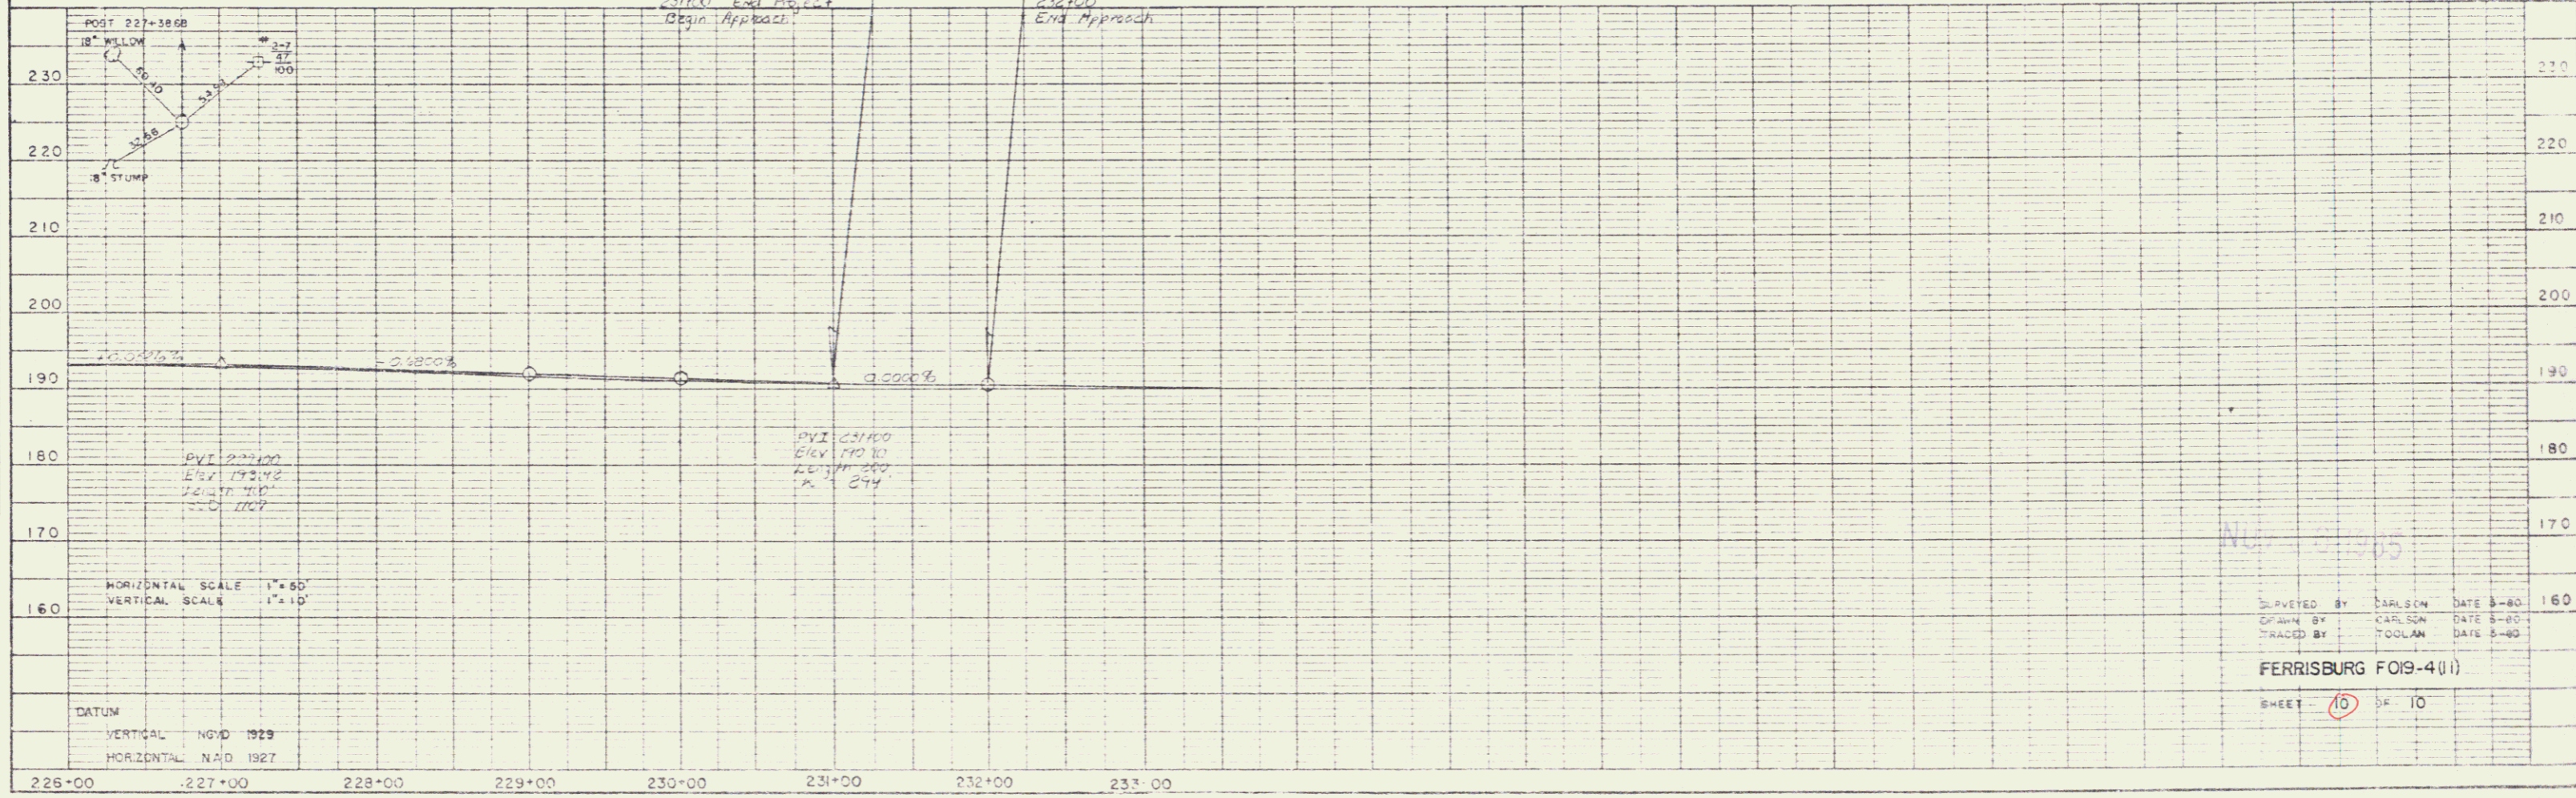

PROFILE
 SHEET NO.
 DATE
 DRAWN BY
 CHECKED BY
 IN CHARGE ENGINEER
 NO.

HORIZONTAL SCALE 1"=60'
 VERTICAL SCALE 1"=10'

DATUM
 VERTICAL NAD 1929
 HORIZONTAL NAD 1927

SUPERVISED BY CARLSON DATE 3-80
 DRAWN BY CARLSON DATE 3-80
 TRACED BY TOOLAN DATE 3-80
 FERRISBURG FOI9-4(II)
 SHEET 10 OF 10