
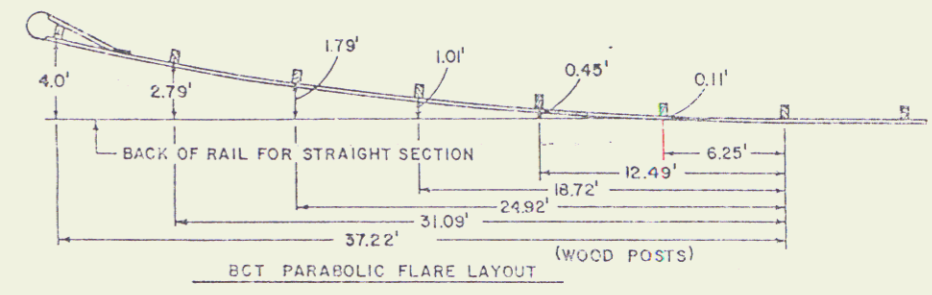


TEMPORARY 4" YELLOW LINE
295+00 - 297+00 E (CAHNT, SOL. RT)
297+00


TEMPORARY 4" WHITE LINE
RT
295+00 - 297+00
298+00 299+00
RELOCATE MAIL BOX
SINGLE SUPPORT
296+00 RT

CONSTRUCT DRIVE
295+32 RL


CURVE DATA
Δ = 10° - 25' Lt
D = 1° - 30'
R = 3819.72
T = 348.18
L = 634.44
E = 15.84
2T - L = 1.92

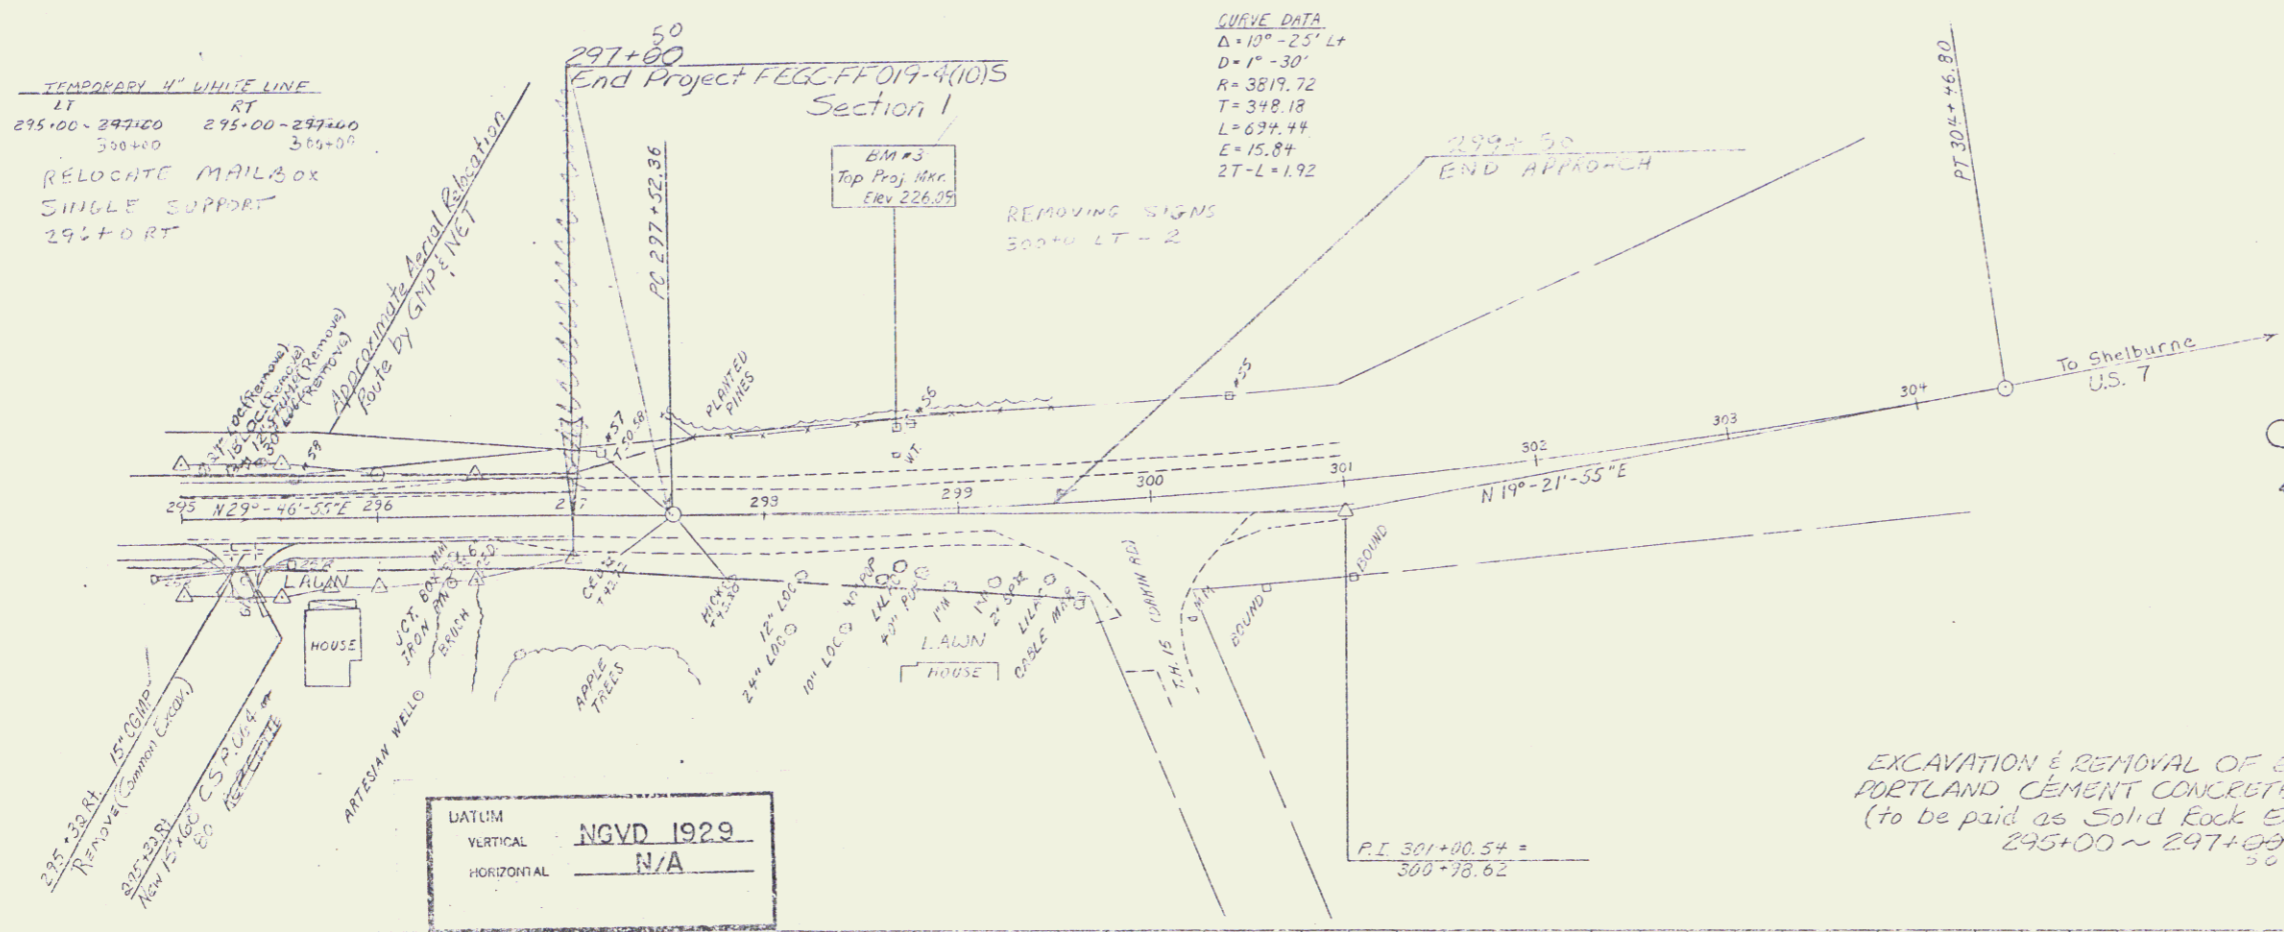

EXCAVATION & REMOVAL OF EXISTING
PORTLAND CEMENT CONCRETE PAVEMENT
(to be paid as Solid Rock Excavation)
295+00 ~ 297+00

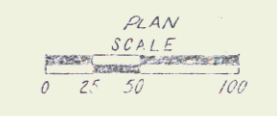

DATUM
VERTICAL NGVD 1929
HORIZONTAL N/A

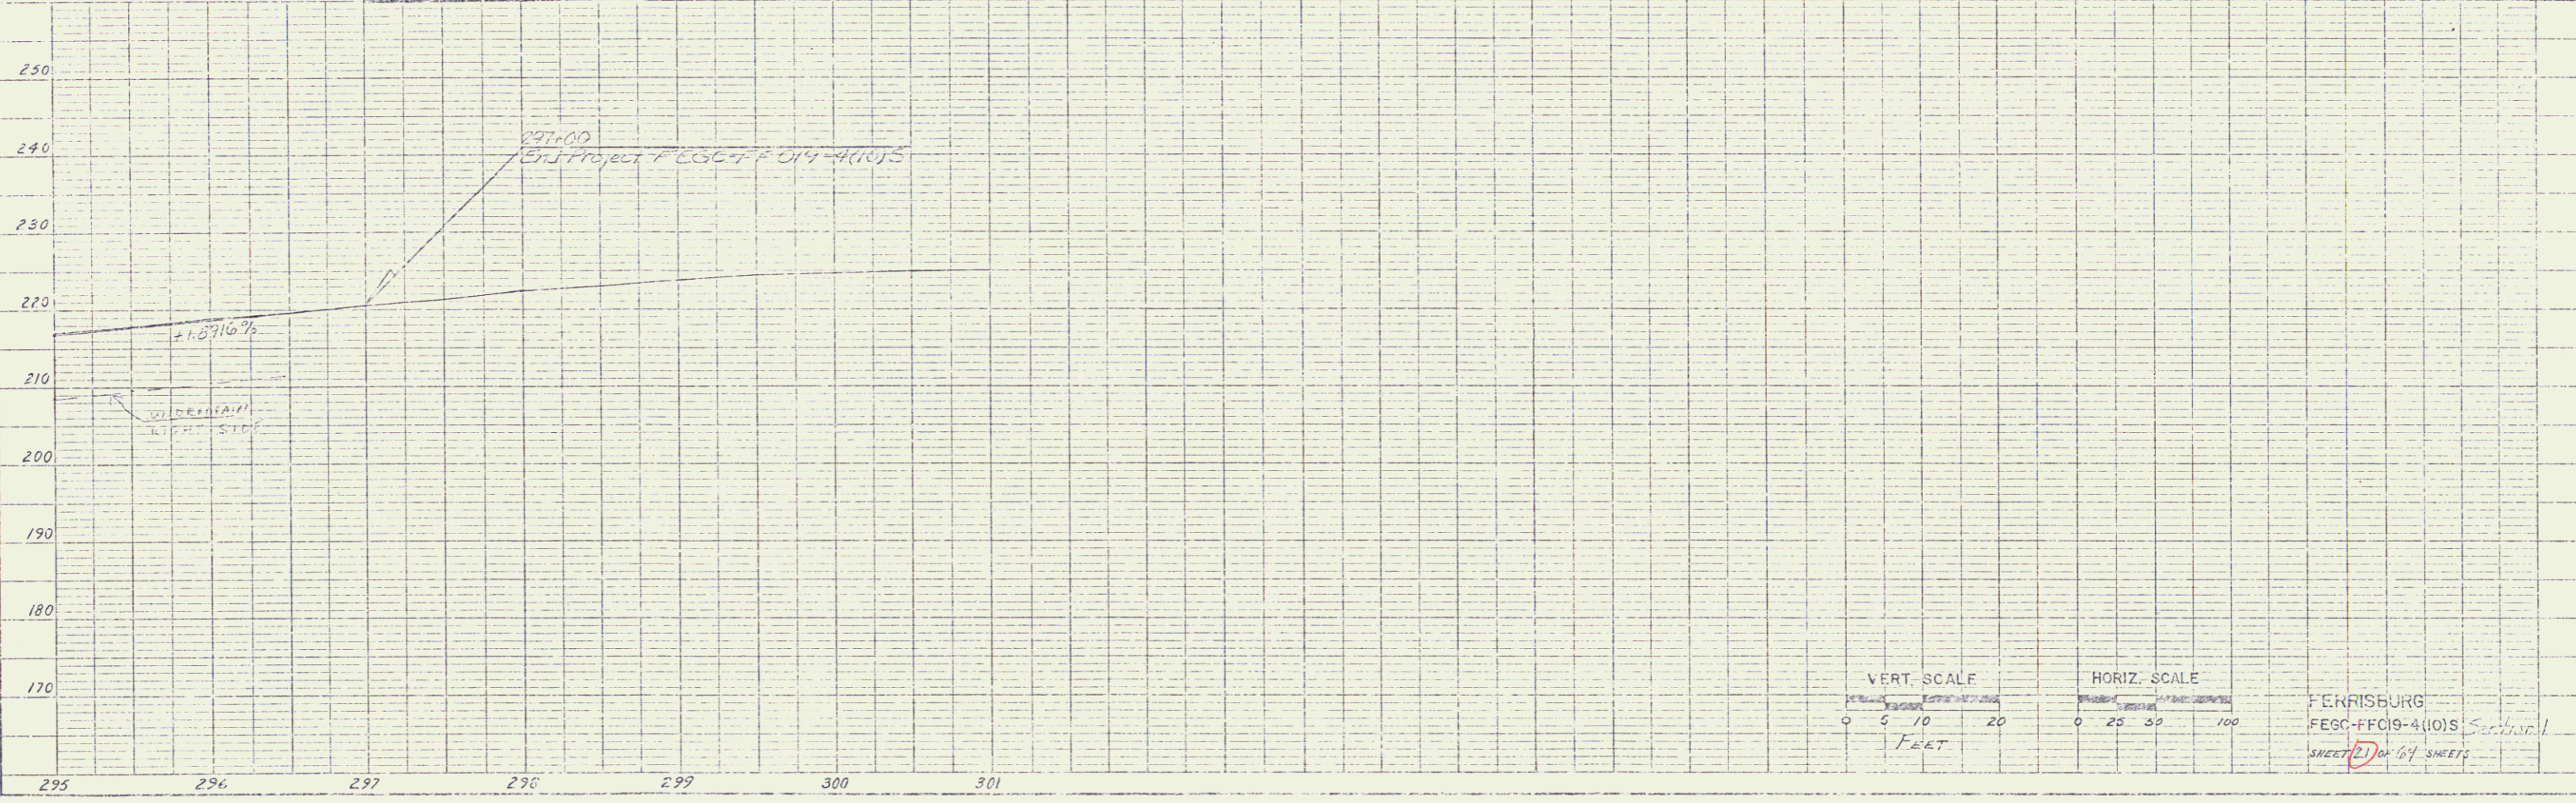

VERT. SCALE
0 5 10 20
FEET

HORIZ. SCALE
0 25 50 100
FEET

FERRISBURG
FECC-FFC-9-4(10)S Section 1
SHEET 2 OF 64 SHEETS

JAN 8 1993

12