


PLAN	DATE
NO.	
BY	
CHECKED	
APPROVED	
NOTED	
REVISIONS	
NO.	
DATE	
BY	
DESCRIPTION	

PROFILE	DATE
NO.	
BY	
CHECKED	
APPROVED	
NOTED	
REVISIONS	
NO.	
DATE	
BY	
DESCRIPTION	

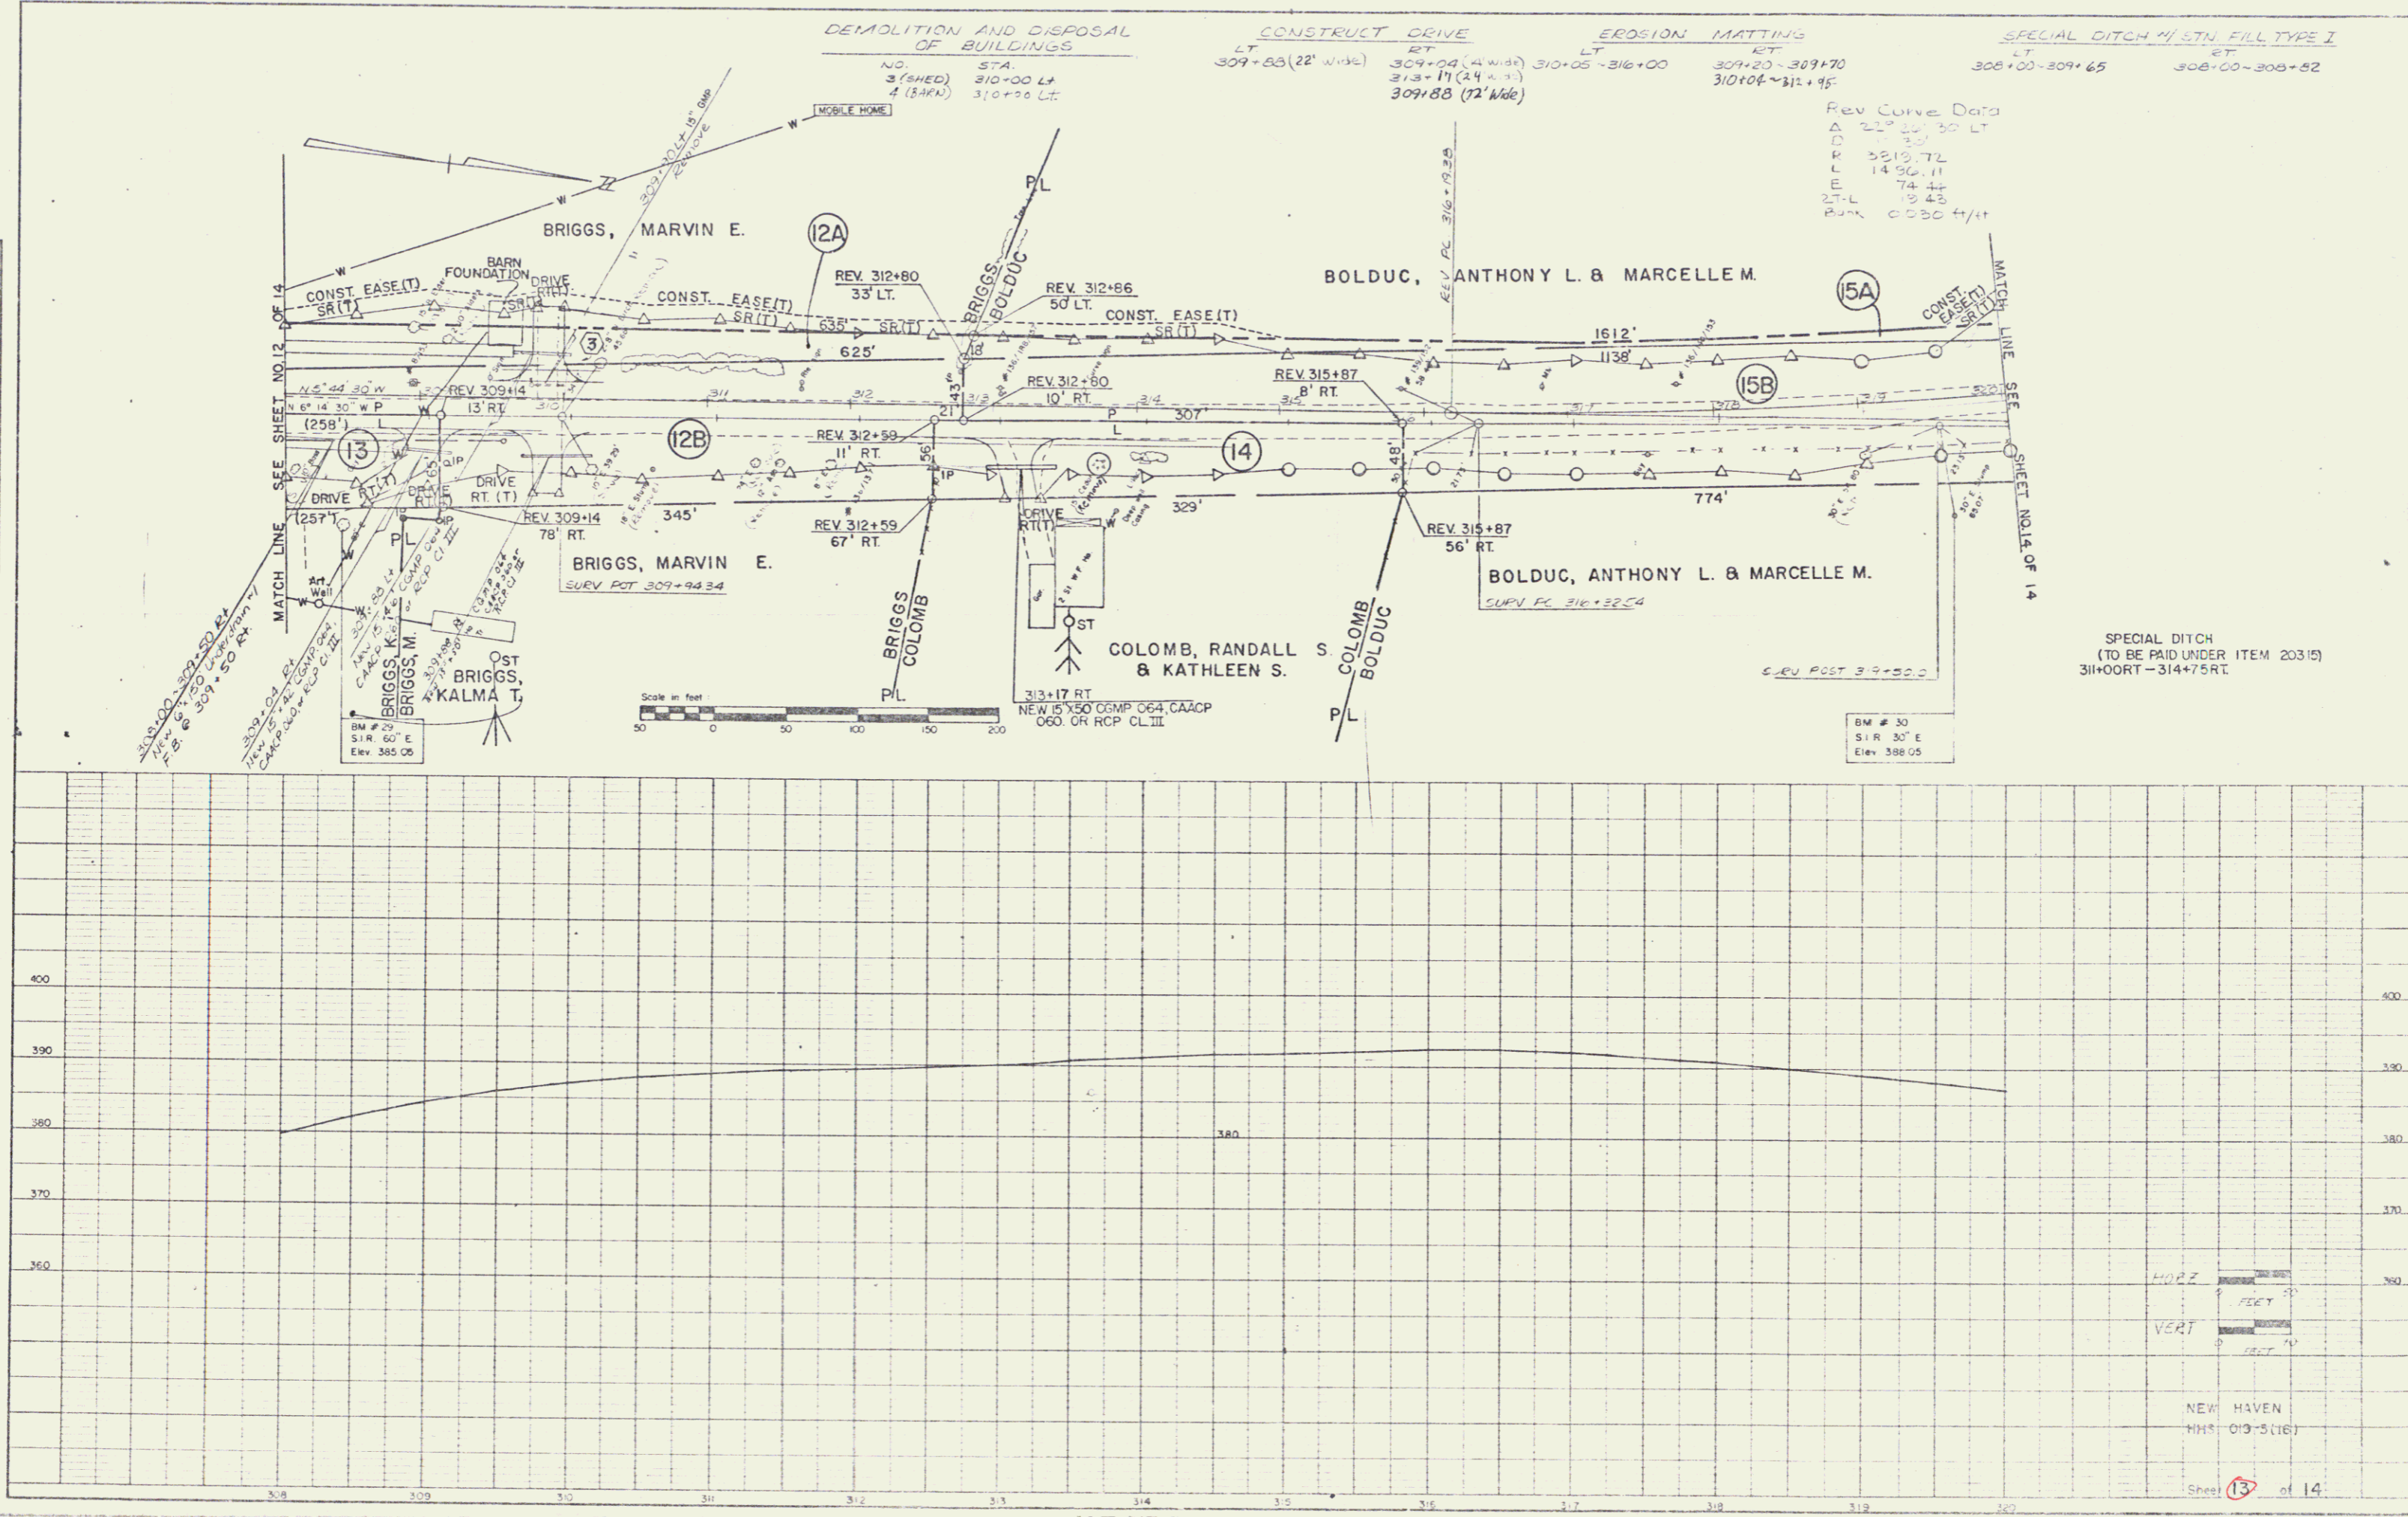

10