
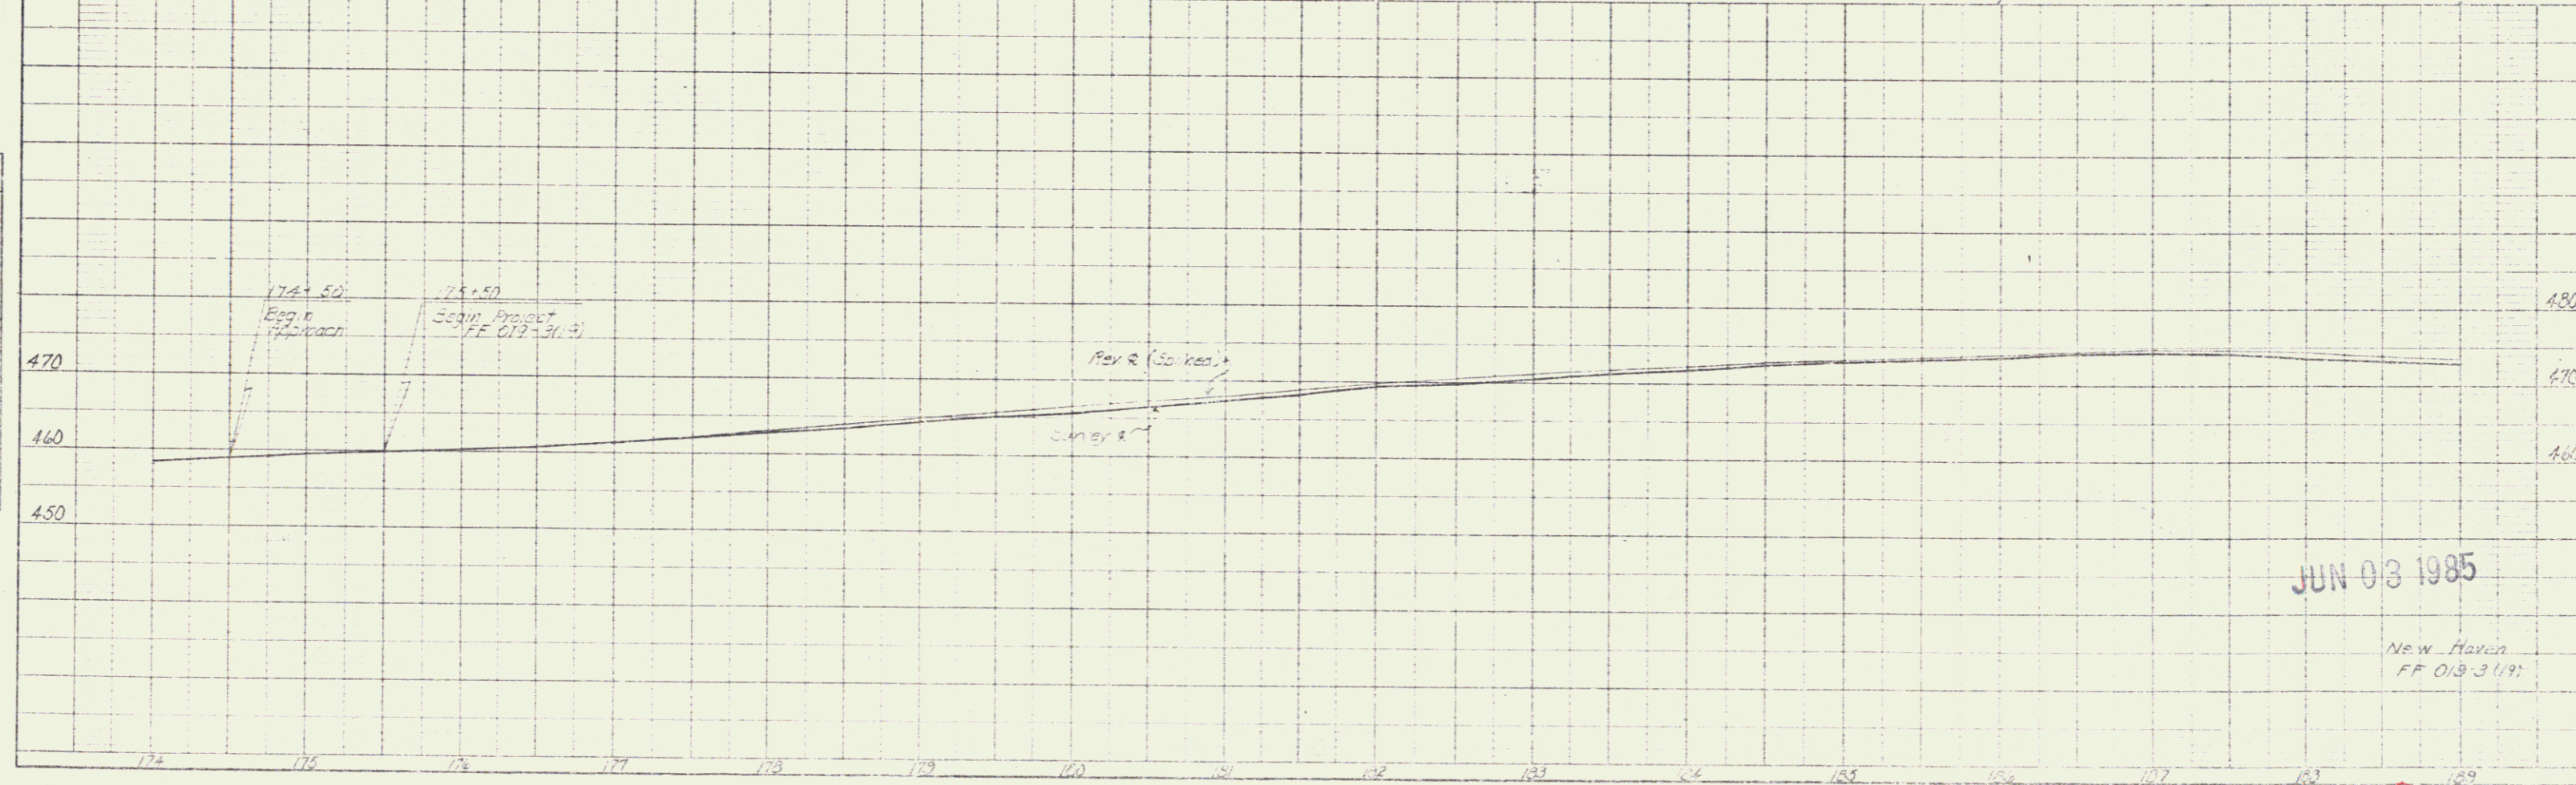


PLAN
 SHEET NO. 11 OF 18
 DATE: 11/15/85

PROFILE
 SHEET NO. 11 OF 18
 DATE: 11/15/85

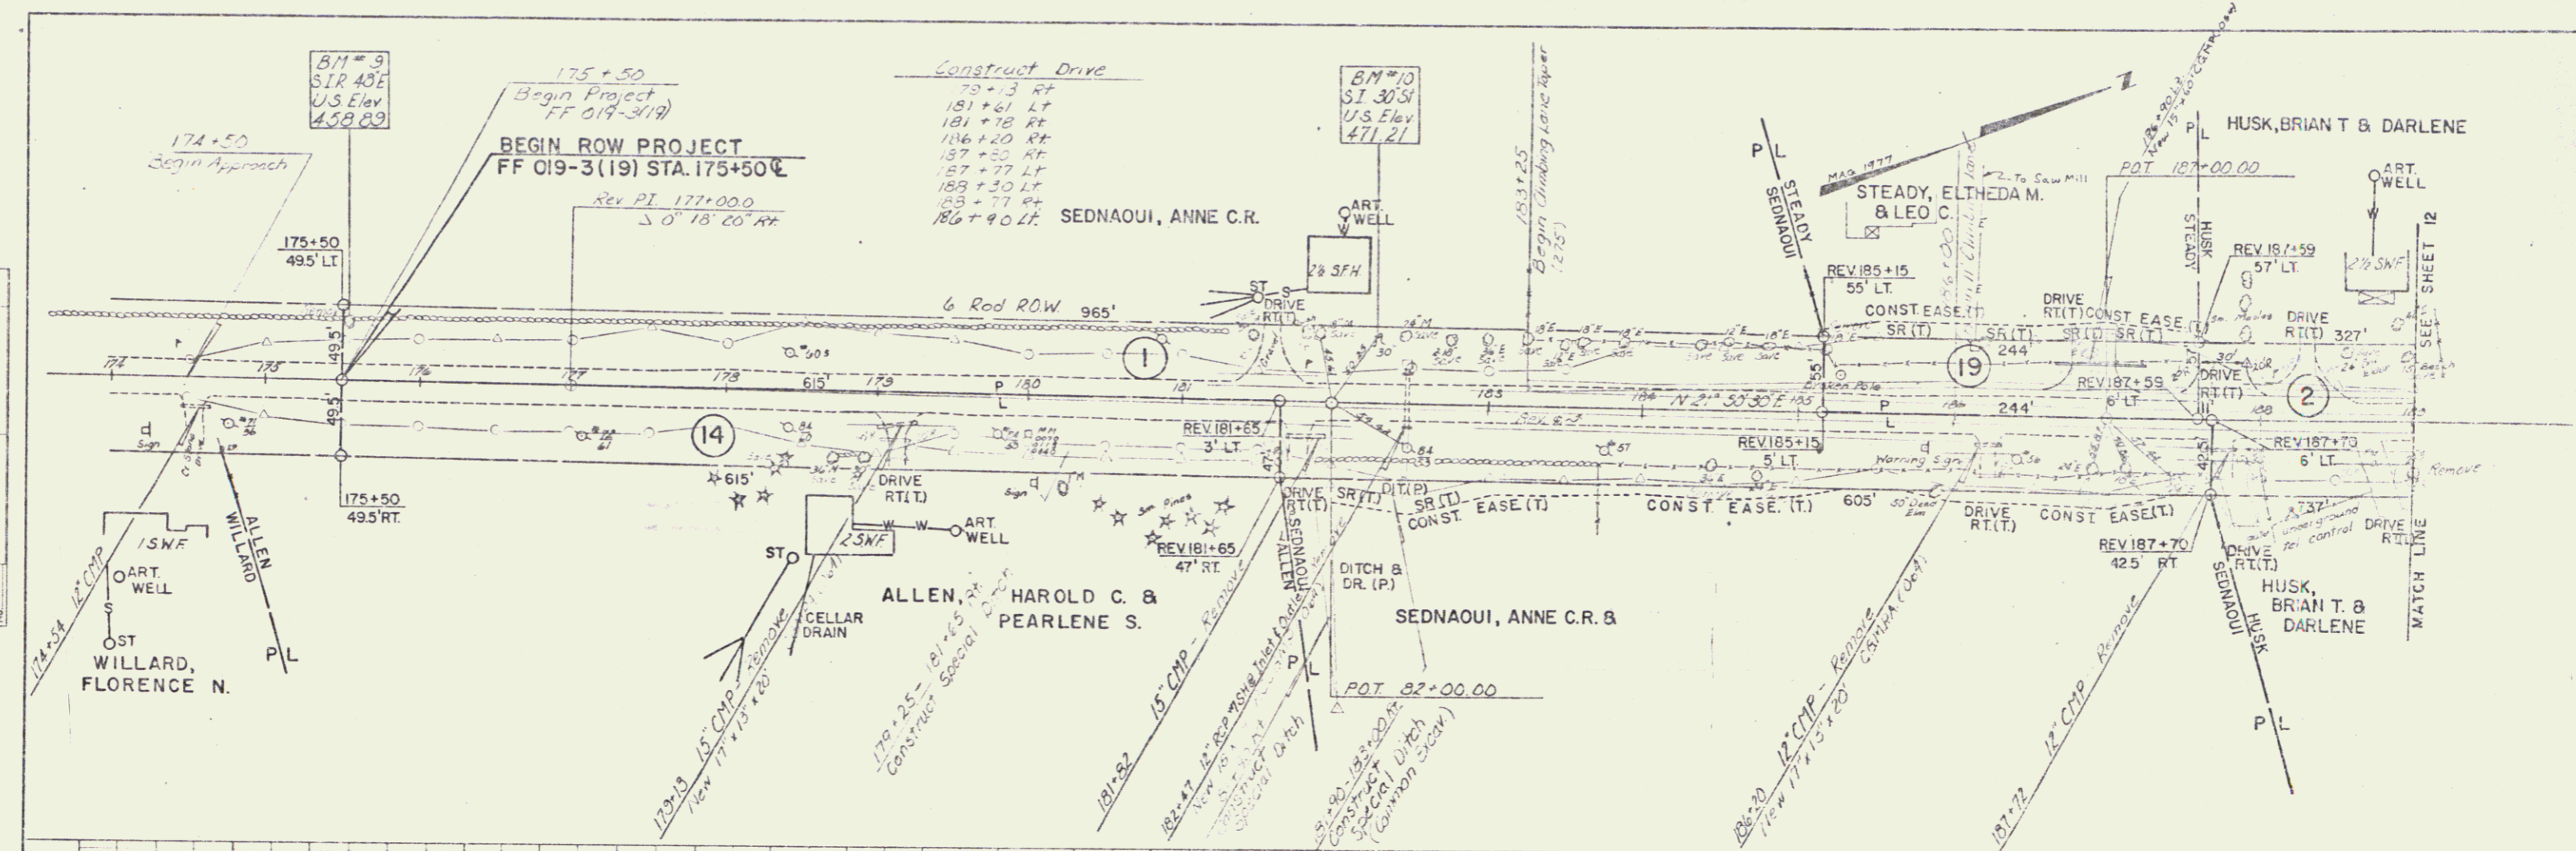

JUN 03 1985

New Haven
 FF 019-3(19)

8