


GUARD RAIL, THREE CABLE  
WITH LIGHT STEEL POSTS  
219+09 - 221+00 Rt  
228+94 - 231+02 Rt

PLAN

|           |  |
|-----------|--|
| DATE      |  |
| BY        |  |
| CHECKED   |  |
| IN CHARGE |  |
| NO.       |  |


PROFILE

|           |  |
|-----------|--|
| DATE      |  |
| BY        |  |
| CHECKED   |  |
| IN CHARGE |  |
| NO.       |  |

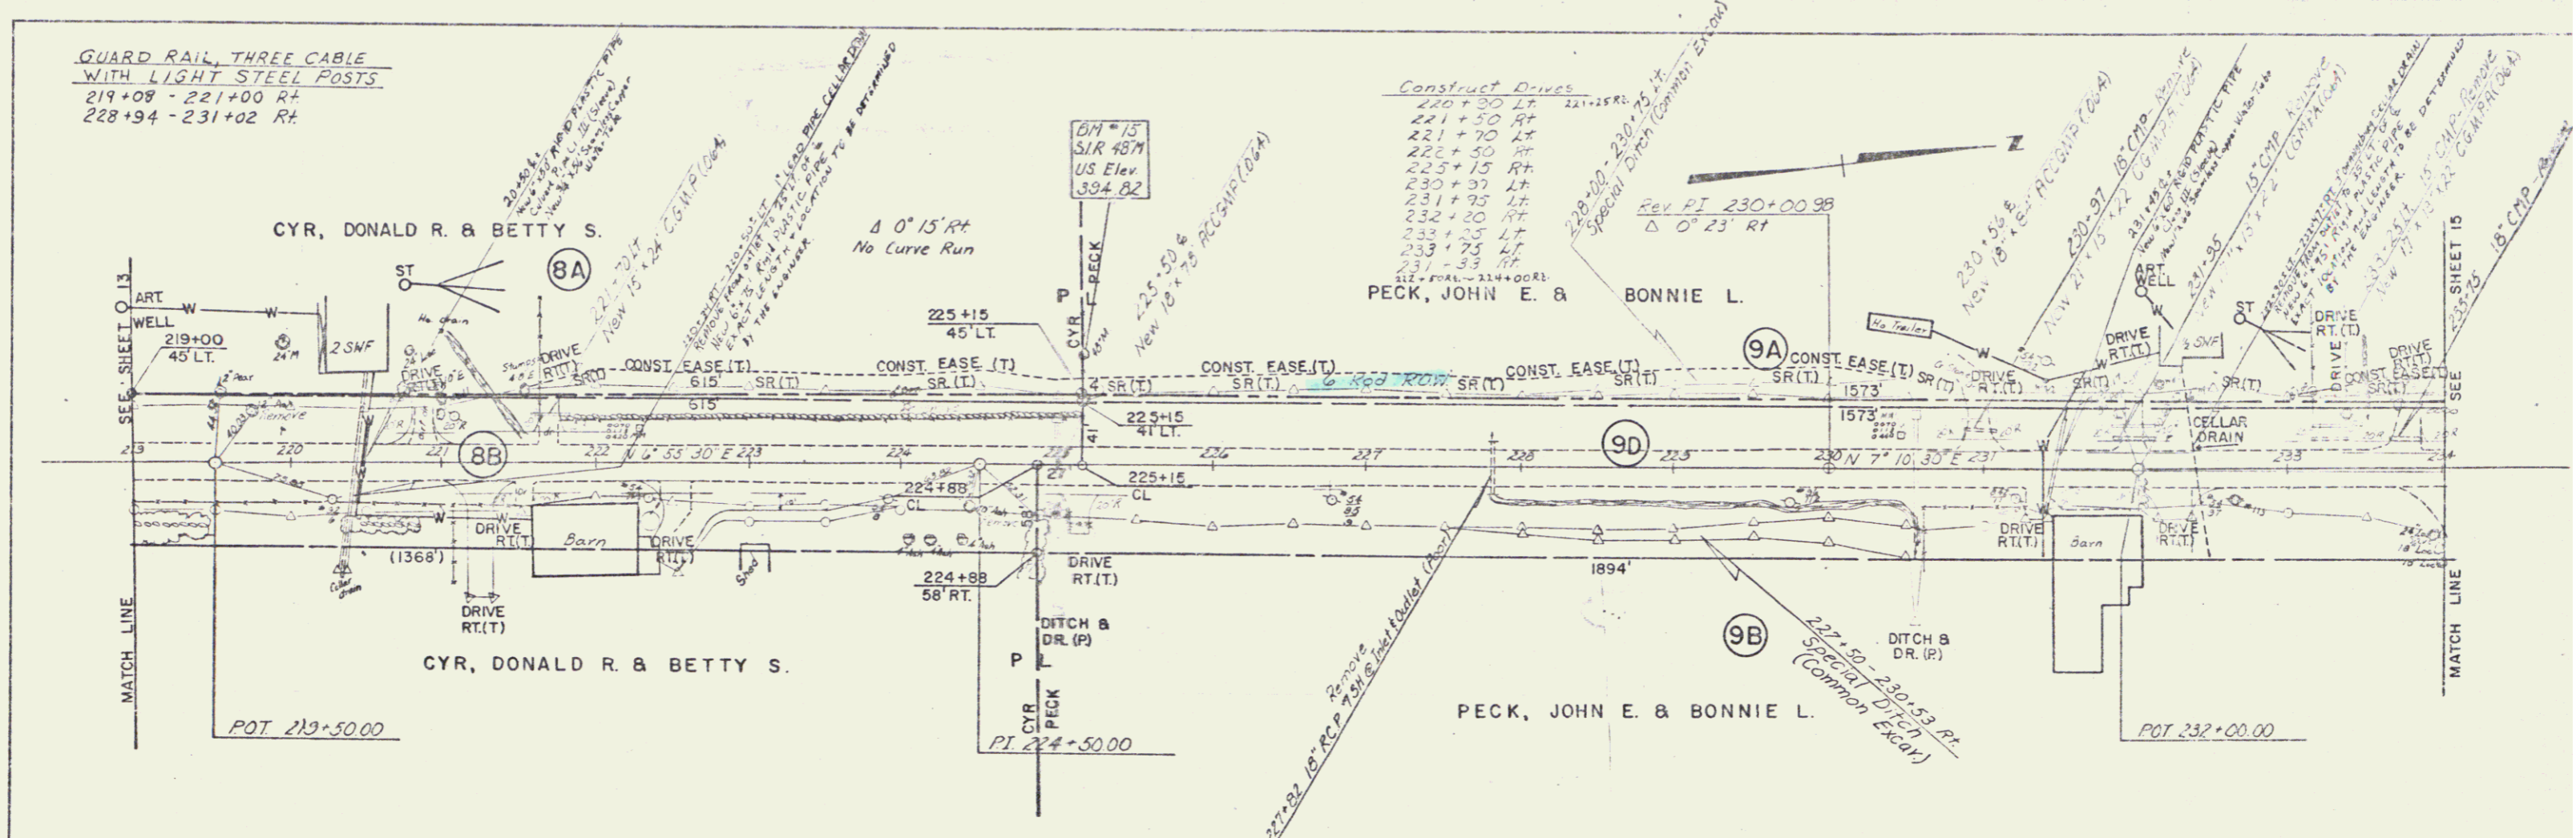

Construct Drives

|           |           |
|-----------|-----------|
| 220+30 Lt | 221+25 Rt |
| 221+50 Rt |           |
| 222+50 Rt |           |
| 223+15 Rt |           |
| 230+37 Lt |           |
| 231+95 Lt |           |
| 232+20 Rt |           |
| 233+25 Lt |           |
| 233+75 Lt |           |
| 231-33 Rt |           |

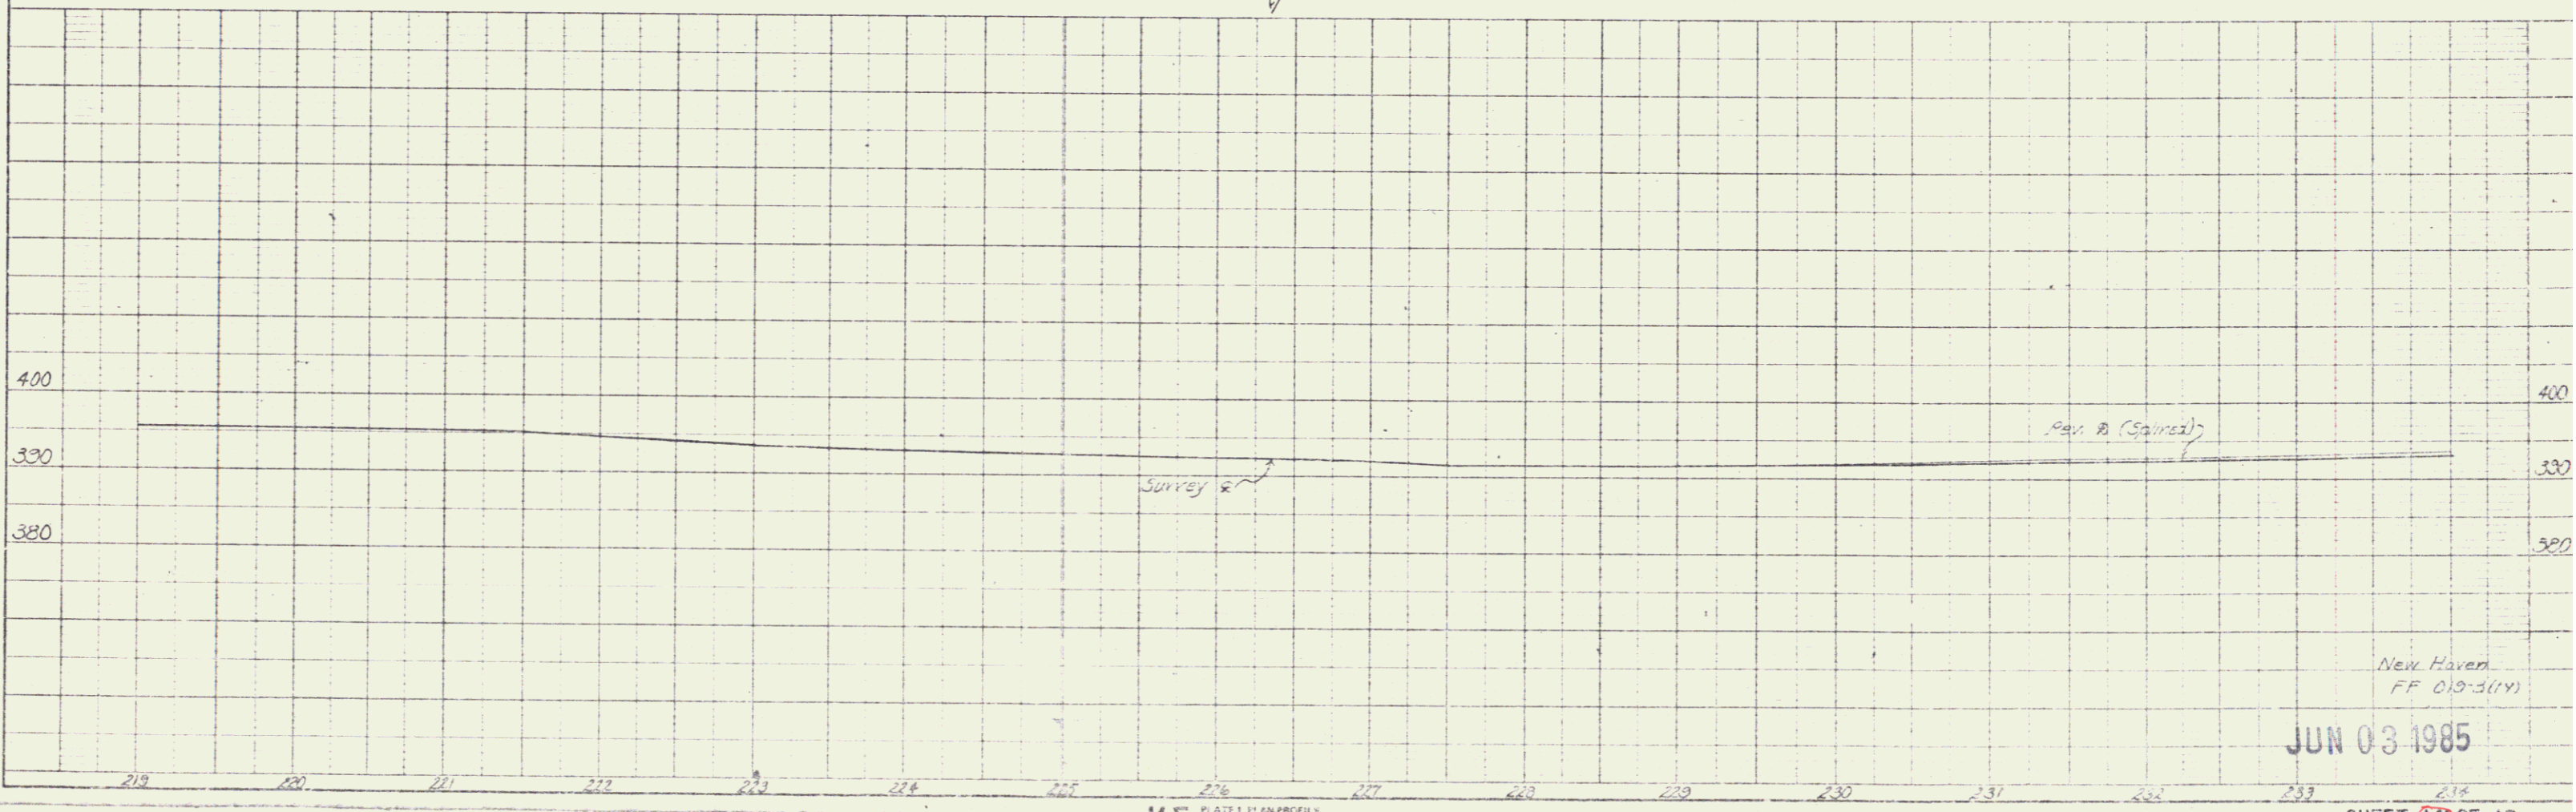

New Haven  
FF 010-3(1V)  
JUN 03 1985

15