


PLAN	DATE
REVISIONS	
NOTE BOOK	
BY	
NO.	

PROFILE	DATE
REVISIONS	
NOTE BOOK	
BY	
NO.	

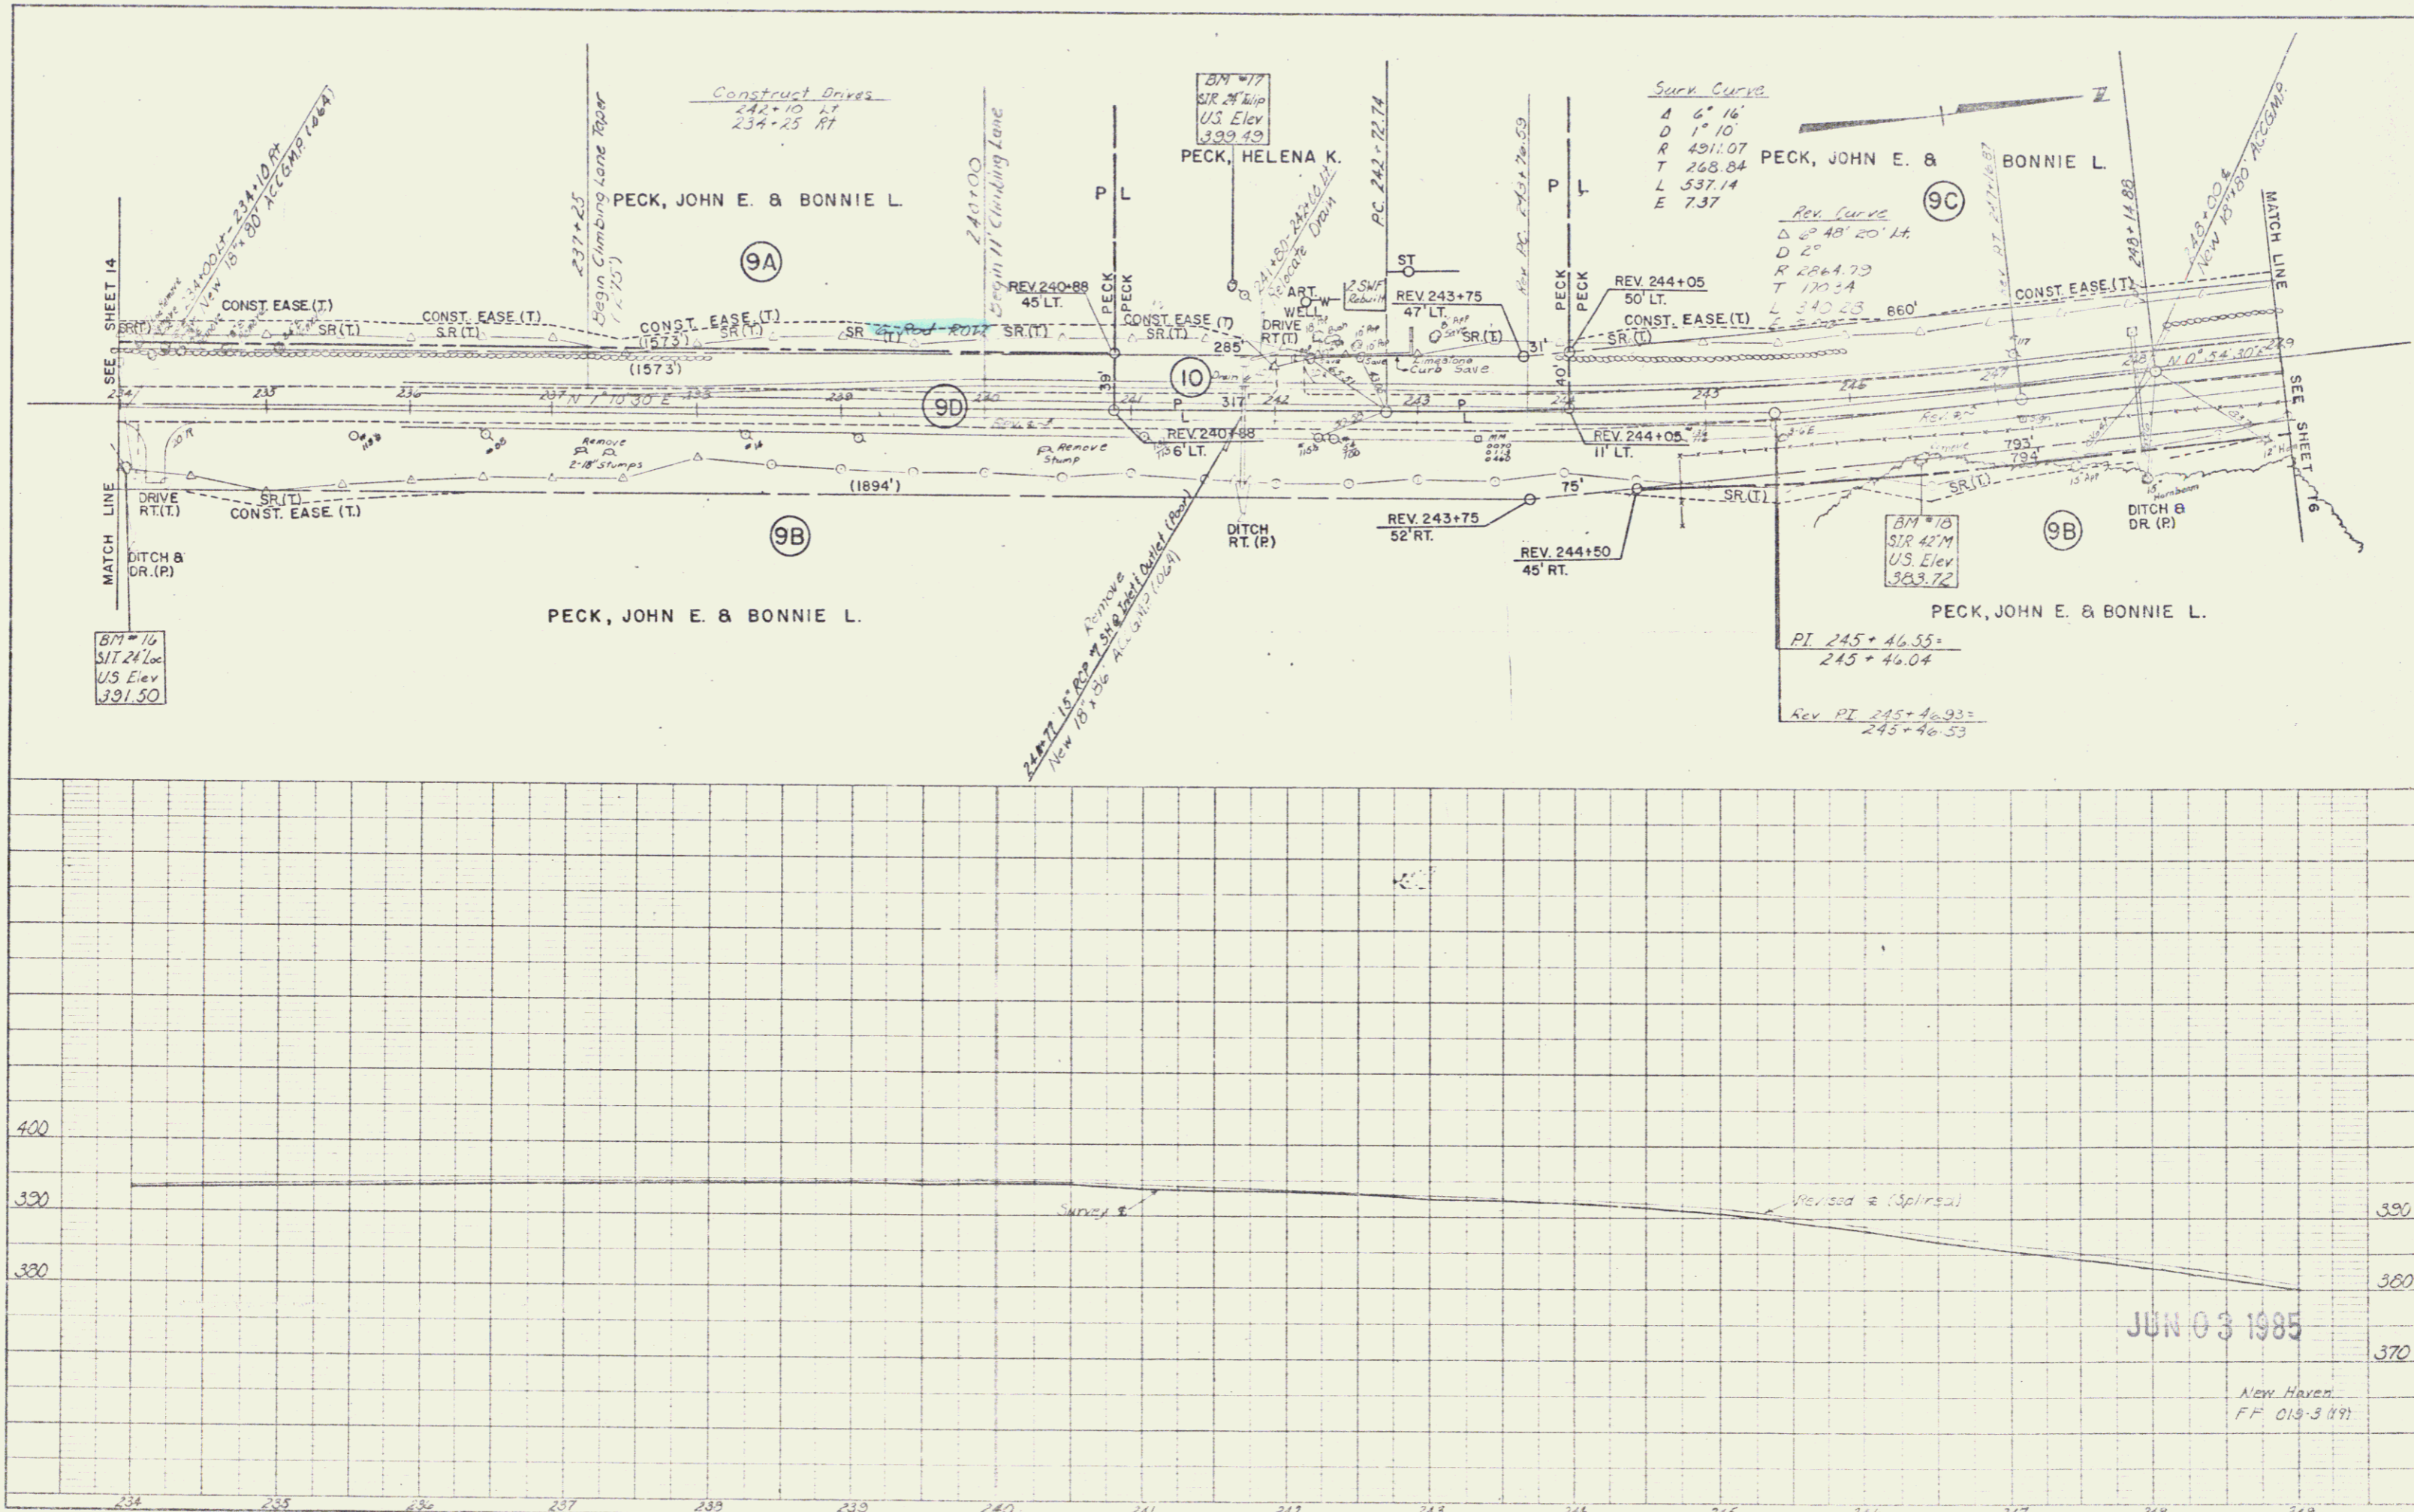

JUN 03 1985

New Haven  
FF 019-3 197