
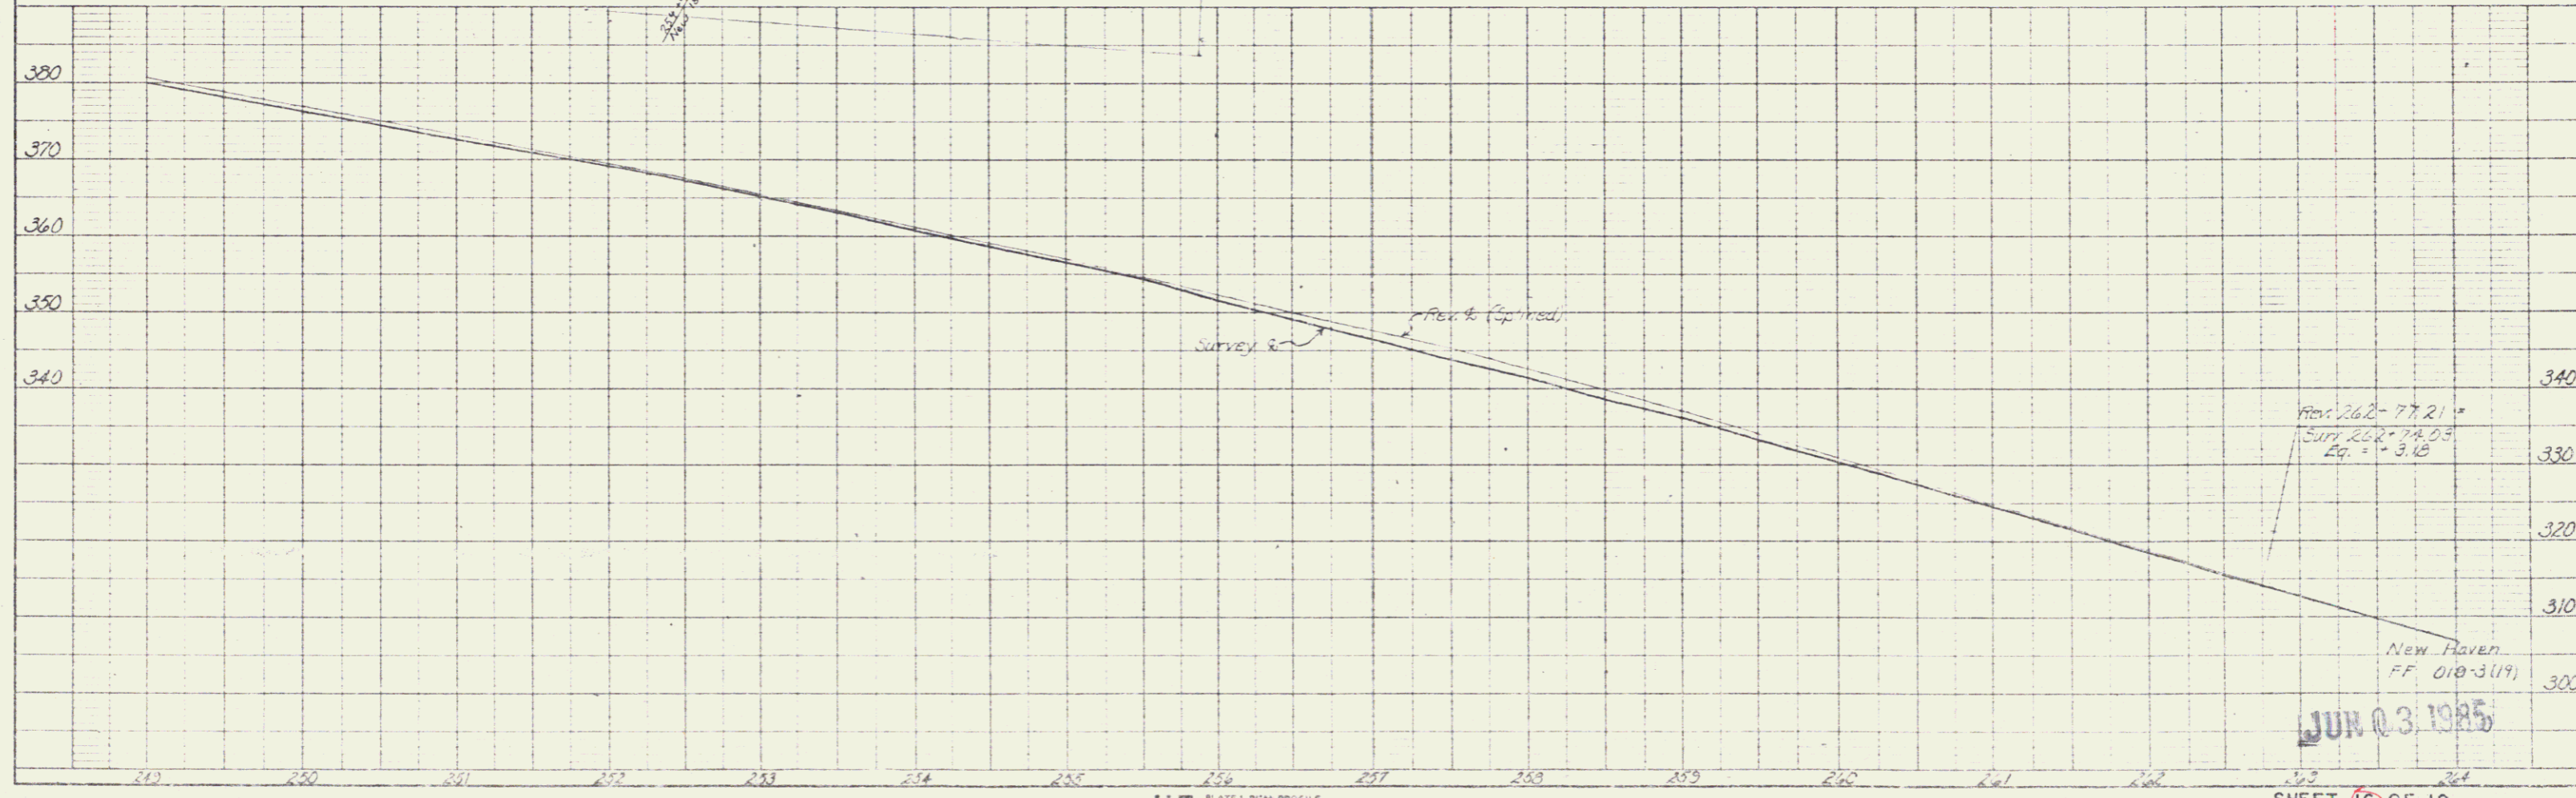


DATE	
BY	
PROJECT	
NOTE BOOK	
SCALE	

DATE	
BY	
PROJECT	
NOTE BOOK	
SCALE	

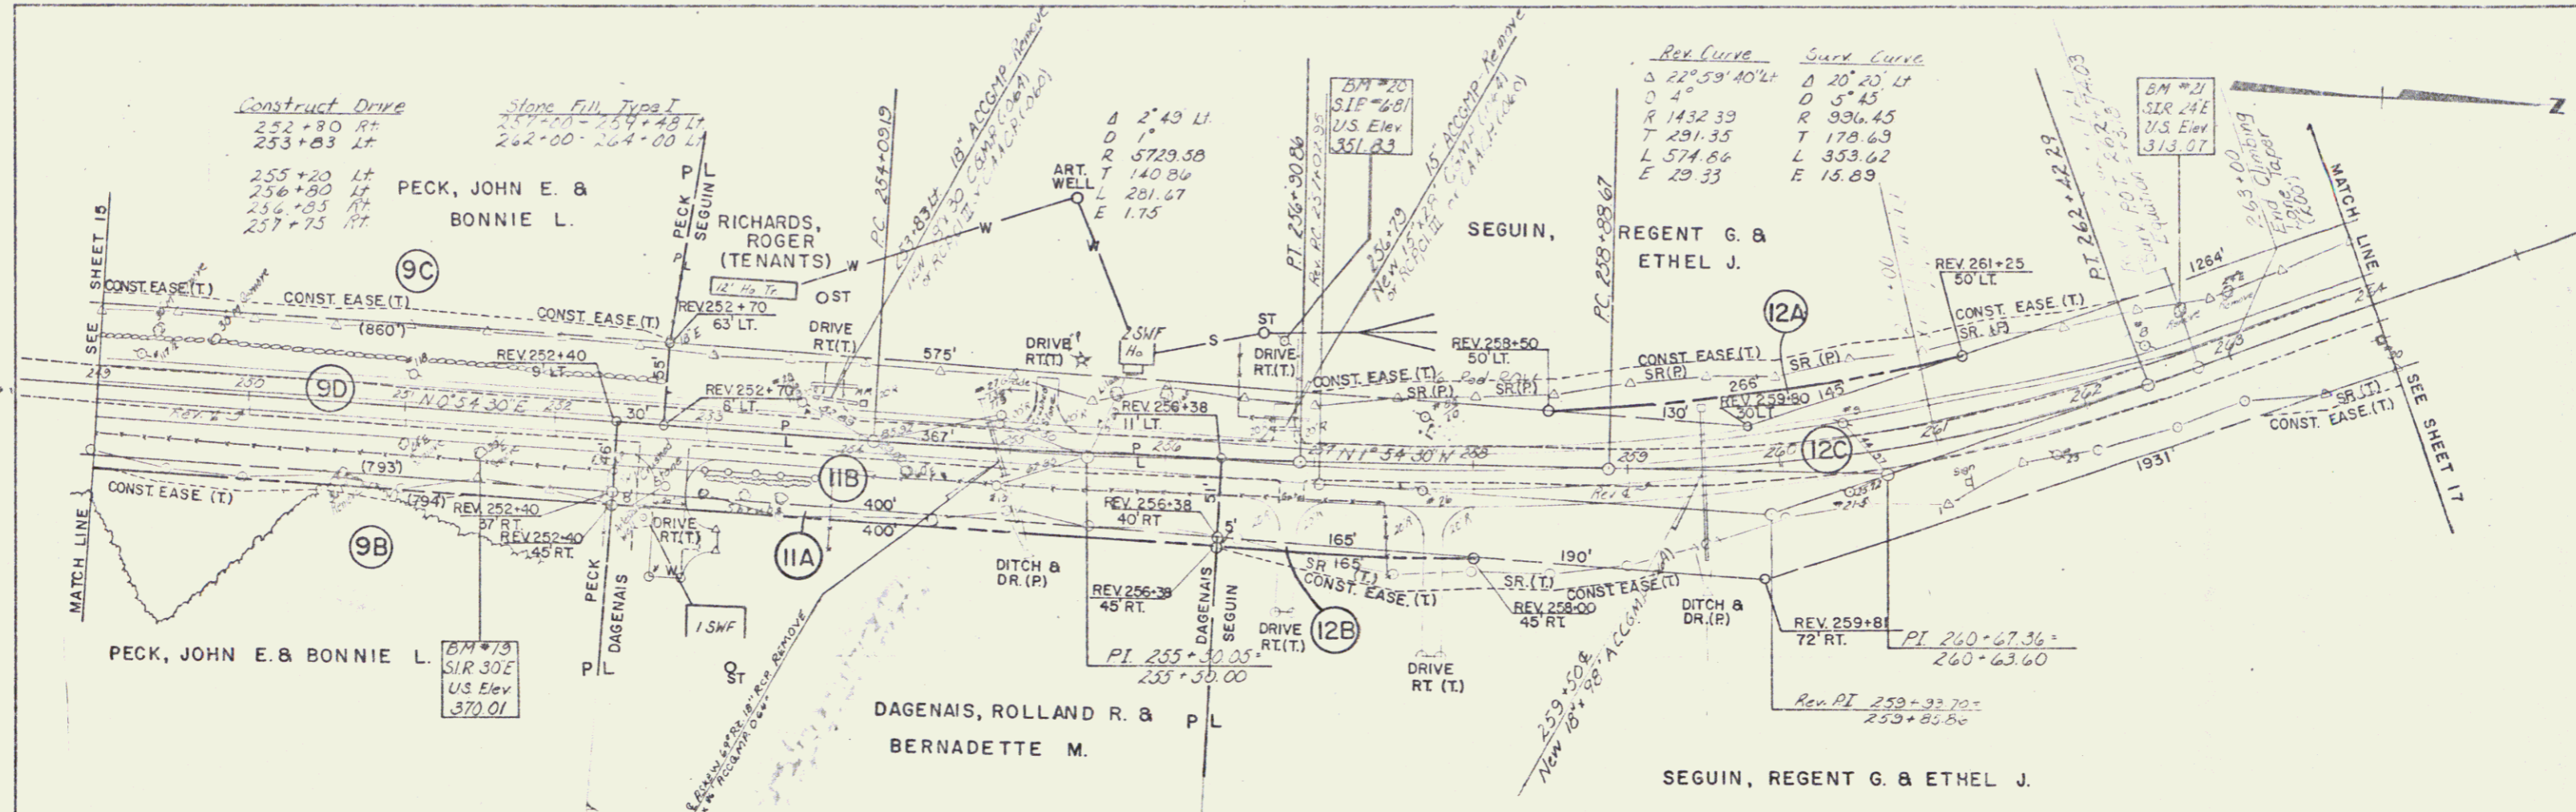

JUN 03 1985