
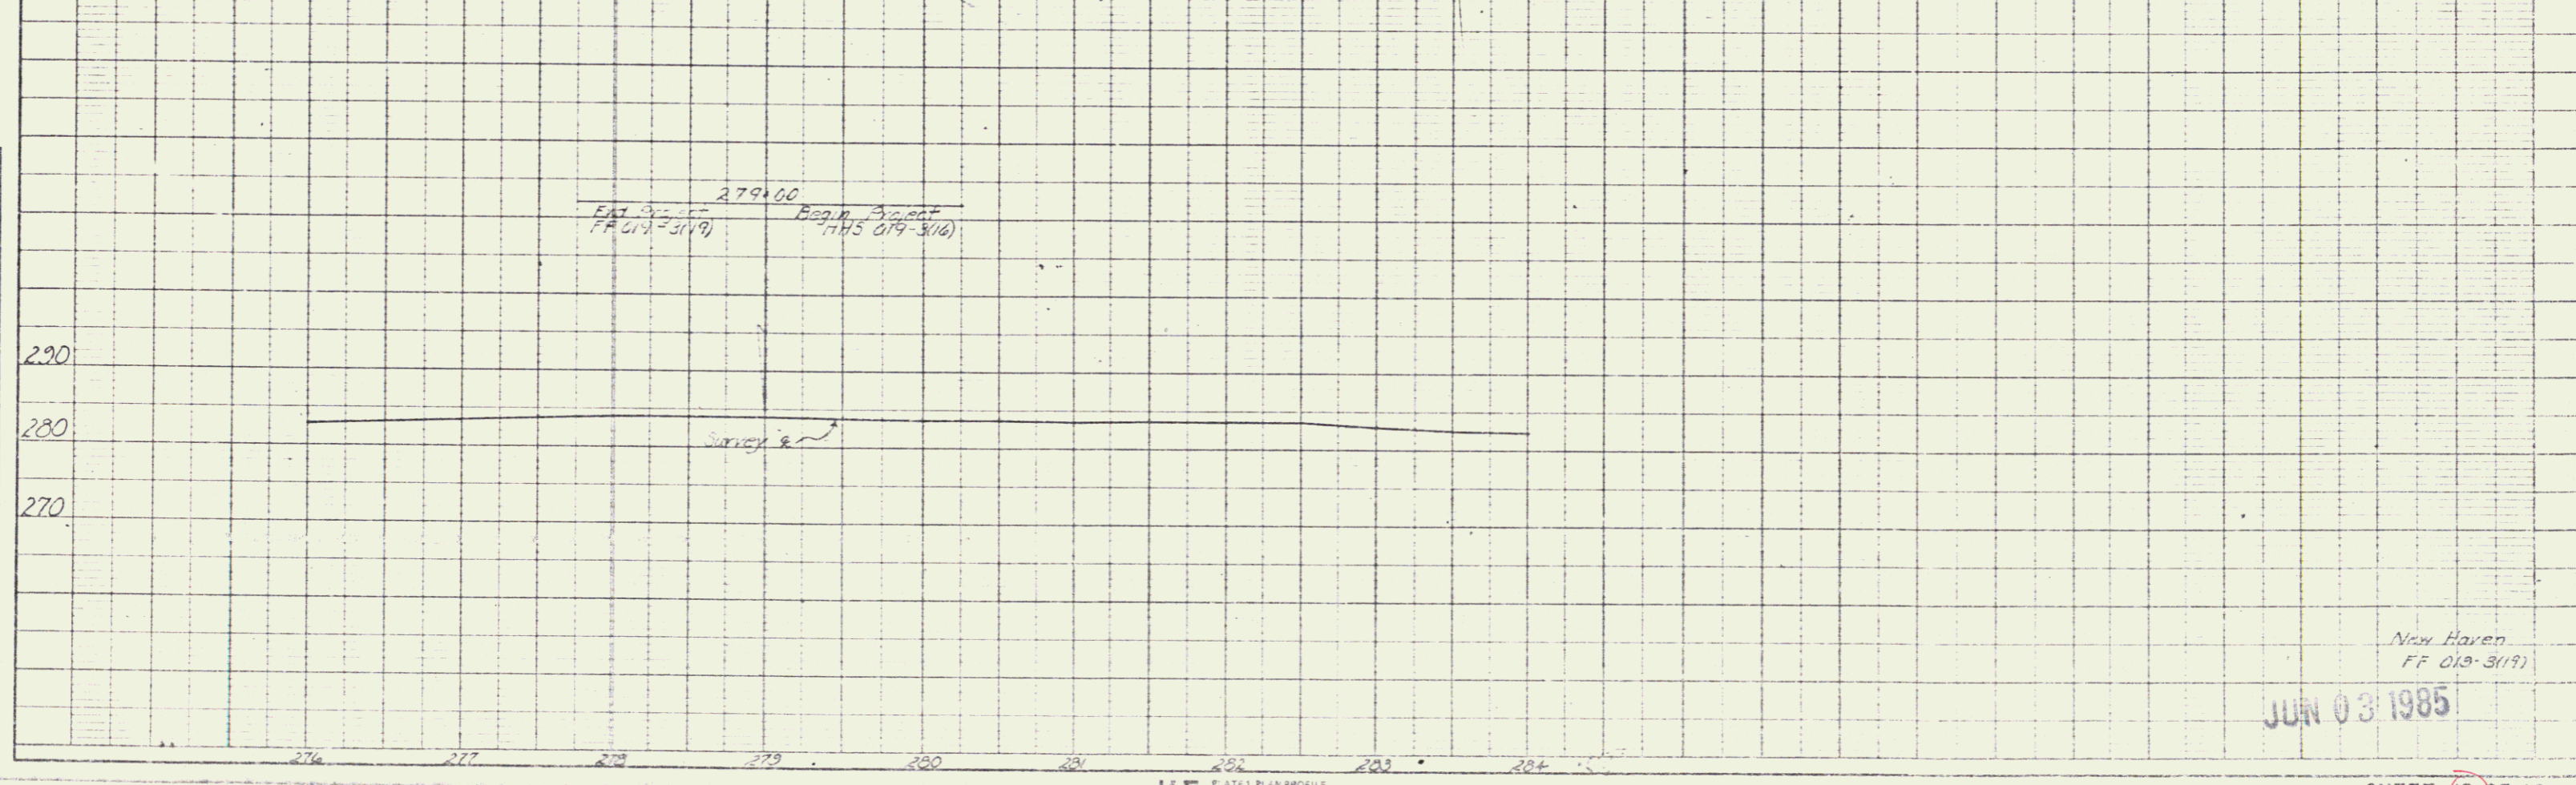


PLAN	DATE	BY
NO. 1		
NO. 2		
NO. 3		
NO. 100		

PROFILE	DATE	BY
NO. 1		
NO. 2		
NO. 3		
NO. 100		

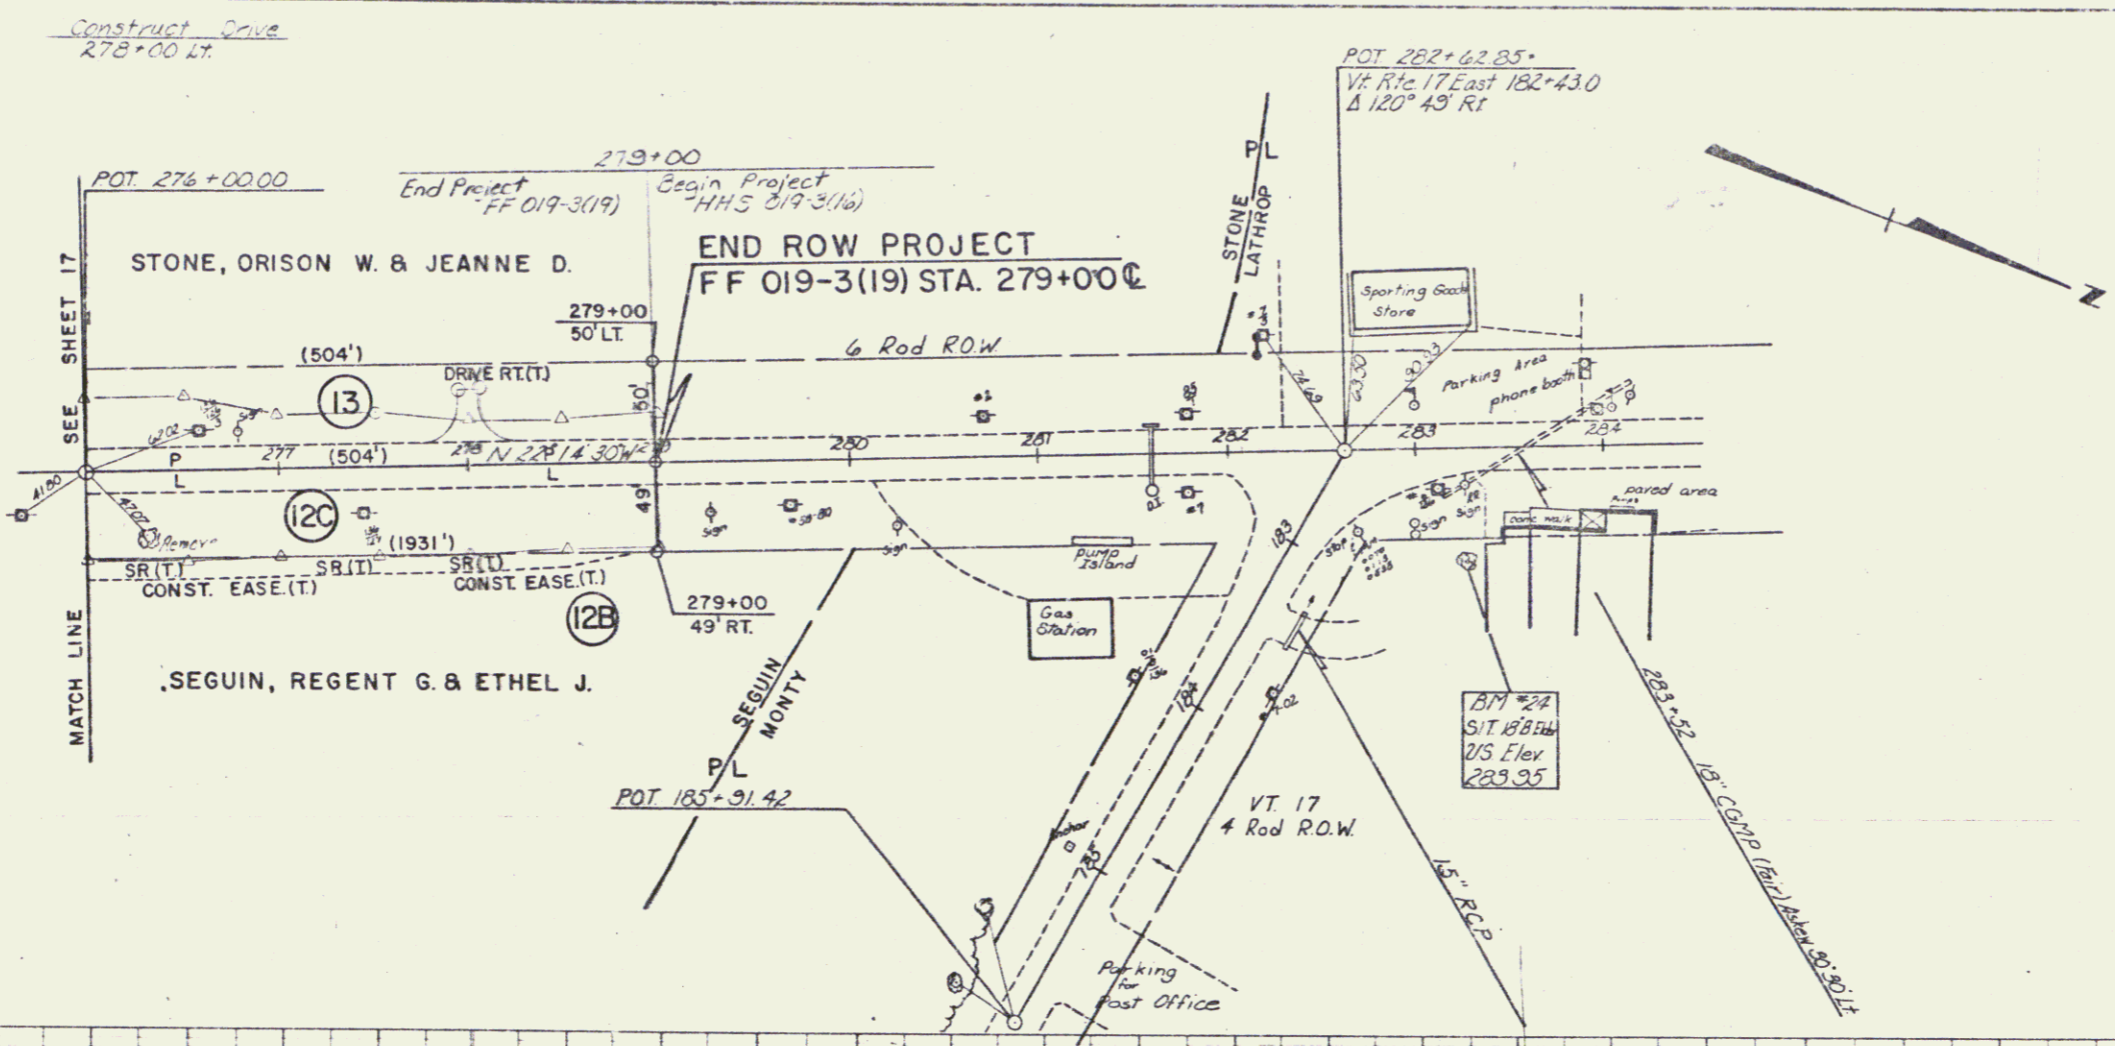

New Haven  
FF 019-3(19)  
JUN 03 1985

K-E PLATE 1, PLAN PROFILE

SHEET 18 OF 18  
17