


PLAN	DATE
NOTED	BY
REVISION	NO.
DATE	BY
NO.	BY

PROFILE	DATE
NOTED	BY
REVISION	NO.
DATE	BY
NO.	BY

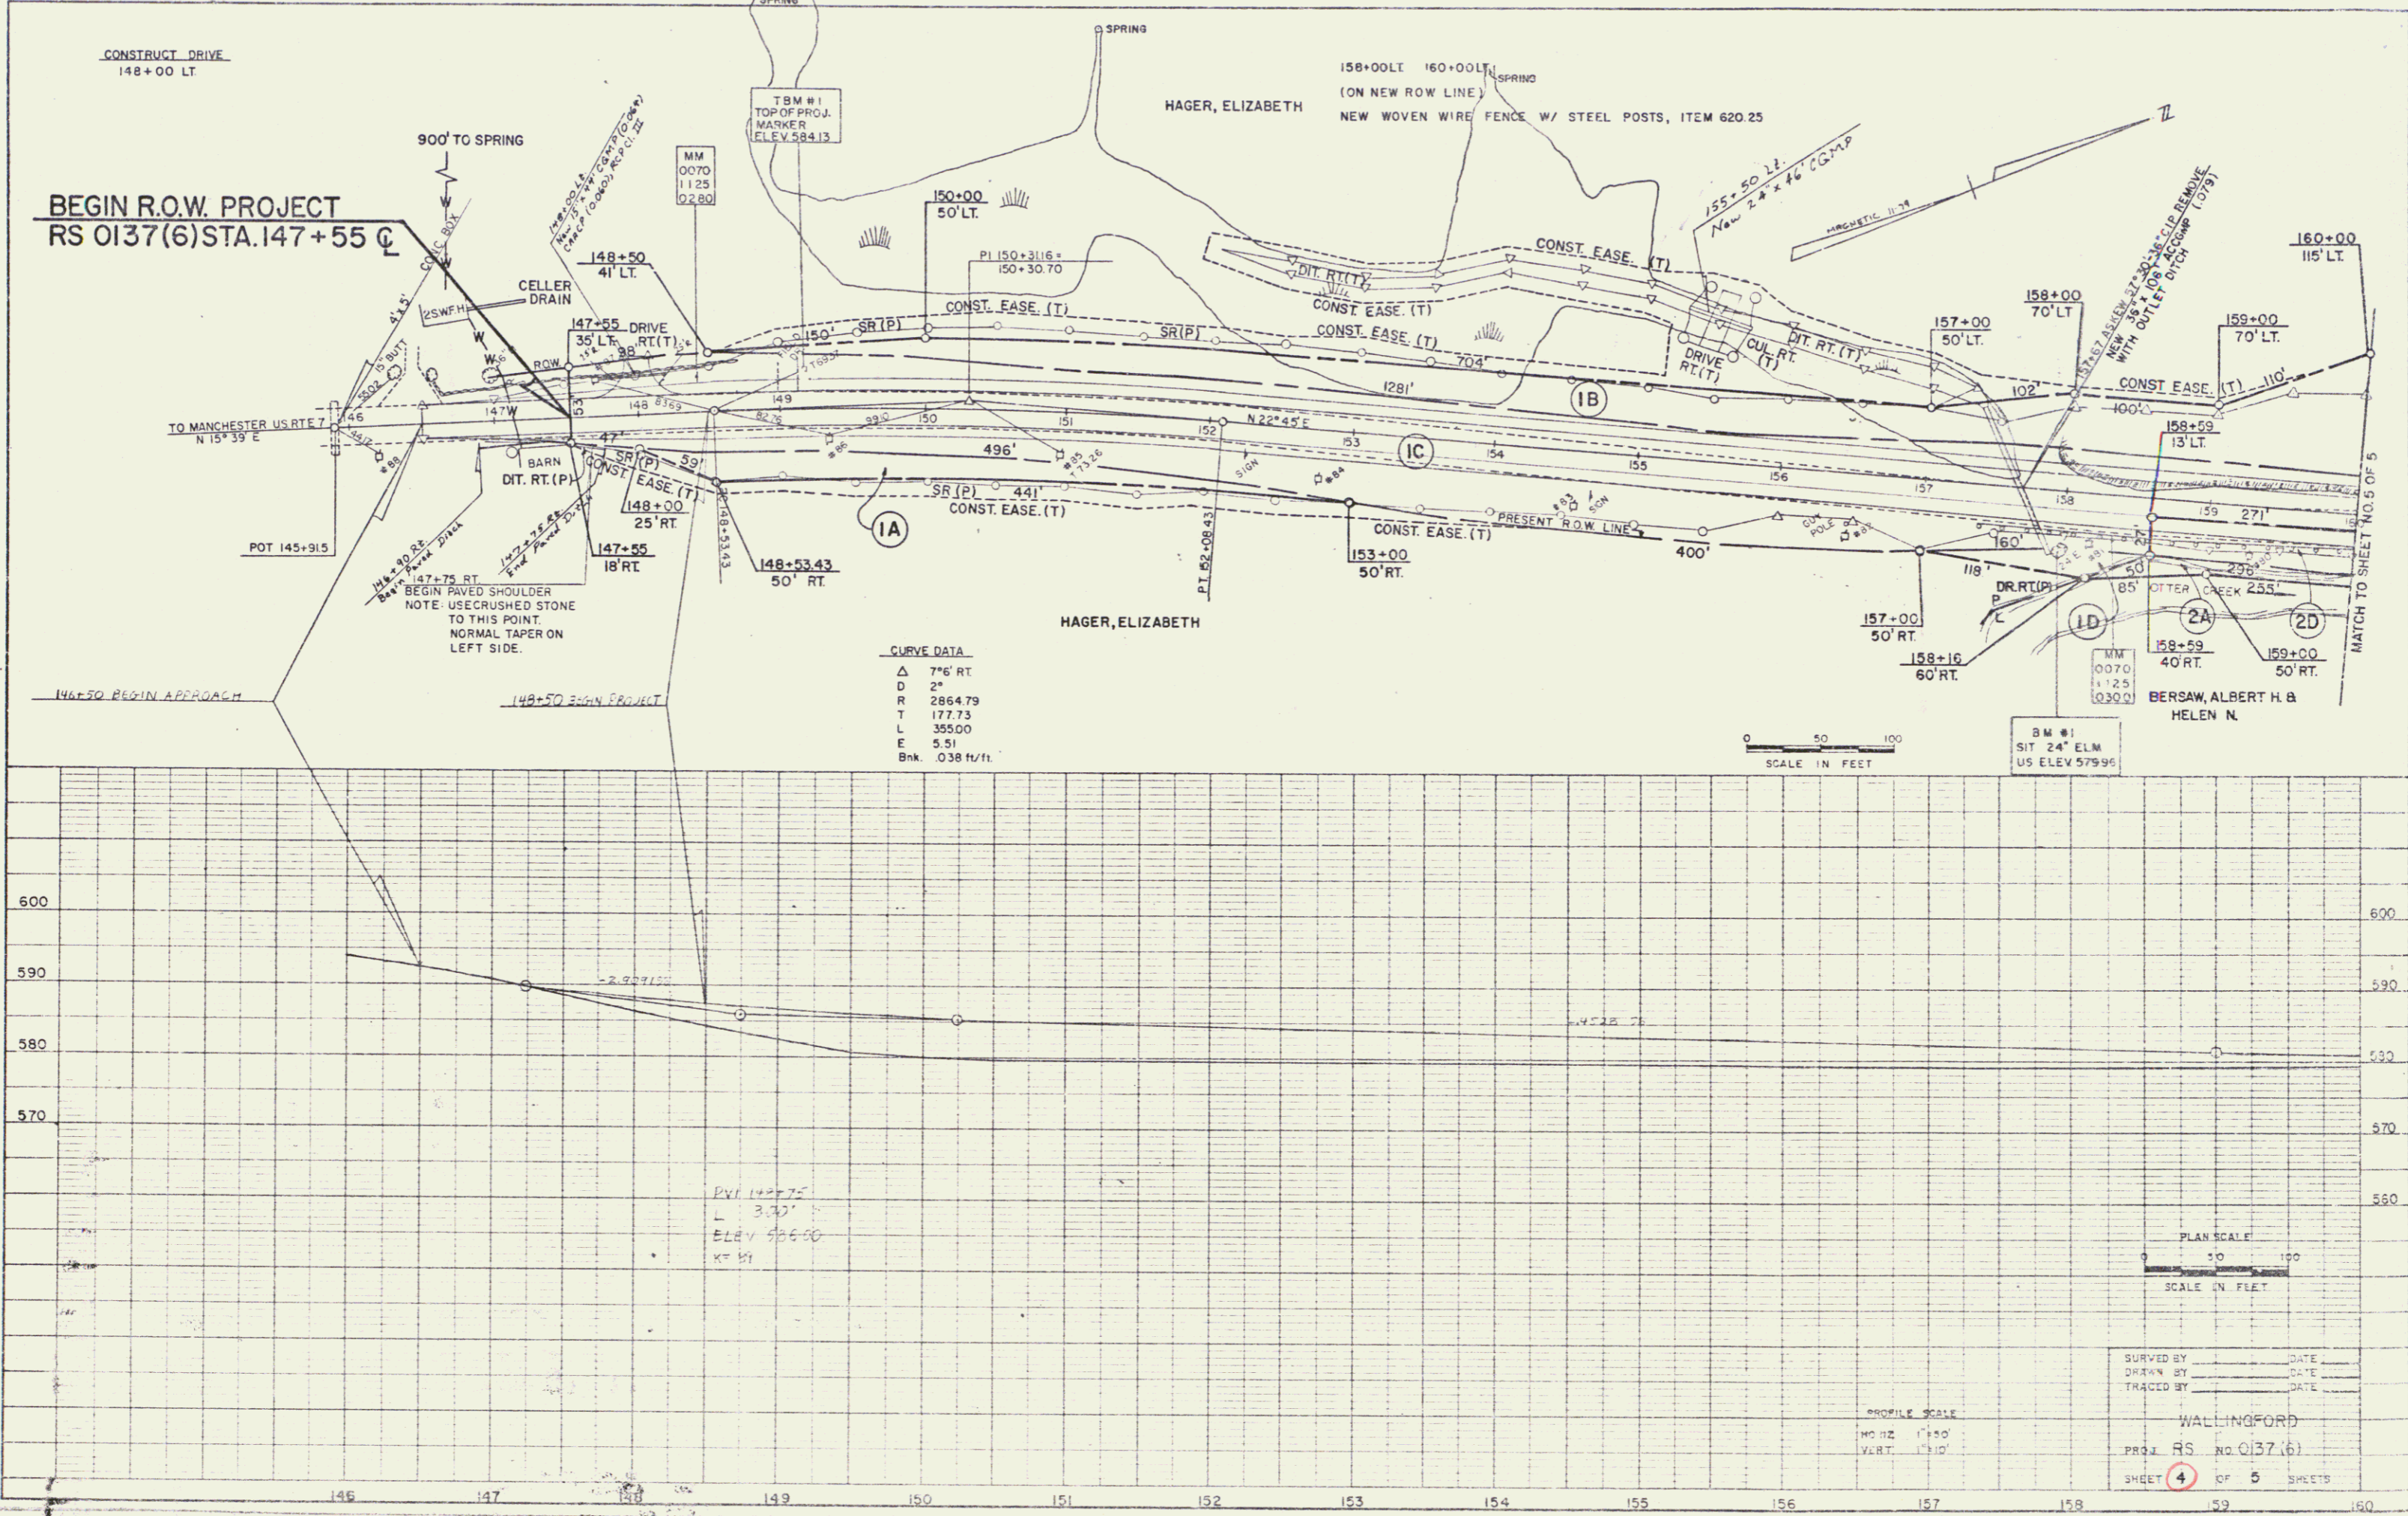

3