

INDEX OF SHEETS

1	TITLE PAGE	
2	DRAINAGE & FLOOD CONTROL SHEET	
3	EXISTING ROAD SHEET	
4-6	PLAN PROFILE SHEETS WITH TYPICALS	
7-9	GRAD	
10	2-5 EMBANKMENT ON EARTH SLOPE	12-6-71
11	2-2 ROAD CONSTRUCTION APPROACH BARS	5-14-74R
12	2-4 ON PROJECT CONSTRUCTION SIGNS	5-14-74R
13	2-1 GRADE PAI, STD. SHEETWORK W/STRA.	RATS-TYPE II
14-24	CROSS SECTIONS	6-2-74R



STATE OF VERMONT
DEPARTMENT OF HIGHWAYS



PROPOSED IMPROVEMENT
TOWN OF BRATTLEBORO
COUNTY OF WINDHAM
VERMONT ROUTE 9


BEGINNING AT A POINT 4.265 MILES EAST OF THE MARLBORO -
BRATTLEBORO TOWN LINE AND EXTENDING WESTERLY 0.770 MILES.
LENGTH OF ROADWAY 4064.00 FT. = 0.770
LENGTH OF BRIDGE
LENGTH OF PROJECT 4064.00 FT. = 0.770 MILES

R.O.W. PLANS

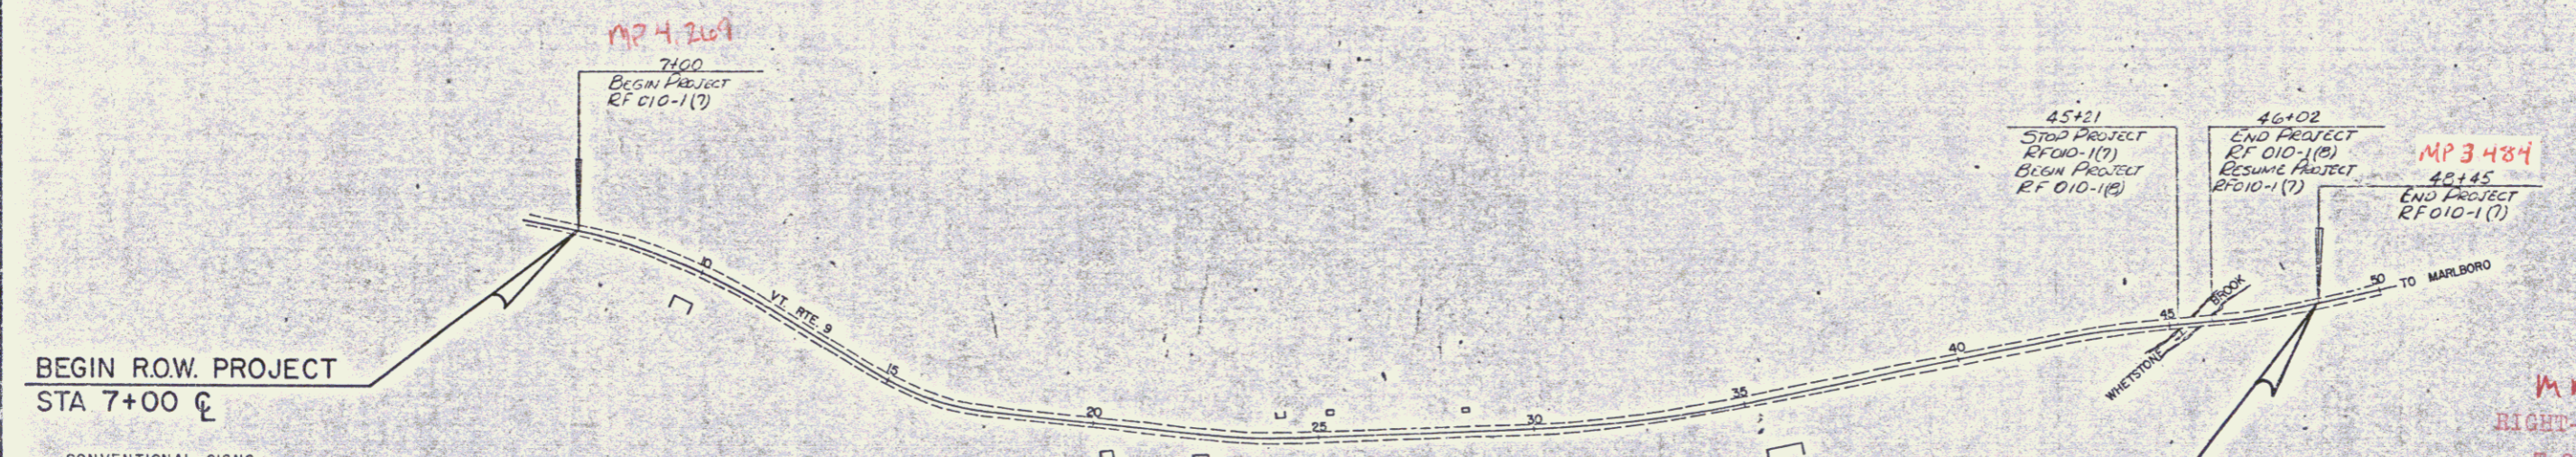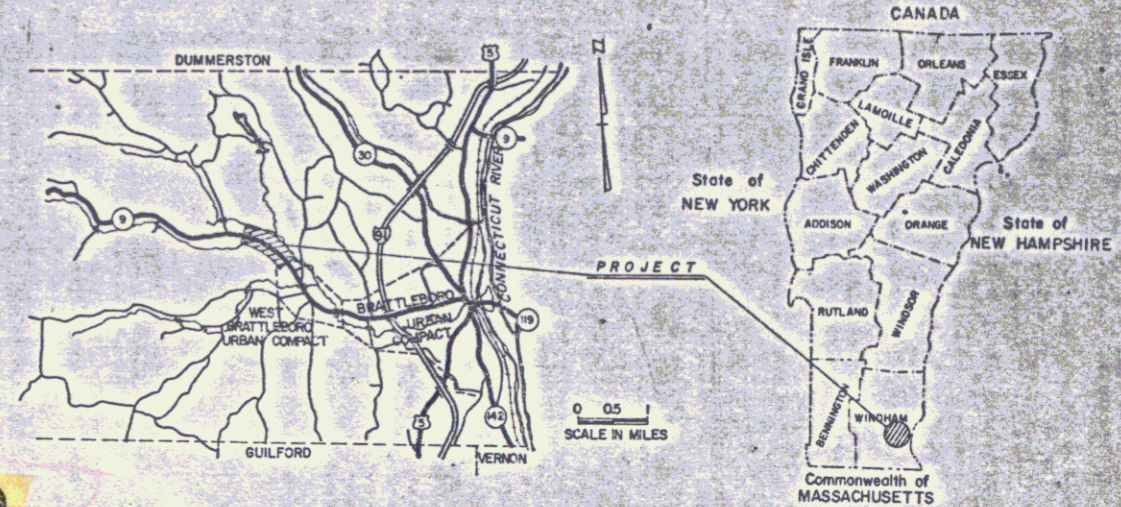

CONVENTIONAL SIGNS

COUNTY LINE	---
TOWN LINE	- - - -
LIMITS OF ACCESS	○
POINT OF ACCESS	X
FENCE LINE	— X —
STONE WALL	— X —
TRAVELED WAY	— X —
GUARD RAIL	— X —
RAILROAD	— X —
SURVEY LINE	— X —
CULVERT	— X —
POWER POLE	○
TELEPHONE POLE	○
TREES	○
F.A. CONST. IDENTIFICATION SIGNS	▲
PROPERTY LINE	— X —
R.O.W. TAKING LINE	— X —
SLOPE RIGHTS	— X —
TOP OF CUT	— X —
TOE OF SLOPE	— X —

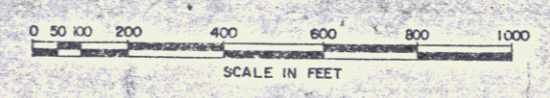

These plans are subject to such engineering changes as may be required by the Federal Highway Administration or the Chief Engineer. Construction is to be carried on in accordance with these plans and the Standard Specifications for Highway and Bridge Construction dated January 3, 1972 as approved by the Federal Highway Administration on December 28, 1971 for use on this project, including all subsequent revisions and such revised specification and special provisions as are incorporated in these plans.

APPROVED *[Signature]*
DIRECTOR OF R.O.W.
DATE 8-26-76

MM 3.5 to 4.27
RIGHT-OF-WAY DIVISION
TOWN FILE

PERPETUAL
Town of VT 9
(To Be Returned to the State)

Pin # 76G159

SUBMITTED BY ORDER OF THE STATE HIGHWAY BOARD
APPROVED *[Signature]* DATE 8-27-76
CHIEF ENGINEER

DEPARTMENT OF TRANSPORTATION
FEDERAL HIGHWAY ADMINISTRATION
APPROVED _____ DATE _____
DIVISION ENGINEER

PROJECT RF M3 010-1(?)
SHEET 1 OF 5 SHEETS