
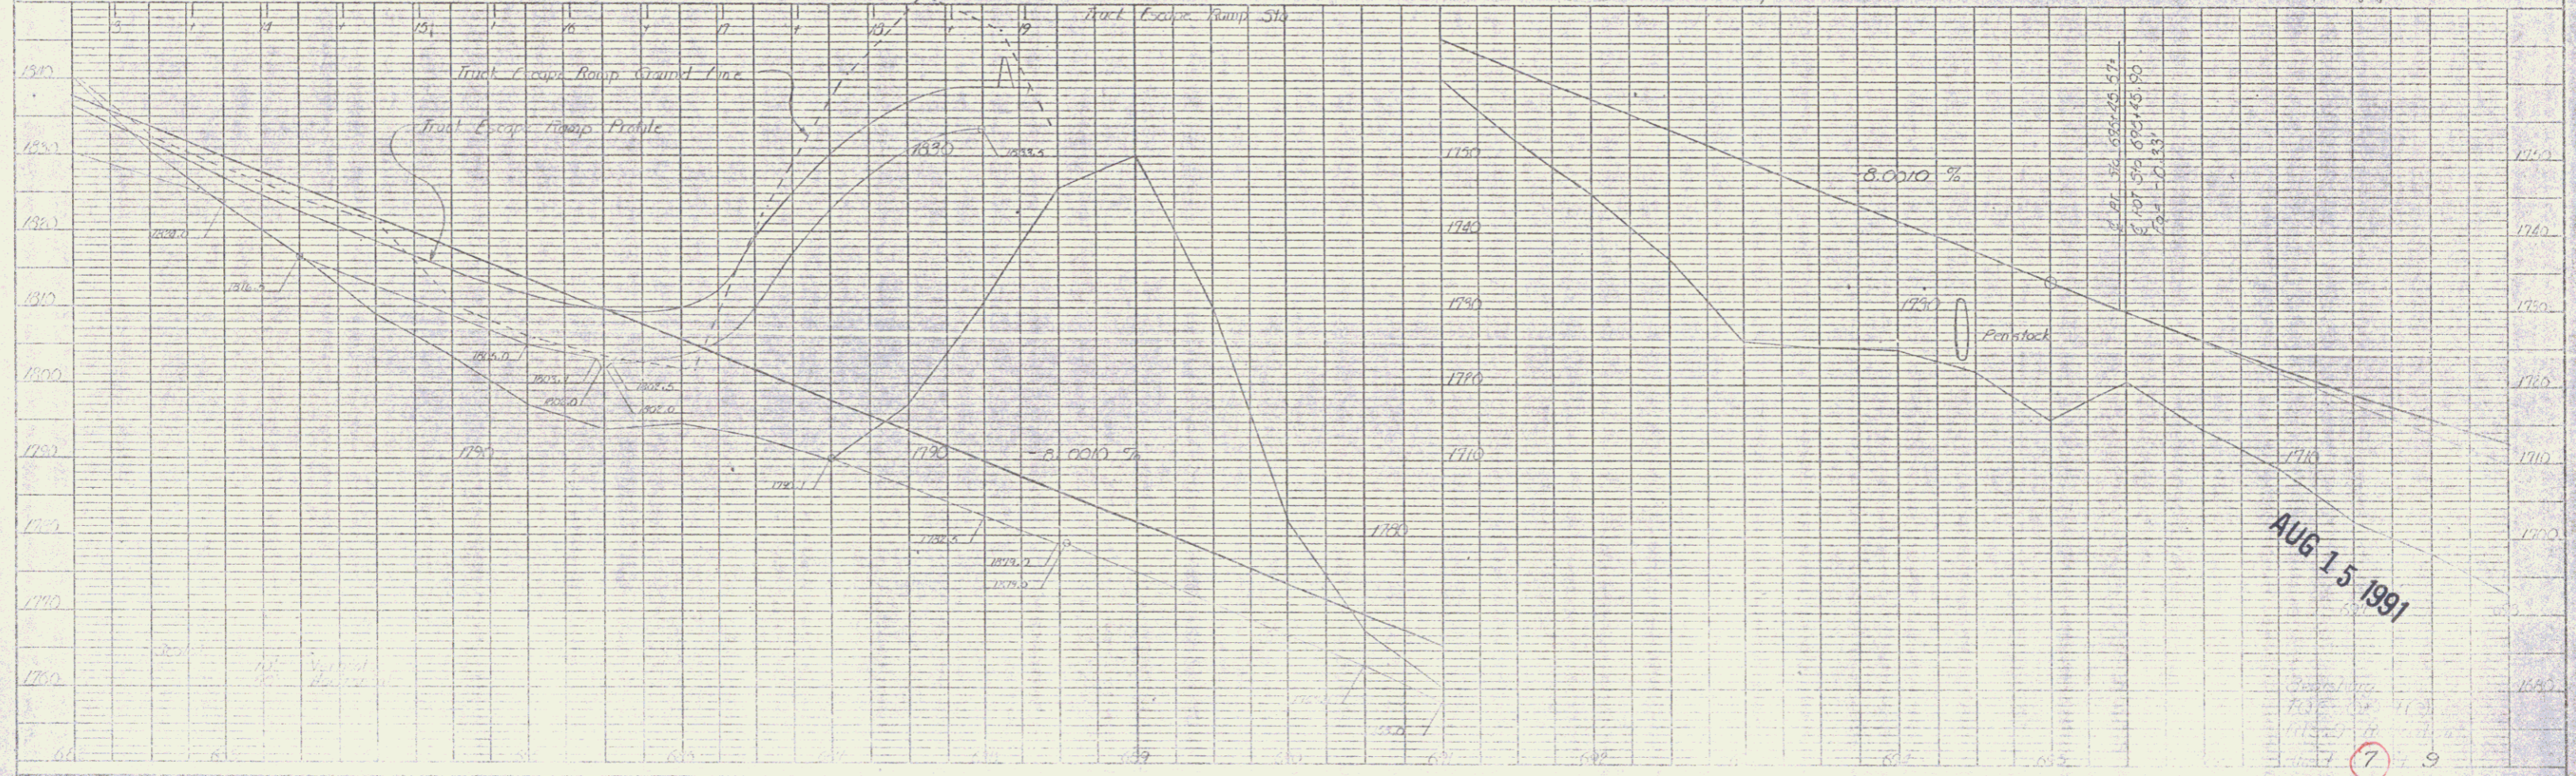


POOR ORIGINAL COPY

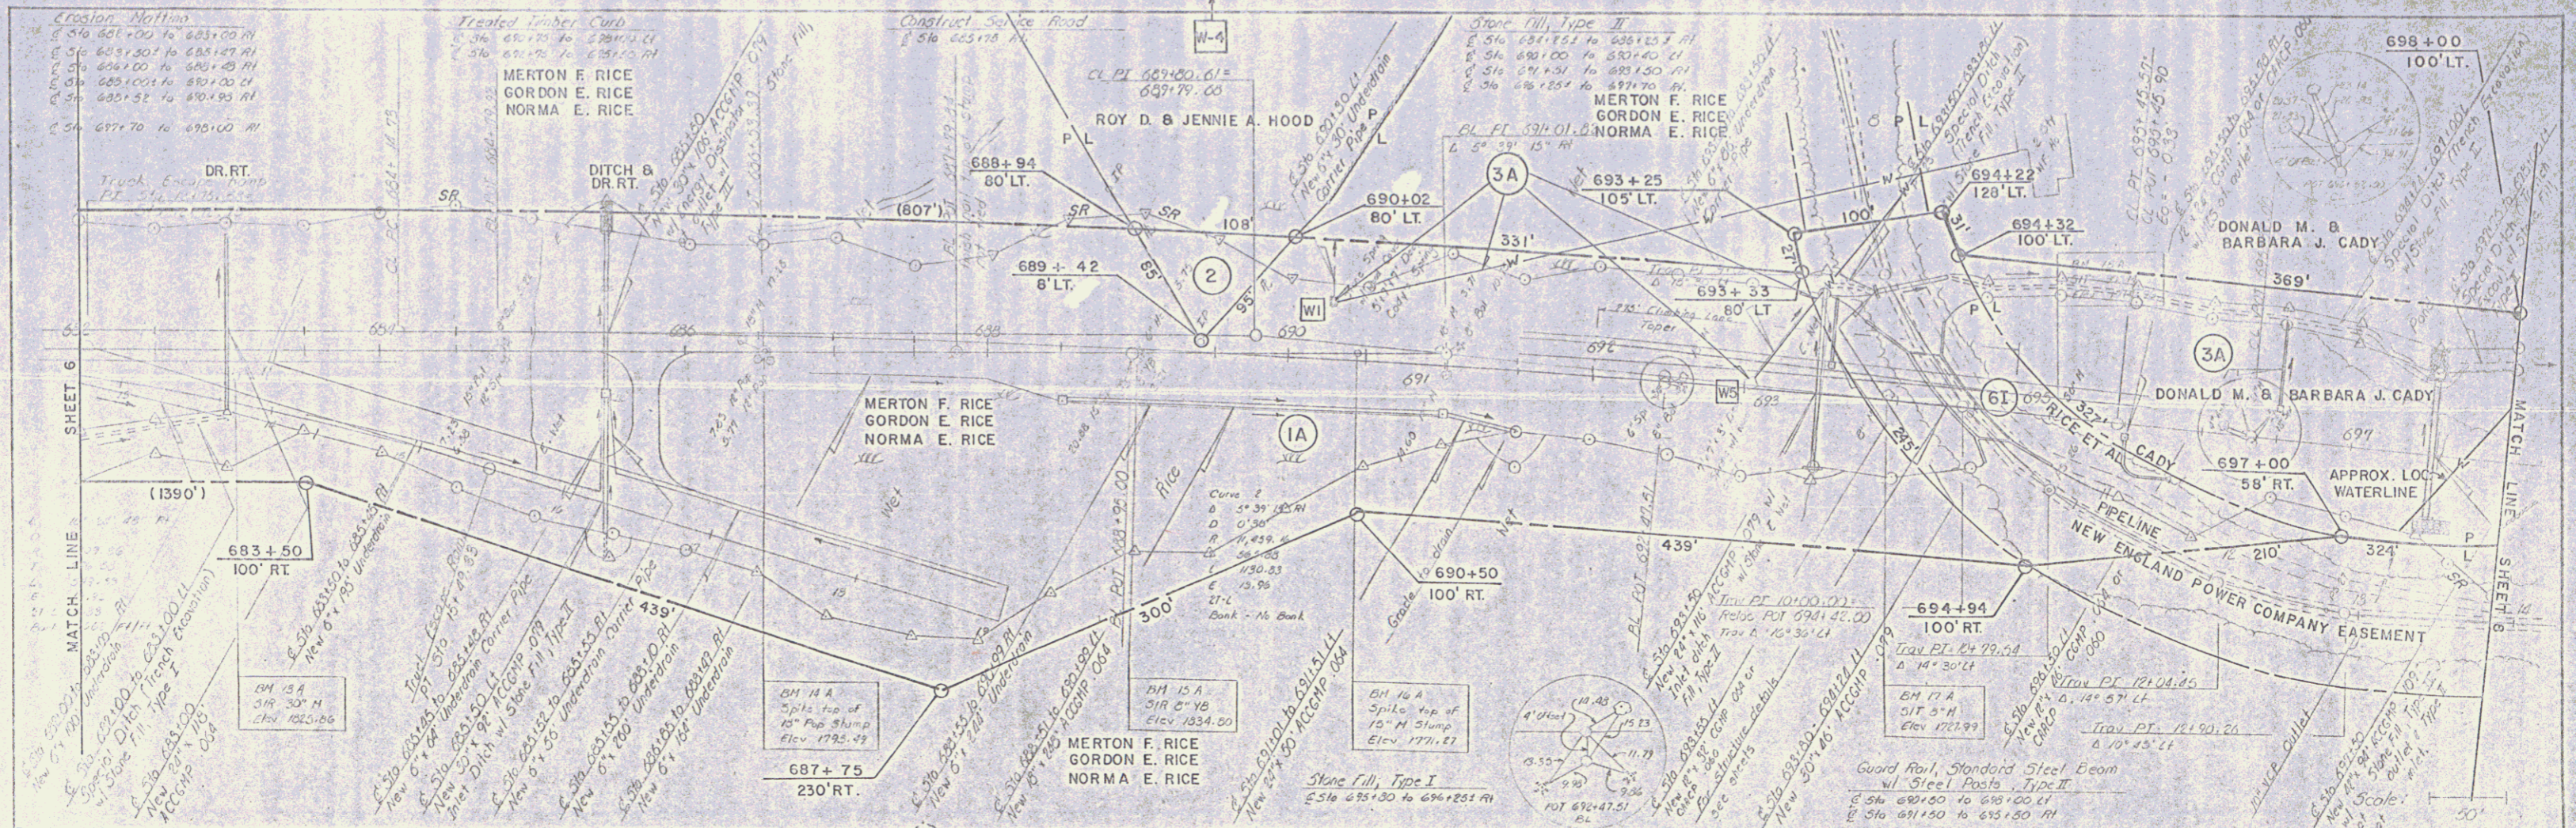

AUG 15 1991