
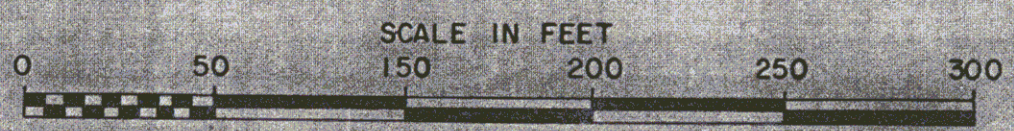
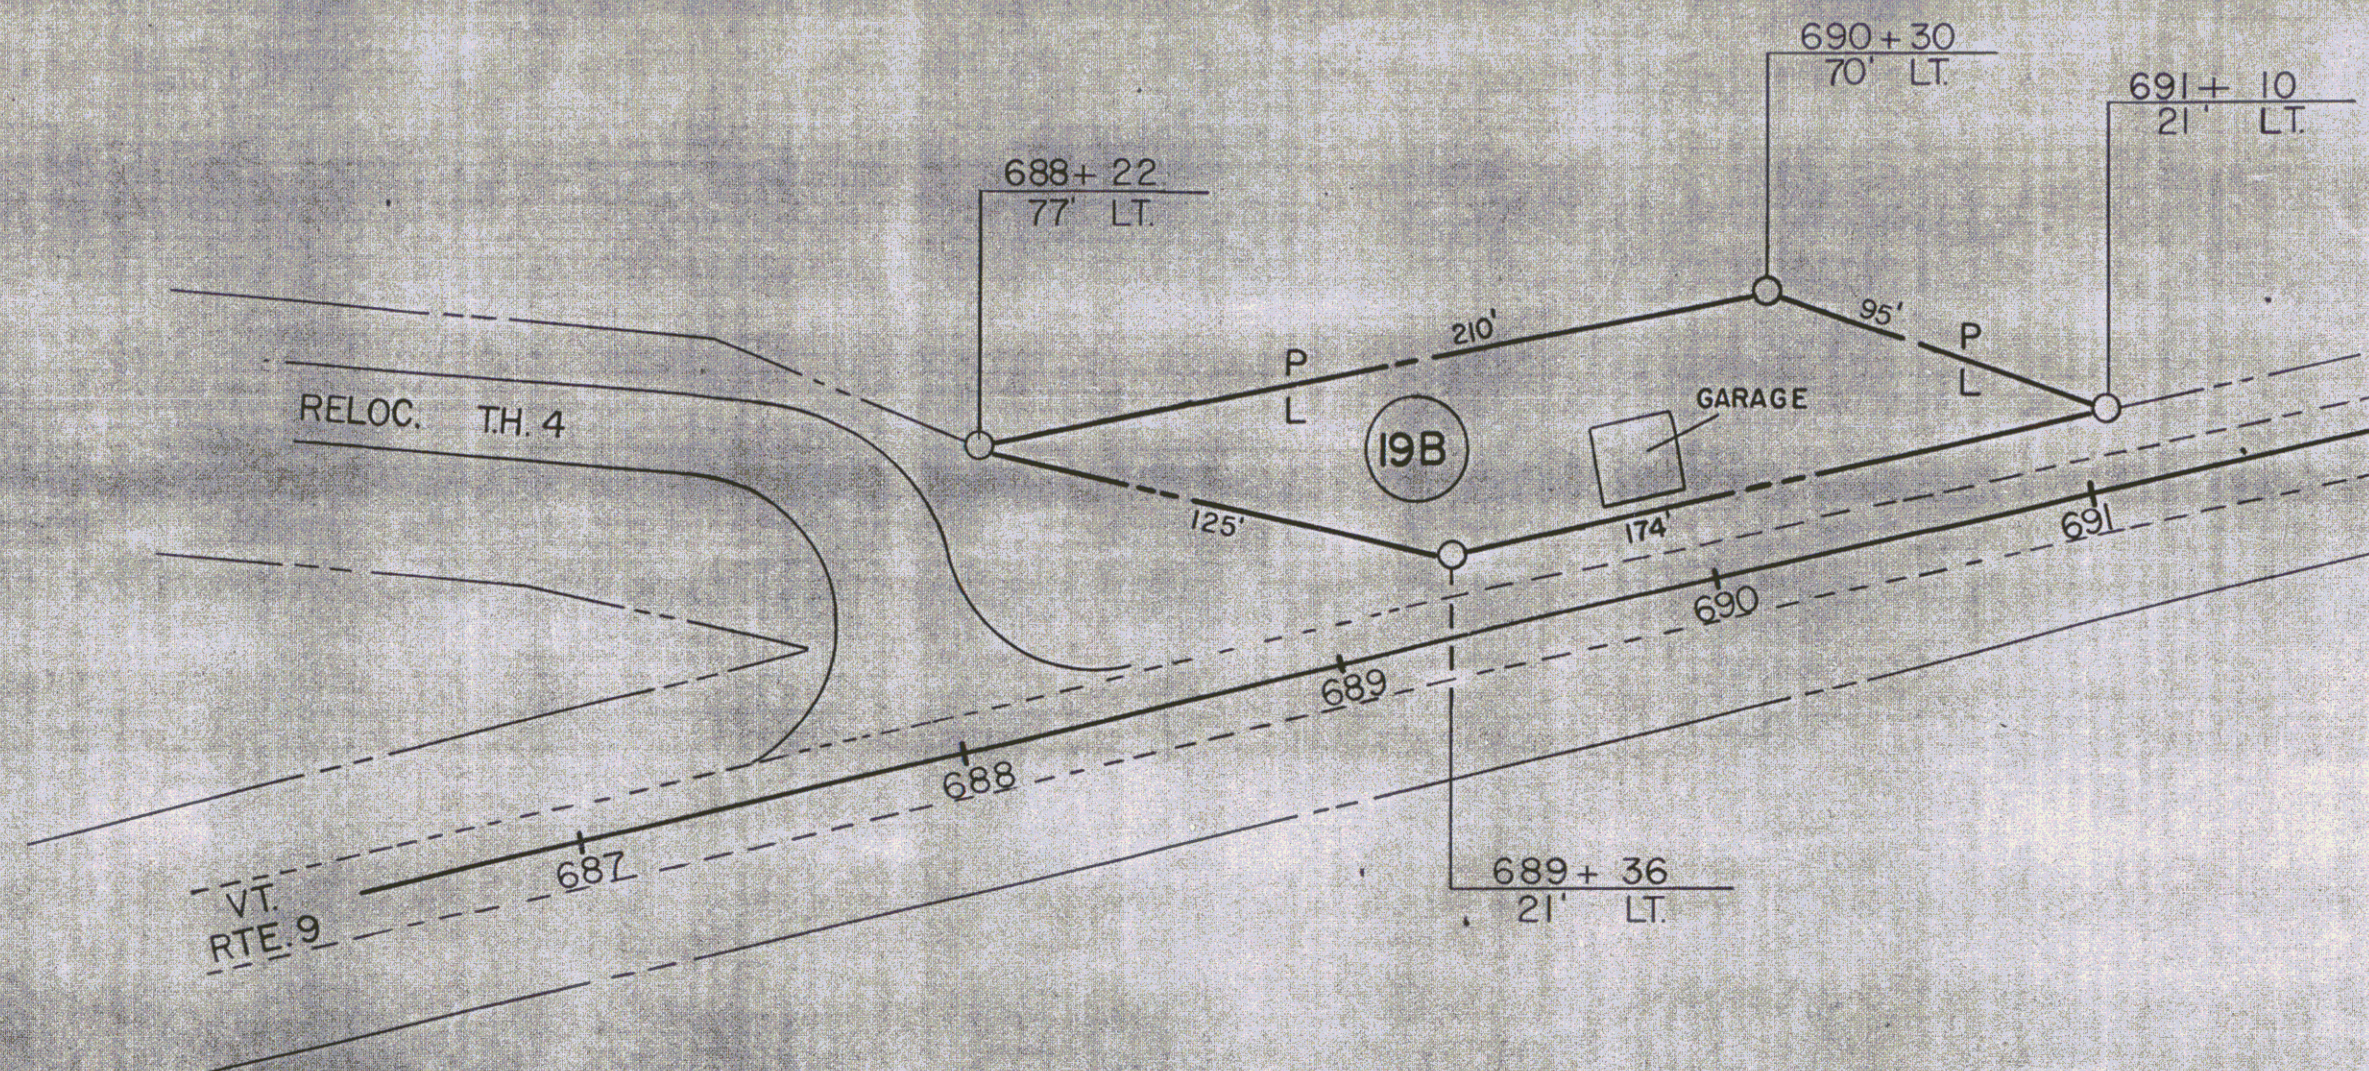


ROY D. & JENNIE A. HOOD  
PARCEL 19B 0.5A±  
STA. 688+22 LT - STA. 691+10 LT.  
RECORDED: WD, 4-29-74,  
TOWN OF SEARSBURG  
BK. II PG. 33

POOR ORIGINAL COPY

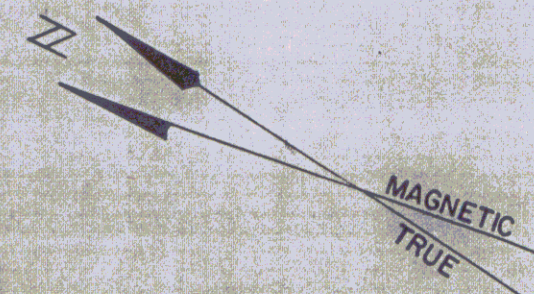

|                                       |              |              |
|---------------------------------------|--------------|--------------|
| STATE OF VERMONT<br>DEPT. OF HIGHWAYS |              |              |
| TOWN OF SEARSBURG                     |              |              |
| PROJECT SEARSBURG BP 010-1-7117       |              |              |
| APPROX. SCALE 1"= 50'                 | DATE 3/20/74 | DRAWN BY KMI |