
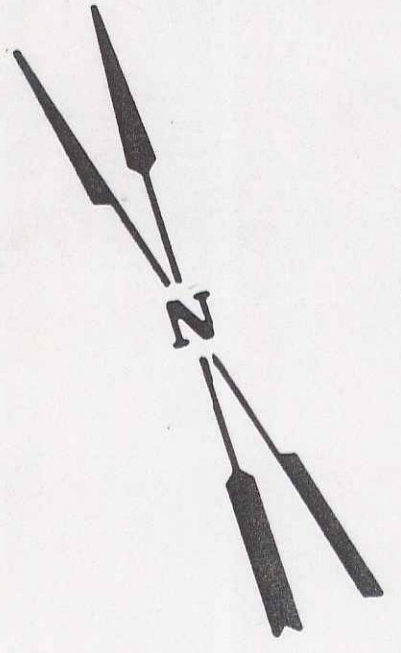
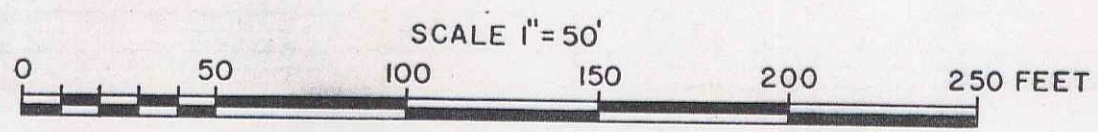


AQUIRED 1/3 INTEREST FROM EARL L. WELCH BY Q.C.D.O.E.
 RECORDED 12-2-57 IN BOOK 22, PAGE 266.
 AQUIRED 2/3 INTEREST FROM FRANCONIA PAPER CORP. BY
 CORP. W.D.O.E. RECORDED 1-24-58 IN BOOK 22, PAGE 267.
 STATE OF VERMONT TO TOWN OF GROTON
 BY QCD 5/21/79 IN BK 29/399-402

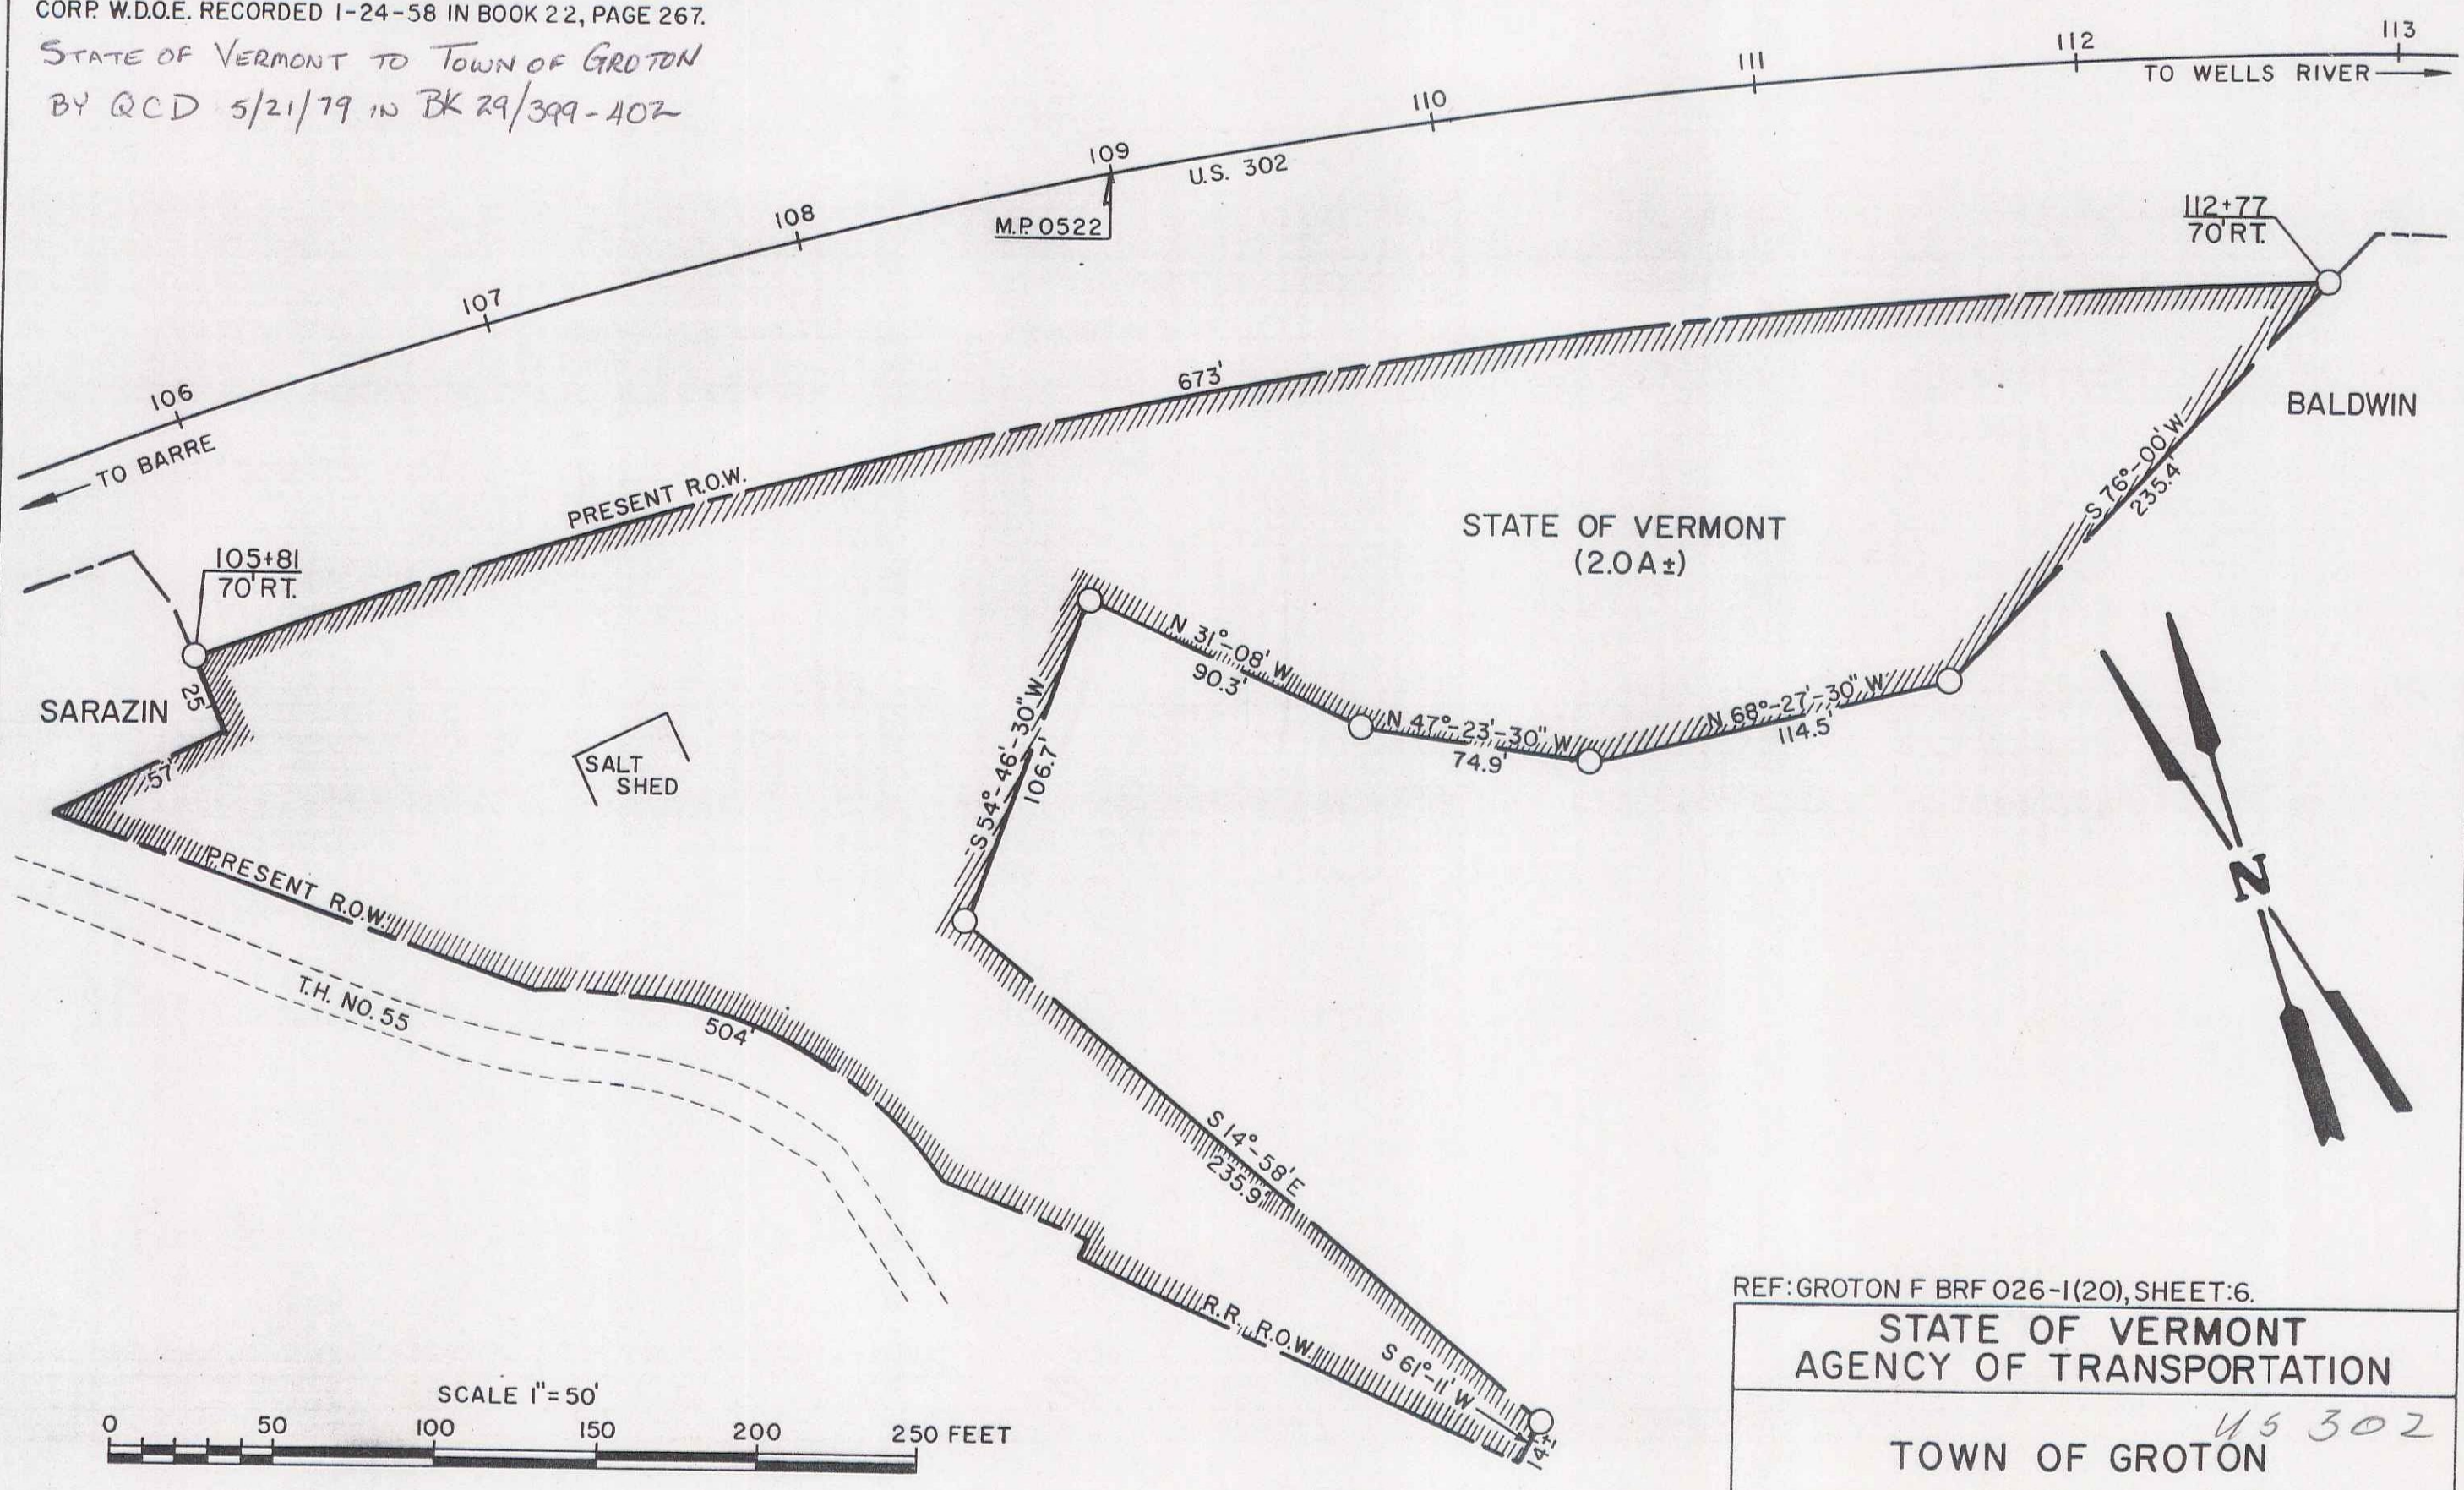

REF: GROTON F BR 026-1(20), SHEET: 6.		
STATE OF VERMONT AGENCY OF TRANSPORTATION		
TOWN OF GROTON <i>US 302</i>		
PROJECT <i>026-1(20)</i>	SHEET NAME <i>6A</i>	
APPROX. SCALE 1"=50'	DATE: 5-3-79	DRAWN BY S.J.B.

5