


BEGIN ROW PROJECT  
BRS 0285(2) STA. 272+00 CL

DATUM  
VERTICAL NGVD 1929  
HORIZONTAL N/A

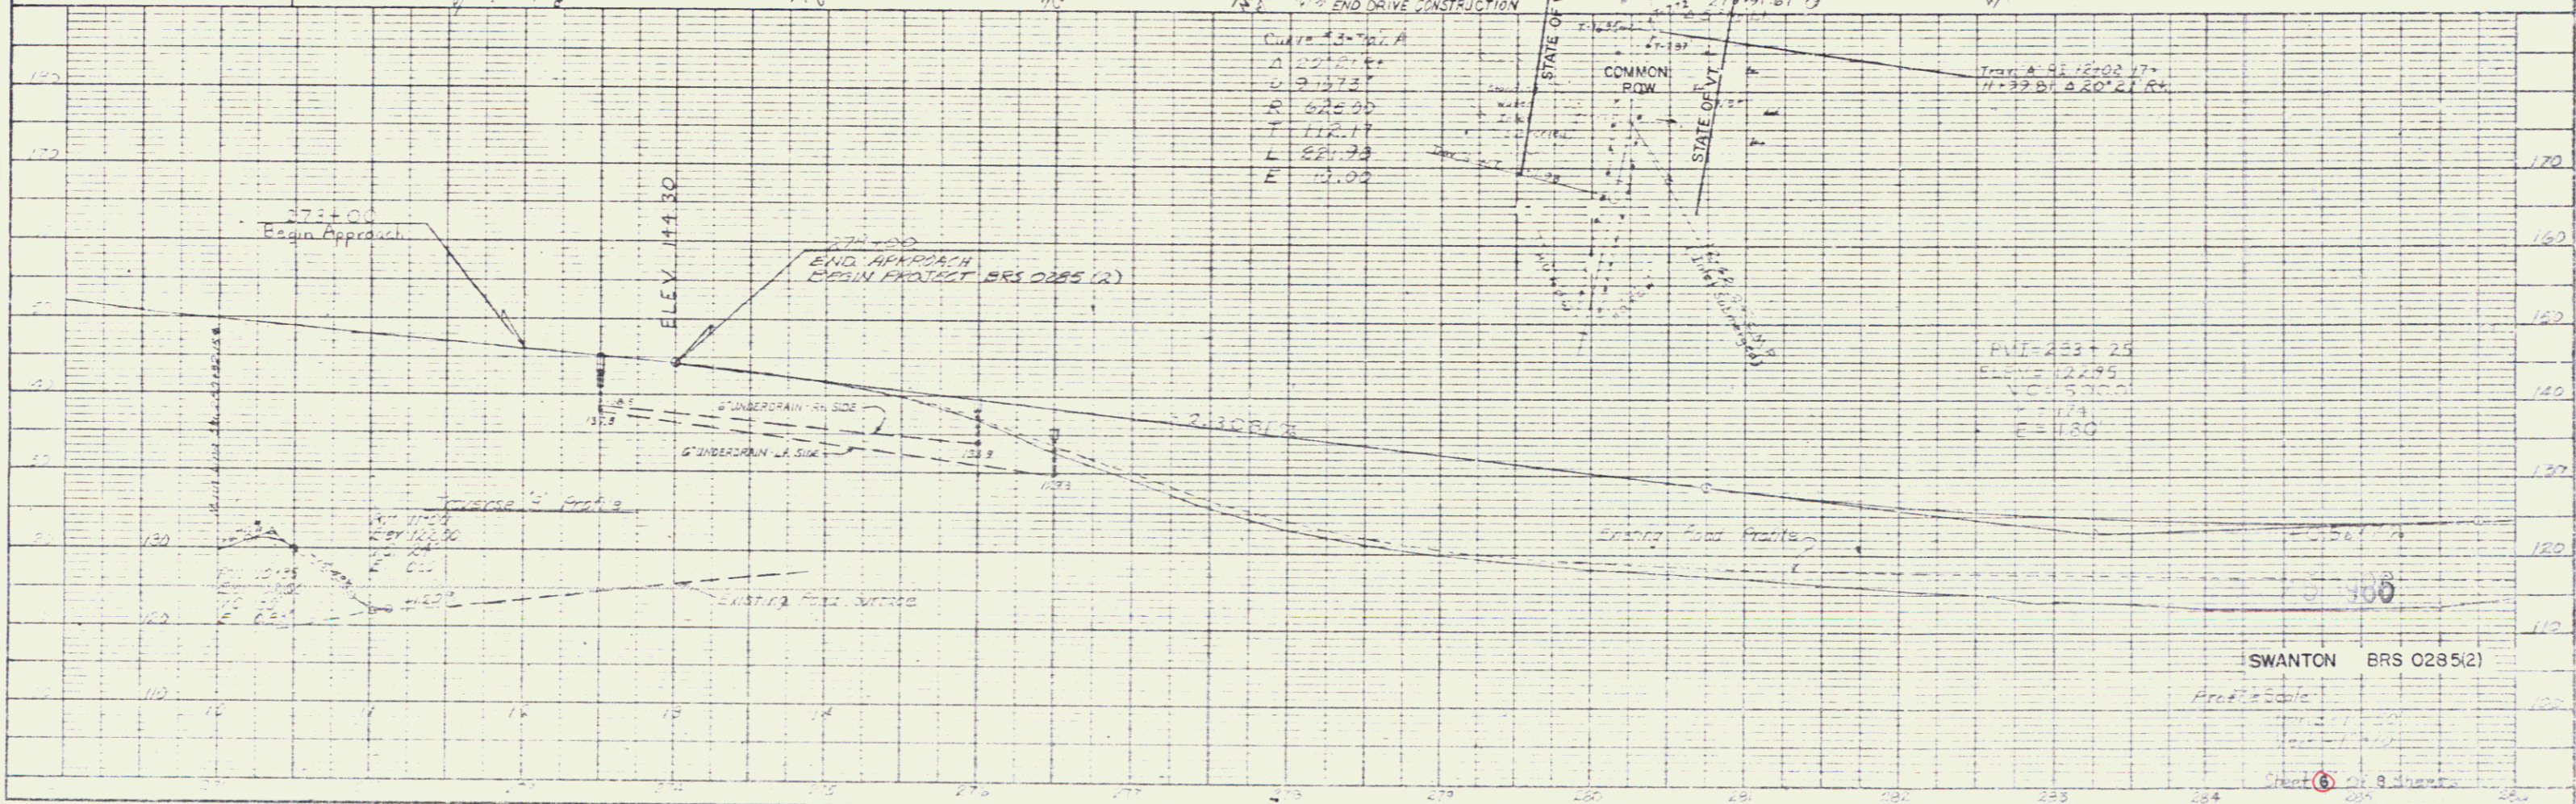

PLAN  
DATE BLOCK  
SCALE TO BE SHOWN

PROFILE  
DATE BLOCK  
SCALE TO BE SHOWN

SWANTON BRS 0285(2)