

STONE FILL TYPE I
302+50 - 302+50 P+


CONCRETE DRIVE
304+67.5 - (Paved)
305+07.5 - (Paved)
305+15 LT

EROSION MATTING
302+50 - 304+00 P+

SCRUBBYING EXISTING PAVEMENT
302+00 - 303+50


REMOVAL OF EXISTING BIT. CONC. PAVEMENT (COMMON EXC.)
303+50 - 304+50

PLAN
NOTES
1. SEE SHEET 7 OF 8
2. SEE SHEET 8 OF 8

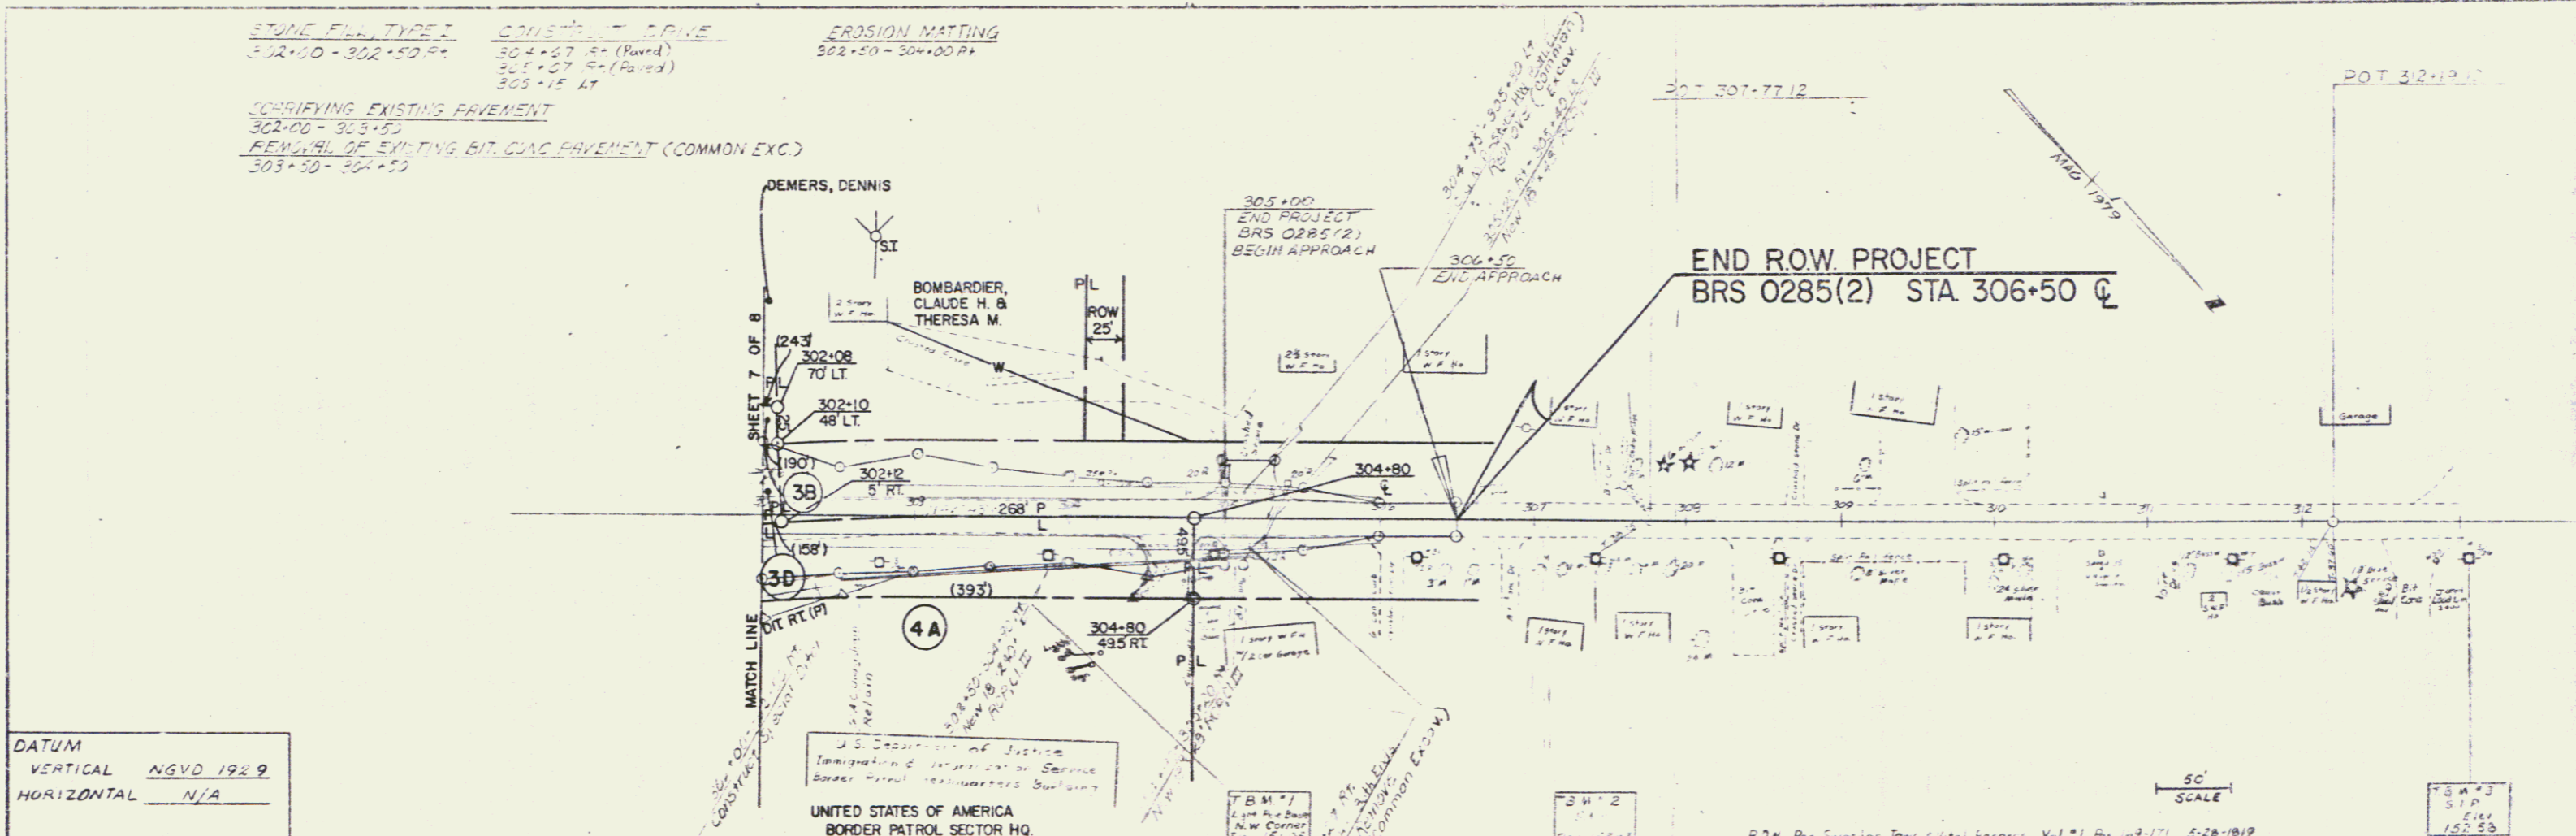

DATUM
VERTICAL NGVD 1929
HORIZONTAL N/A

PROFILE
NOTES
1. SEE SHEET 7 OF 8
2. SEE SHEET 8 OF 8

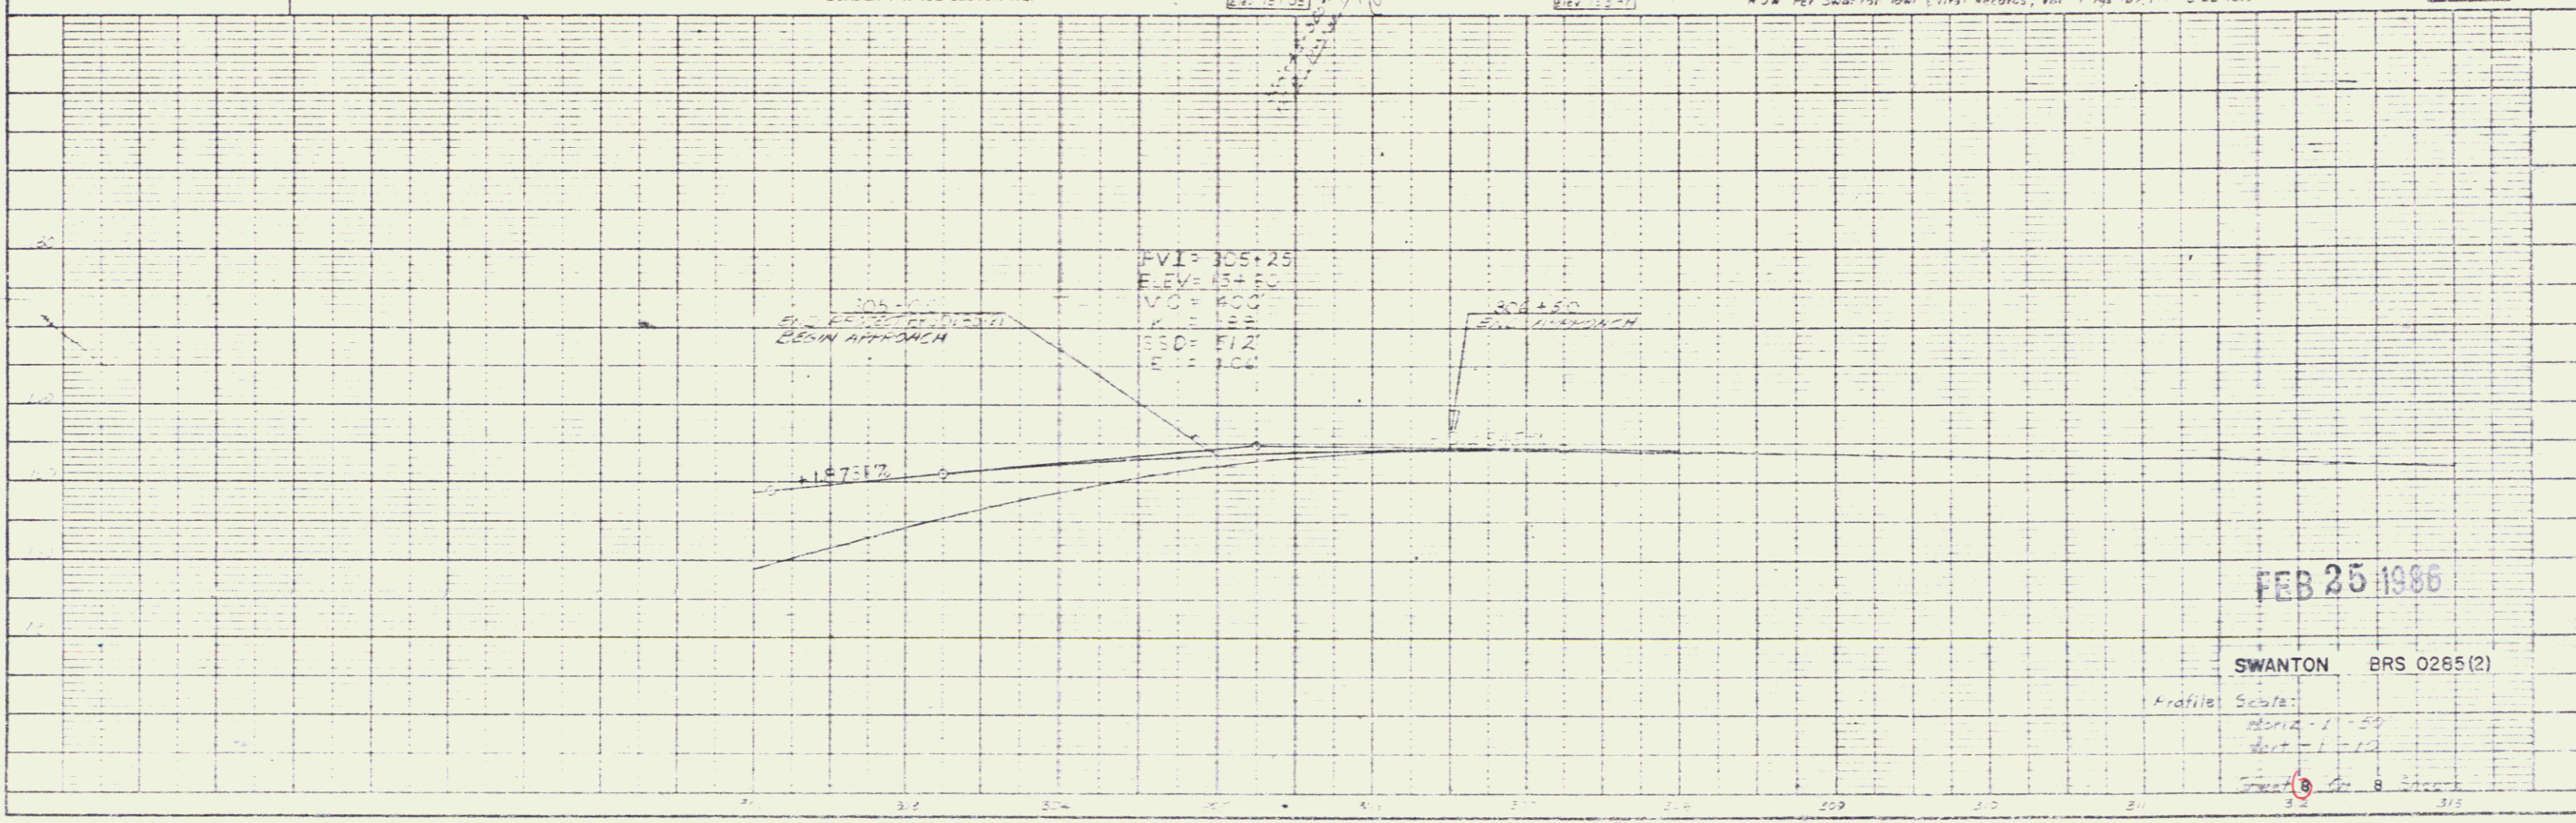

FEB 25 1986

SWANTON BRS 0285(2)

Profile Scale:
Horiz - 1" = 50'
Vert - 1" = 10'

PLAN PROFILE