
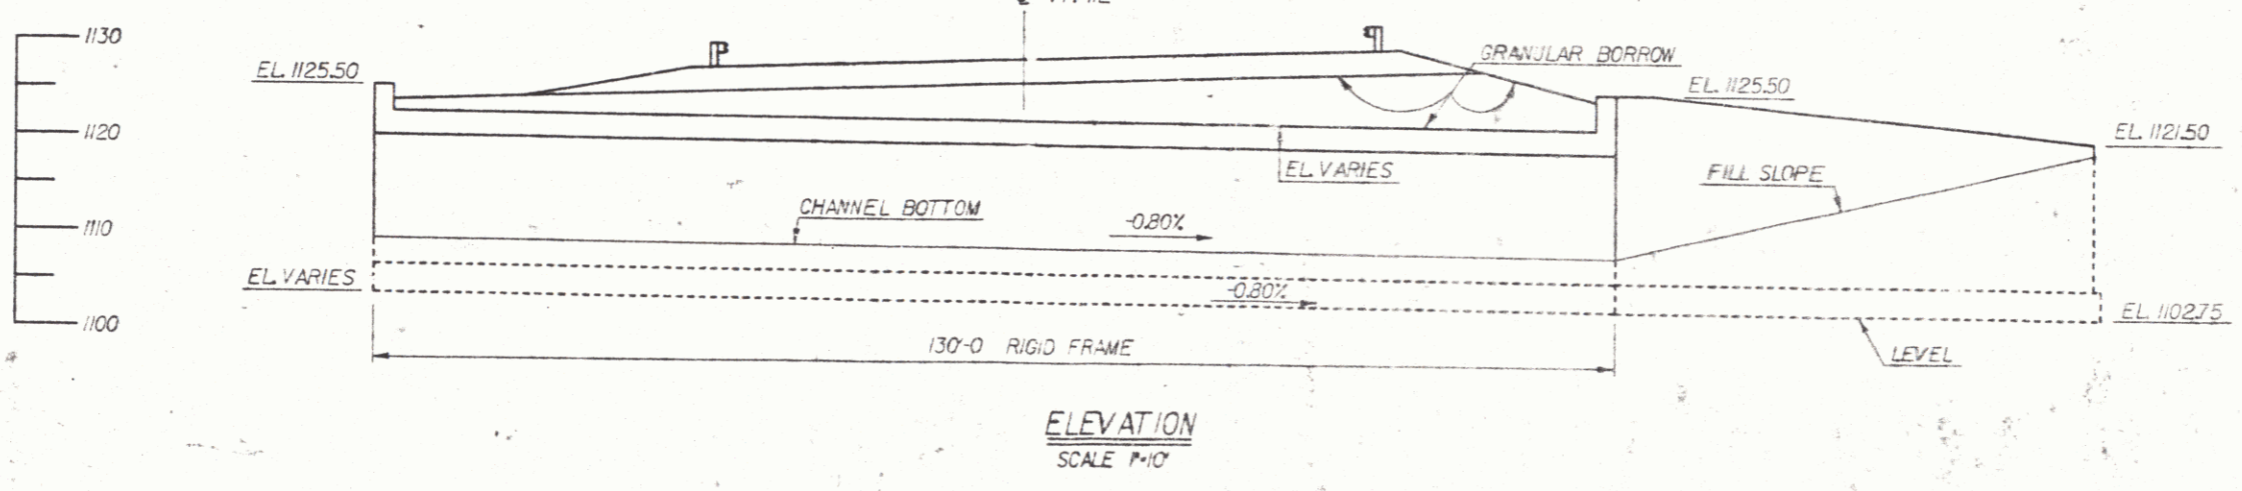


STRUCTURE LAYOUT TABLE						
WORK POINT	REV. VT. RTE. 112		CHANNEL LINE		TOP EL.	BOT. OF FTNG. EL.
	STATION	OFFSET	STATION	OFFSET		
1	68+84.09	31.33' LT.	8+76.52	43.53' LT.	1118.50	1104.00
2	69+47.47	23.75' LT.	9+35.68	53.53' LT.	1125.50	1104.00
3	69+97.02	49.83' LT.	9+66.77	95.79' LT.	1125.50	1103.78
4	69+91.50	0.0'	9+84.46	48.92' LT.	1122.61	1103.61
5	70+68.11	0.0'	10+50.36	87.87' LT.	1122.11	1103.11
6	70+57.62	49.0' RT.	10+68.18	41.0' LT.	1125.50	1102.94
7	71+04.30	28.47' RT.	10+96.20	83.55' LT.	1125.50	1102.75
8	71+56.76	36.03' RT.	11+44.39	105.62' LT.	1121.50	1102.75
9	70+68.02	75.00' RT.	10+90.91	24.79' LT.	1121.50	1102.94

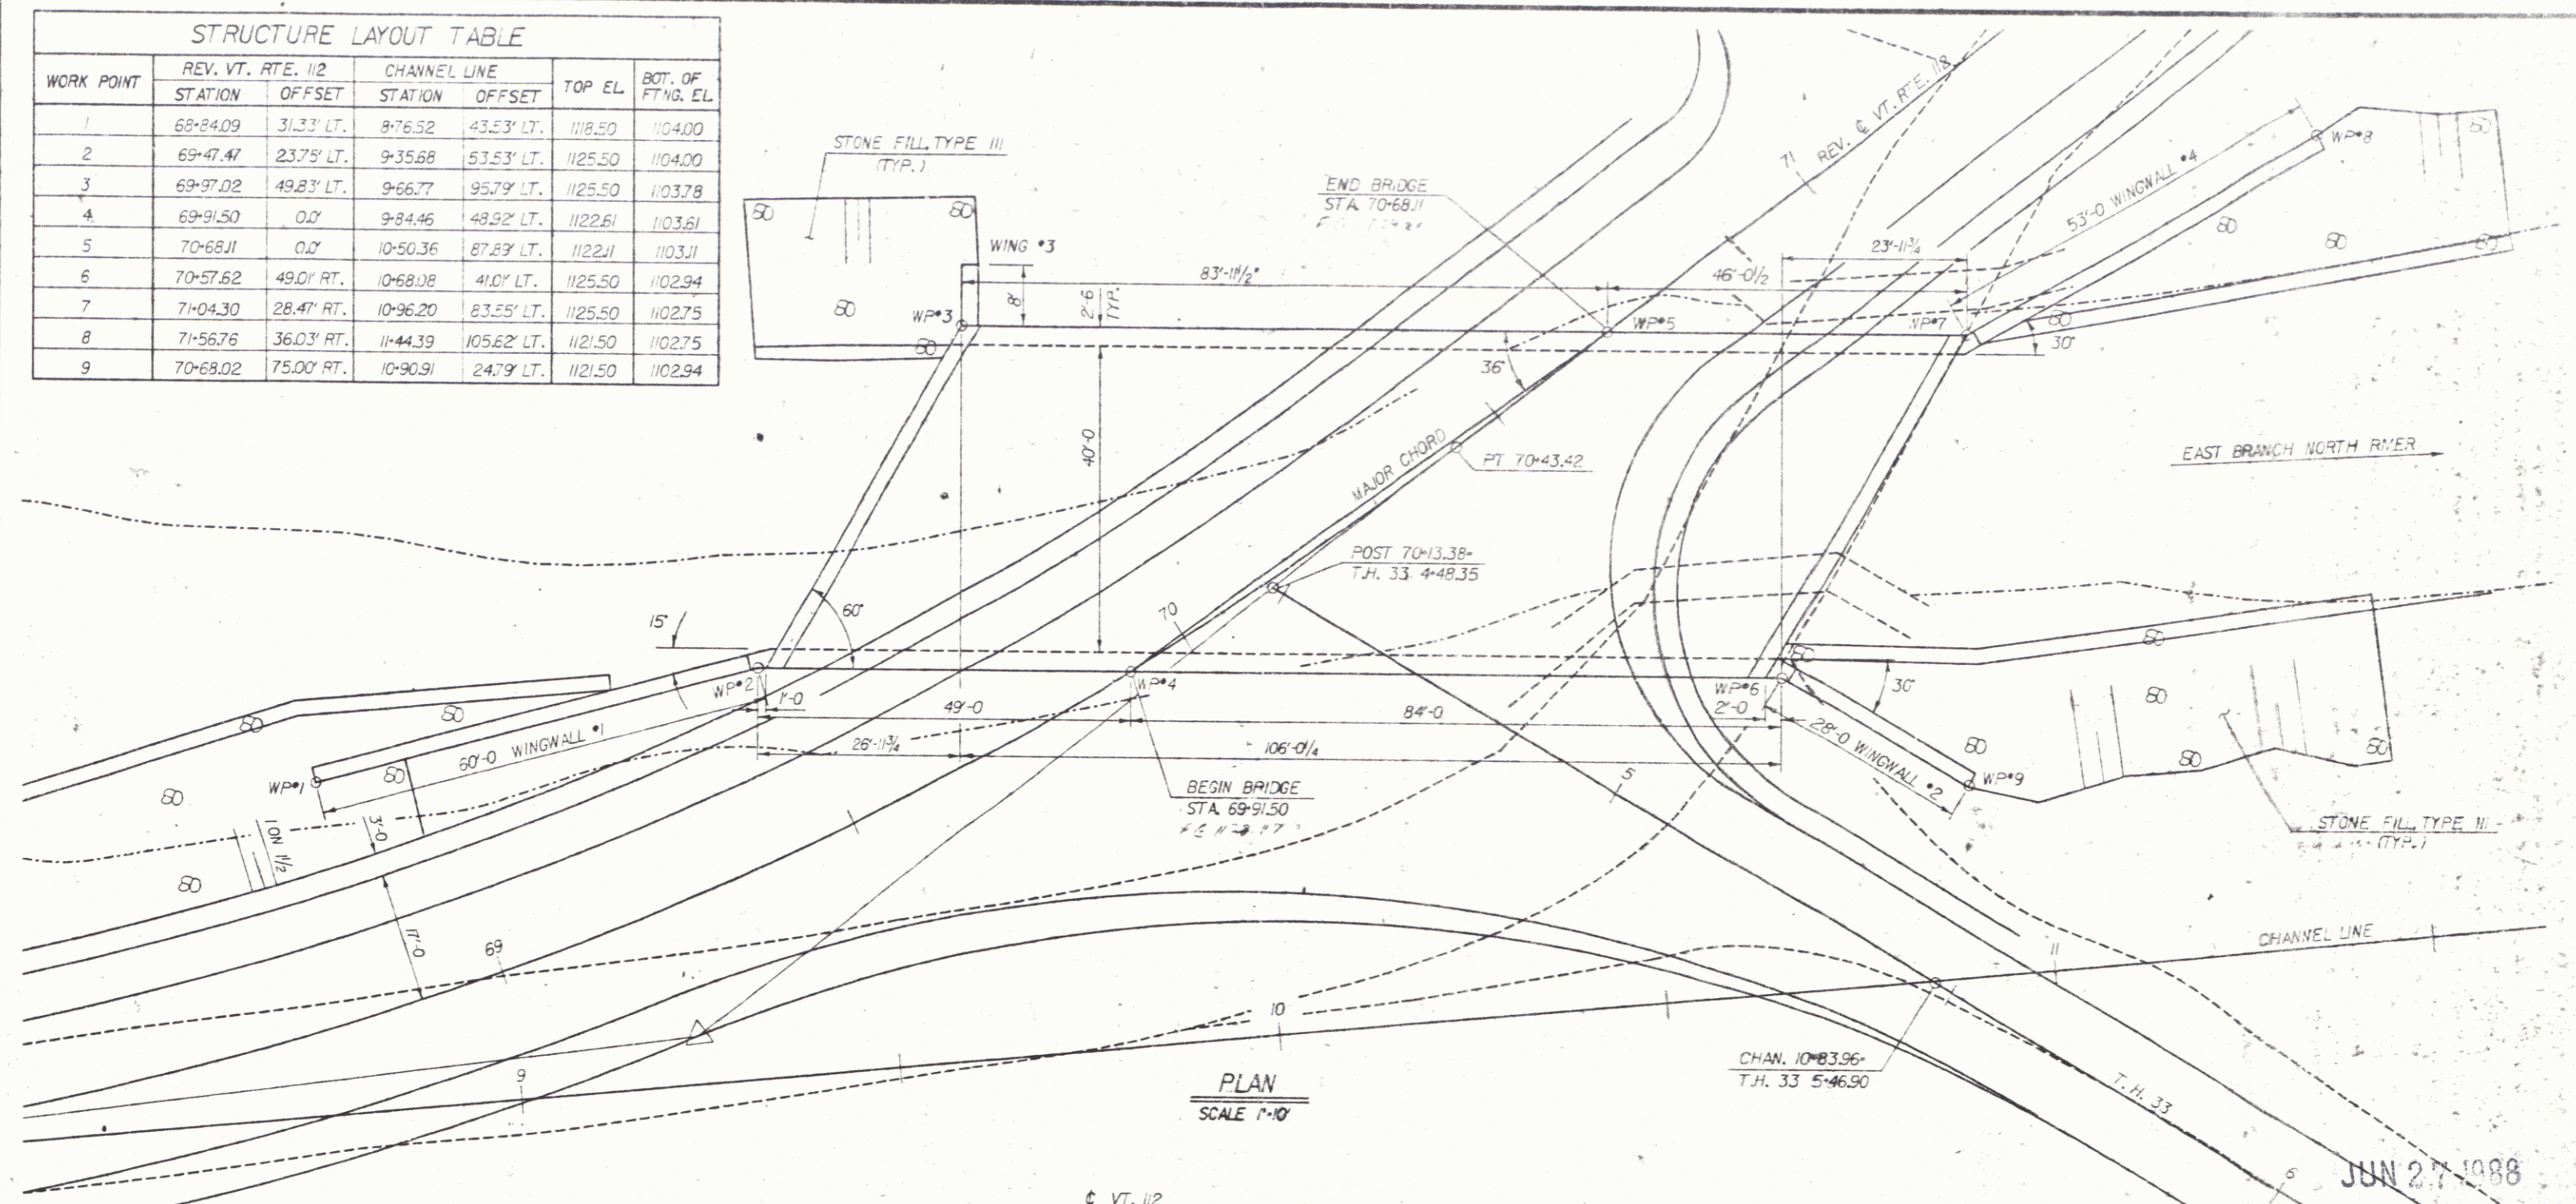

ROW PLANS

STATE OF VERMONT
AGENCY OF TRANSPORTATION

Town of HALIFAX	Bridge No.
Highway No. VT. RTE. 112	Log. Sta.
PLAN AND ELEVATION	
VT. RTE. 112 OVER THE EAST BRANCH NORTH RIVER	
Designed By	Drawn By
Checked By	Bridge Design Supervisor
G. V. SPILAK	R. S. HALIFAX
Date 11-85	Date 8-85

HALIFAX
F 013-1(2)S
SHEET 4 OF 7

JUN 27 1988

BR-4

11-85

4