


INDEX OF SHEETS

STATE OF VERMONT AGENCY OF TRANSPORTATION



PROPOSED IMPROVEMENT TOWN OF TOPSHAM COUNTY OF ORANGE VT. ROUTE 25

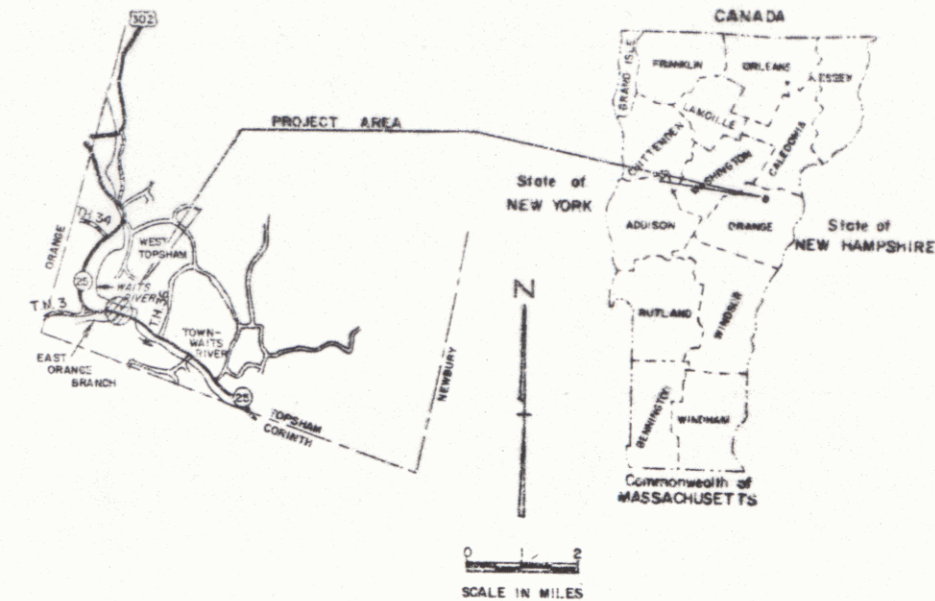

R.O.W. PLANS


ALL DRIVES AS INDICATED ON PLANS ARE SUBJECT TO PERMITS PURSUANT TO TITLE 19, SECTION 43, V.S.A.

BEGINNING AT A POINT APPROXIMATELY 2.786 MILES NORTHWESTERLY OF THE CORINTH-TOPSHAM TOWN LINE AND EXTENDING SOUTHEASTERLY 0.066 MILES.

LENGTH OF ROADWAY 306.00 FEET= 0.058 MILES
LENGTH OF BRIDGE 44.00 FEET= 0.008 MILES
LENGTH OF PROJECT 350.00 FEET= 0.066 MILES
LENGTH OF R.O.W. PROJECT 500.00 FEET= 0.095 MILES

PROJECT CONSISTS OF REPLACEMENT OF BRIDGE # 17 AND RECONSTRUCTION OF ROADWAY, APPROACHES, GRADING, DRAINAGE, AND PAVING.

END R.O.W. PROJECT
F-BRF 031-1(4)S STA. 217+00 C

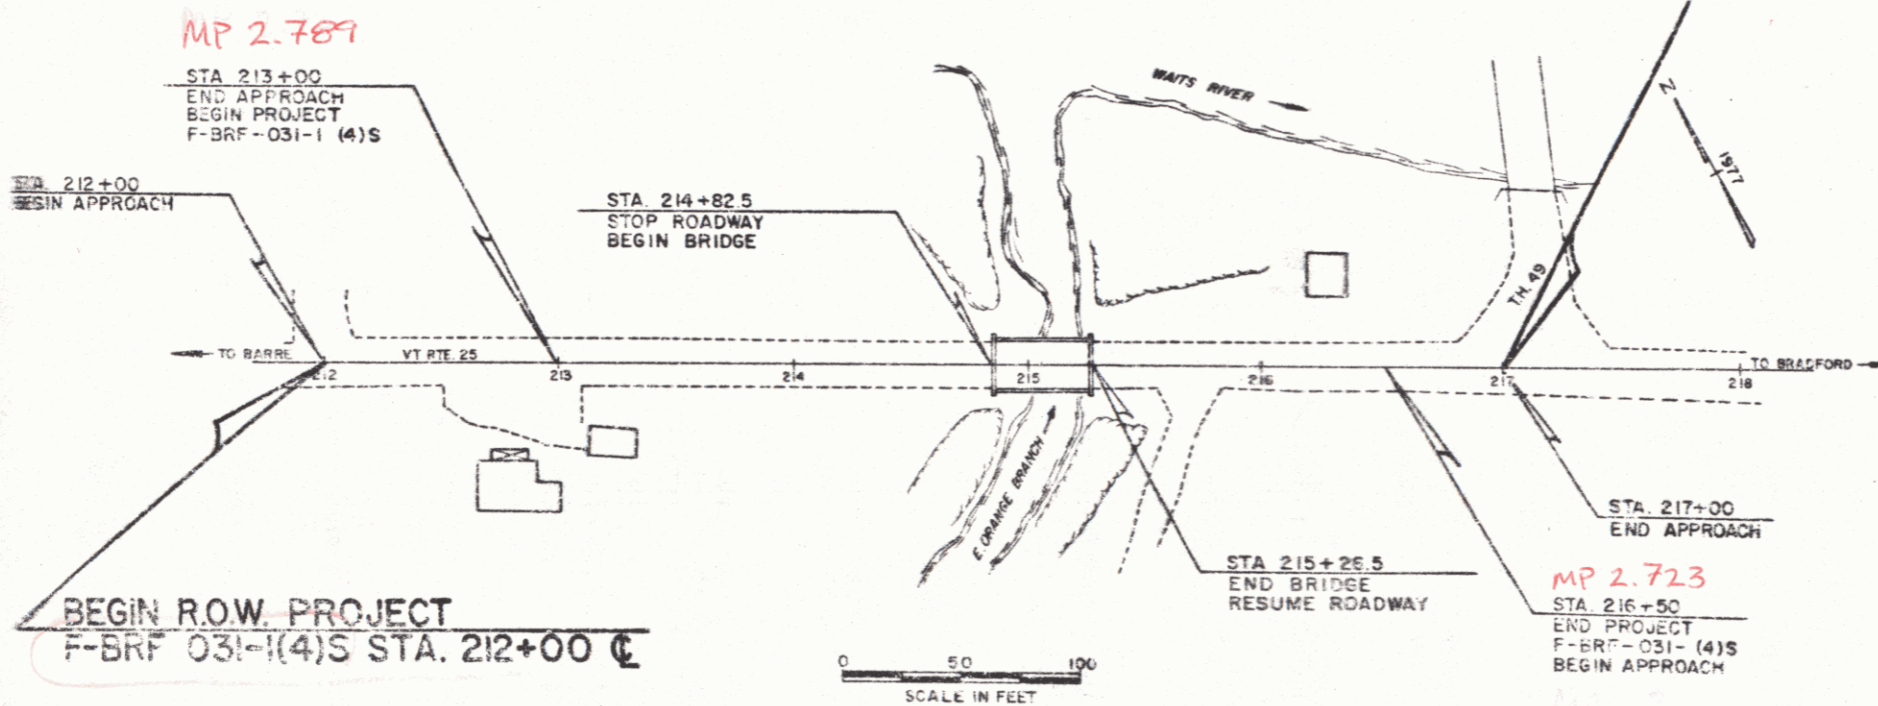

Per: 77B634

- CONVENTIONAL SIGNS
- COUNTY LINE
 - TOWN LINE
 - LIMITS OF ACCESS
 - POINT OF ACCESS
 - FENCE LINE
 - STONE WALL
 - TRAVELED WAY
 - GUARD RAIL
 - RAILROAD
 - SURVEY LINE
 - CULVERT
 - POWER POLE
 - TELEPHONE POLE
 - TREES
 - CONTROL OF ACCESS
 - PROPERTY LINE
 - R.O.W. TAKING LINE
 - SLOPE RIGHTS
 - TOP IN CUT
 - TOE OF SLOPE

datum
VERTICAL N.G.V.D. '929
HORIZONTAL N/A

JAN 4 1987

PROJECT PROCESSED UNDER
SECONDARY ROAD PLAN

These plans are subject to such engineering changes as may be required by the Federal Highway Administration or the Director of Engineering and Construction.

Construction is to be carried on in accordance with these plans and the Standard Specifications for Highway and Bridge Construction, dated March, 1976, as approved by the Federal Highway Administration on October 27, 1976 for use on this project, including all subsequent revisions and such revised specifications and special provisions as are incorporated in these plans.

SUBMITTED BY ORDER OF THE STATE TRANSPORTATION BOARD

APPROVED: *S.J. [Signature]* DATE: 6-20-84

DIRECTOR OF ENGINEERING AND CONSTRUCTION

DEPARTMENT OF TRANSPORTATION
FEDERAL HIGHWAY ADMINISTRATION

APPROVED: _____ DATE: _____

DIVISION ADMINISTRATOR

APPROVED: *[Signature]* DATE: 6-20-84

CHIEF, PROPERTY ADMINISTRATION

PROJECT TOPSHAM

NO. F-BRF 031-1(4)S

SHEET 1 OF 5 SHEETS

S.P.S. 6/11/76