


INDEX OF SHEETS

# STATE OF VERMONT AGENCY OF TRANSPORTATION



## PROPOSED IMPROVEMENT TOWN OF TOPSHAM COUNTY OF ORANGE VT. ROUTE 25

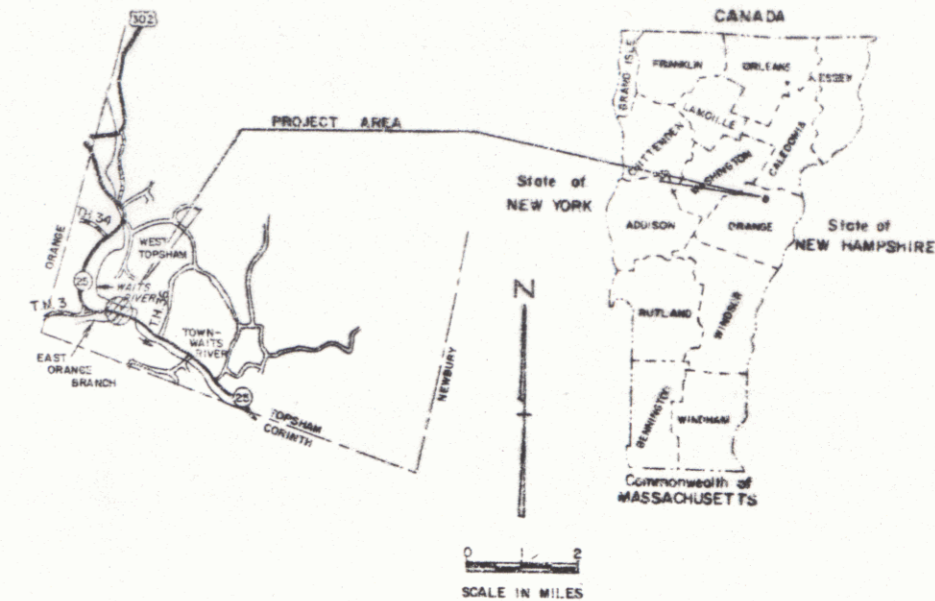

R.O.W. PLANS


ALL DRIVES AS INDICATED ON PLANS ARE SUBJECT TO PERMITS PURSUANT TO TITLE 19, SECTION 43, V.S.A.

BEGINNING AT A POINT APPROXIMATELY 2.786 MILES NORTHWESTERLY OF THE CORINTH-TOPSHAM TOWN LINE AND EXTENDING SOUTHEASTERLY 0.066 MILES.

LENGTH OF ROADWAY 306.00 FEET= 0.058 MILES  
LENGTH OF BRIDGE 44.00 FEET= 0.008 MILES  
LENGTH OF PROJECT 350.00 FEET= 0.066 MILES  
LENGTH OF R.O.W. PROJECT 500.00 FEET= 0.095 MILES

PROJECT CONSISTS OF REPLACEMENT OF BRIDGE # 17 AND RECONSTRUCTION OF ROADWAY, APPROACHES, GRADING, DRAINAGE, AND PAVING.

END R.O.W. PROJECT  
F-BRF 031-1(4)S STA. 217+00 C

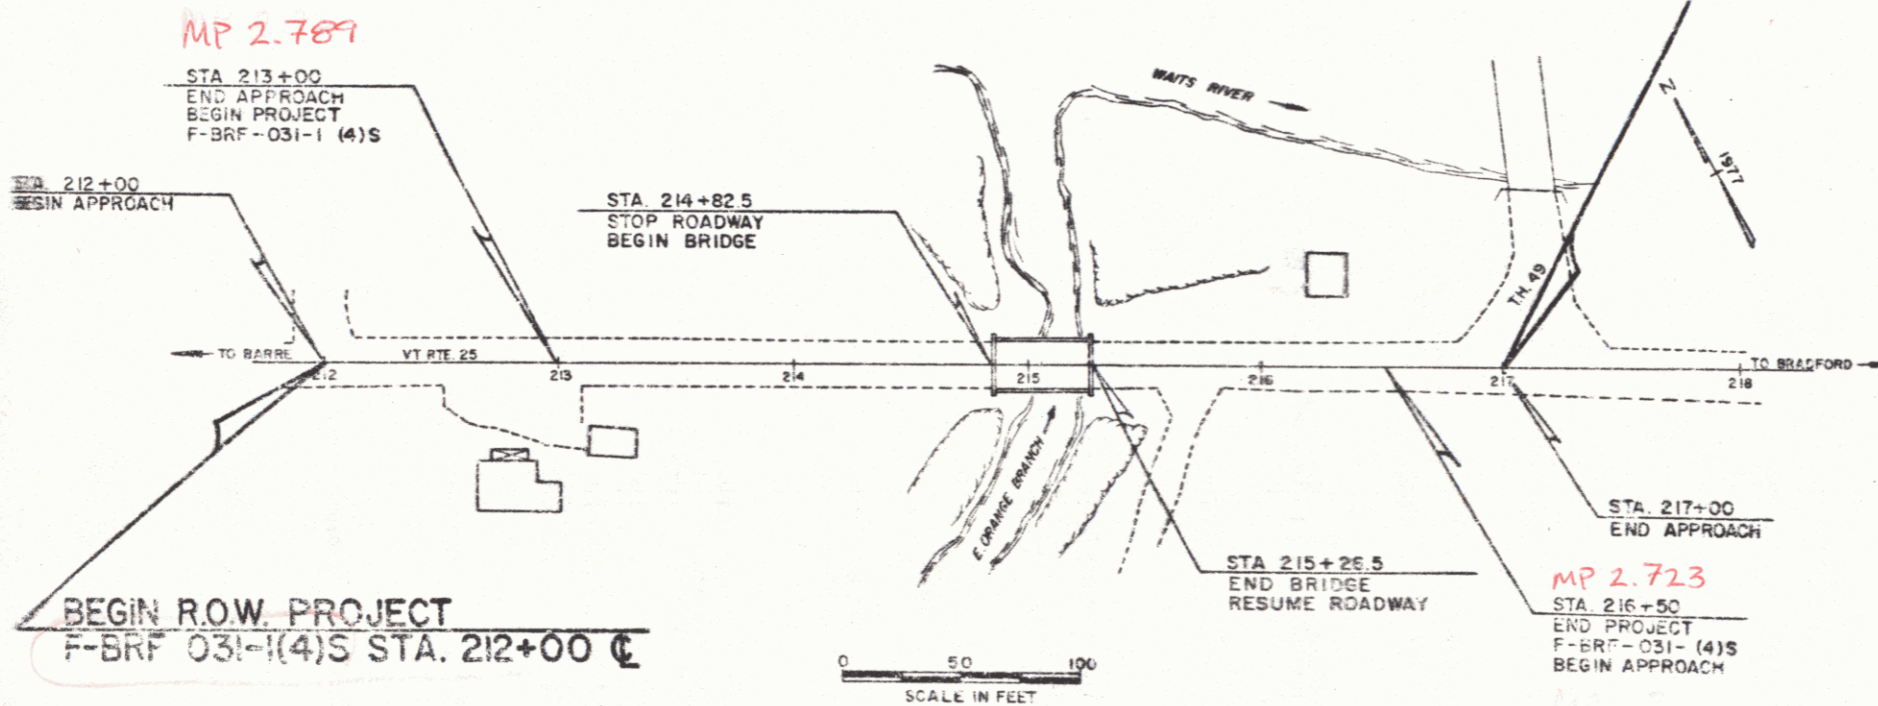

*Per: 77B634*

- CONVENTIONAL SIGNS
- COUNTY LINE
  - TOWN LINE
  - LIMITS OF ACCESS
  - POINT OF ACCESS
  - FENCE LINE
  - STONE WALL
  - TRAVELED WAY
  - GUARD RAIL
  - RAILROAD
  - SURVEY LINE
  - CULVERT
  - POWER POLE
  - TELEPHONE POLE
  - TREES
  - CONTROL OF ACCESS
  - PROPERTY LINE
  - R.O.W. TAKING LINE
  - SLOPE RIGHTS
  - TOP IN CUT
  - TOE OF SLOPE

VERTICAL N.G.V.D. '929  
HORIZONTAL N/A

JAN 4 1987

PROJECT PROCESSED UNDER  
SECONDARY ROAD PLAN

These plans are subject to such engineering changes as may be required by the Federal Highway Administration or the Director of Engineering and Construction.

Construction is to be carried on in accordance with these plans and the Standard Specifications for Highway and Bridge Construction, dated March, 1976, as approved by the Federal Highway Administration on October 27, 1976 for use on this project, including all subsequent revisions and such revised specifications and special provisions as are incorporated in these plans.

SUBMITTED BY ORDER OF THE STATE TRANSPORTATION BOARD

APPROVED: *S.J. [Signature]* DATE: 6-20-84

DIRECTOR OF ENGINEERING AND CONSTRUCTION

DEPARTMENT OF TRANSPORTATION

FEDERAL HIGHWAY ADMINISTRATION

APPROVED: \_\_\_\_\_ DATE: \_\_\_\_\_

DIVISION ADMINISTRATOR

APPROVED: *[Signature]* DATE: 6-20-84

CHIEF, PROPERTY ADMINISTRATION

PROJECT TOPSHAM

NO. F-BRF 031-1(4)S

SHEET 1 OF 5 SHEETS

S.P.S. 6/11/76

STATE OF VERMONT  
AGENCY OF TRANSPORTATION  
RIGHT-OF-WAY PLANS  
DETAIL SHEET

TABLE OF PROJECT PROPERTY ACQUISITION

PARCEL NO.	GRANTOR	SHEET NO.	BEGINNING STATION	ENDING STATION	TAKING	REM.	RIGHTS	TITLE TAKEN	DATE	TOWN OR CITY RECORDED	BK.	PG.	REMARKS
1A	Griffin, Bradley J. & Bridget R.	5	213+00 LI. 212+65 LI. 213+00 LI. 214+75 LI.	214+85 LI. 215+13 LI. 214+89 LI. 215+04 LI.	0.02 Ac.		CONST. EASE. (T) (0.06 Ac) SLOPE (T) (0.04 Ac) CHANNEL (P) (0.01 Ac)	W.D.	1/9/85	TOPSHAM	44	27-29	(1000 S.Ez.) (2670 S.Ez.) (1700 S.Ez.) (400 S.Ez.)
1B		5	212+00 E	215+13 E TOTAL	0.20 Ac. 0.22 Ac.		ALL R. T. & I.						WVY. EASE. VT. RTE. 25
2A	Pease, Leon W. & Delia A.	5	213+50 RT. 213+00 RT. 213+28 RT. 213+34 RT. 213+87 RT. 214+72 RT.	214+85 RT. 213+50 RT. 215+05 RT. 214+88 RT. 214+91 RT.	0.02 Ac.		DRIVE (T) SLOPE (T) (125 S.Ez.) CONST. EASE. (T) (0.18 Ac) SLOPE (T) (200 S.Ez.) CHANNEL (P) (90 S.Ez.)	W.D.	2/5/85	TOPSHAM	44	55-6	(1000 S.Ez.)  TEMPORARY BRIDGE & DETOUR
2B		5	212+00 E	215+13 E TOTAL	0.18 Ac. 0.20 Ac.		ALL R. T. & I.						WVY. EASE. VT. RTE. 25
3	KUNSA, THEODORE P., JR.	5	215+13 E 215+13 LI. 215+04 LI. 215+22 LI. 215+22 LI. 215+73 LI. 216+46 LI. 216+07 LI.	217+00 E 217+00 LI. 215+42 LI. 215+35 LI. 215+48 LI. 216+04 LI. 216+59 LI.	0.14 Ac.	0.50 Ac.	ALL R. T. & I.  CONST. EASE. (T) (0.02 Ac) CHANNEL (P) (120 S.Ez.) SLOPE (T) (115 S.Ez.) SLOPE (T) (40 S.Ez.) SLOPE (T) (15 S.Ez.) DRIVE (T)	W.D.	12/21/84	TOPSHAM	44	21-2	WVY. EASE. VT. RTE. 25  (750 S.Ez.)
4	Limlaw, Edward E. & Hazel W.	5	215+05 RT. 214+57 RT. 215+17 RT. 215+16 RT. 216+12 RT. 216+15 RT. 216+23 RT.	217+00 E 216+50 RT. 215+30 RT. 216+05 RT. 216+85 RT. 217+00 RT.	0.14 Ac.		ALL R. T. & I. CONST. EASE. (T) (0.23 Ac) CHANNEL (P) (80 S.Ez.) SLOPE (T) (0.02 Ac) DRIVE (T) SLOPE (T) (0.02 Ac) CONST. EASE. (T) (0.02 Ac)	W.D.	5/1/85	TOPSHAM	44	78-79	WVY. EASE. VT. RTE. 25 TEMPORARY BRIDGE & DETOUR  (1000 S.Ez.) (1000 S.Ez.) (700 S.Ez.)

TABLE OF REVISIONS

REVISION NO.	SHEET NO.	DESCRIPTION OF REVISION	DATE	MADE BY	APPROVED BY
1	3,5	Parcel # 3 KUNSA, CHANGED SLOPE FROM T TO R PER C.O.# 6240	7-18-84	DEM	JAB
2	3,5	Parcel # 1 RES, TITLE CHANGE FROM DENNIS REED + KATHY DAVIDSON TO GRIFFIN, BRADLEY J. & BRIDGET R. PER C.O.# 6271	8-30-84	DEM	JAB
3	5	Parcel # 2 PEASE, Added Apple Tree SAVE To Plans Per C.O.# 6209	9-21-84	B.A.M.	J.P.M.
4	3,5	Parcel # 3, KUNSA, Added Drive & Rt. At Sta. 216+07.18. Per Revised Design & C.O.# 6310	9-27-84	B.A.M.	JAB
5	1-5	Proj., Channel Project Design From BNF TO BAF Per C.O.# 6348  Mylars To Design 1-31-85	10-20-84	B.A.M.	JAB

MADE BY: B.A.M. DATE: 8/18/84  
CHECKED BY: L.W.B. DATE: 8/18/84

DR. RT. - DRAINAGE RIGHT  
DT. RT. - DITCHING RIGHT  
CH. RT. - CHANNEL RIGHT  
DRIVE RT. - DRIVE RIGHT  
CL. RT. - CULVERT RIGHT  
⊖ - DEMOLITION OR REMOVAL  
W - WATER SOURCES

PRESENT R.O.W.  
--- TAKING WITHOUT ACCESS  
--- TAKING WITHOUT ACCESS ALONG PROPERTY LINES  
--- TAKING WITH ACCESS  
(P) PERMANENT EASEMENT  
(T) TEMPORARY EASEMENT

LEGEND  
--- CONST. EASE. --- CONST. EASEMENT  
SR --- SR --- SLOPE RIGHTS  
P --- P --- PROPERTY LINE  
--- TOP OF CUT  
--- TOE OF SLOPE

APPROVED: *Lawrence Blum* DATE: 8/22/85  
CHIEF OF PLANS & TITLES

JAN 4 1987

PROJECT: TOPSHAM  
NO. F-BRF 031-i(4)S  
SHEET 3 OF 5

STATE OF VERMONT  
AGENCY OF TRANSPORTATION  
RIGHT-OF-WAY PLANS  
DETAIL SHEET

TABLE OF PROJECT PROPERTY ACQUISITION

PARCEL NO.	GRANTOR	SHEET NO.	BEGINNING STATION	ENDING STATION	TAKING	REM.	RIGHTS	TITLE TAKEN	DATE	TOWN OR CITY RECORDED	BK.	PG.	REMARKS
5	TOPSHAM TELEPHONE CO., INC.												UTILITY
6	WASHINGTON ELECTRIC CO-OP, INC.												UTILITY

TABLE OF REVISIONS

REVISION NO.	SHEET NO.	DESCRIPTION OF REVISION	DATE	MADE BY	APPROVED BY

MADE BY: B.A.H. DATE 6/19/84  
 CHECKED BY: L.B.B. DATE 6/19/84

DR RT - DRAINAGE RIGHT  
 DT RT - DITCHING RIGHT  
 CH RT - CHANNEL RIGHT  
 DRIVE RT - DRIVE RIGHT  
 CUL. RT - CULVERT RIGHT  
 (D) - DEMOLITION OR REMOVAL  
 (W) - WATER SOURCES

PRESENT R.O.W.  
 // - // - TAKING WITHOUT ACCESS  
 // P - // - TAKING WITHOUT ACCESS ALONG PROPERTY LINES  
 - - - - - TAKING WITH ACCESS  
 (P) - PERMANENT EASEMENT  
 (T) - TEMPORARY EASEMENT

LEGEND  
 - - - - - CONST. EASE - - - - - CONST. EASEMENT  
 SR - SR - SLOPE RIGHTS  
 P - P - PROPERTY LINE  
 - Δ - Δ - TOP OF CUT  
 - O - O - TOP OF SLOPE

APPROVED Lester W. Blinn DATE 6/22/85  
 CHIEF OF PLANS & TITLES

JAN 4 1987

PROJECT TOPSHAM  
 NO. F-BRF 031-1(4) S  
 SHEET 4 OF 5

