

INDEX OF SHEETS

- 1 TITLE
- 2-3 TYPICAL
- 4-5 DETAIL
- 6-8 LAYOUT
- 9-10 PROFILE

STATE OF VERMONT
AGENCY OF TRANSPORTATION



PROPOSED IMPROVEMENT
TOWN OF TUNBRIDGE
COUNTY OF ORANGE
VT. RTE. 110


FAS

BEGINNING AT A POINT ON VERMONT ROUTE 110 IN THE TOWN OF TUNBRIDGE 1.602 MILES NORTHERLY OF THE ROYALTON-TUNBRIDGE TOWN LINE AND EXTENDING NORTHERLY 0.249 MILES

LENGTH OF ROADWAY 9774.6 FT. = 1.865 MILES
LENGTH OF BRIDGE 1225.4 FT. = 0.231 MILES
LENGTH OF PROJECT 11000.0 FT. = 2.096 MILES
LENGTH OF R.O.W. PROJ. 13100.0 FT. = 2.489 MILES

R.O.W. PLANS

ALL DRIVES AS INDICATED ON PLANS ARE SUBJECT TO PERMITS PURSUANT TO TITLE 19, SECTION 43, V.S.A.

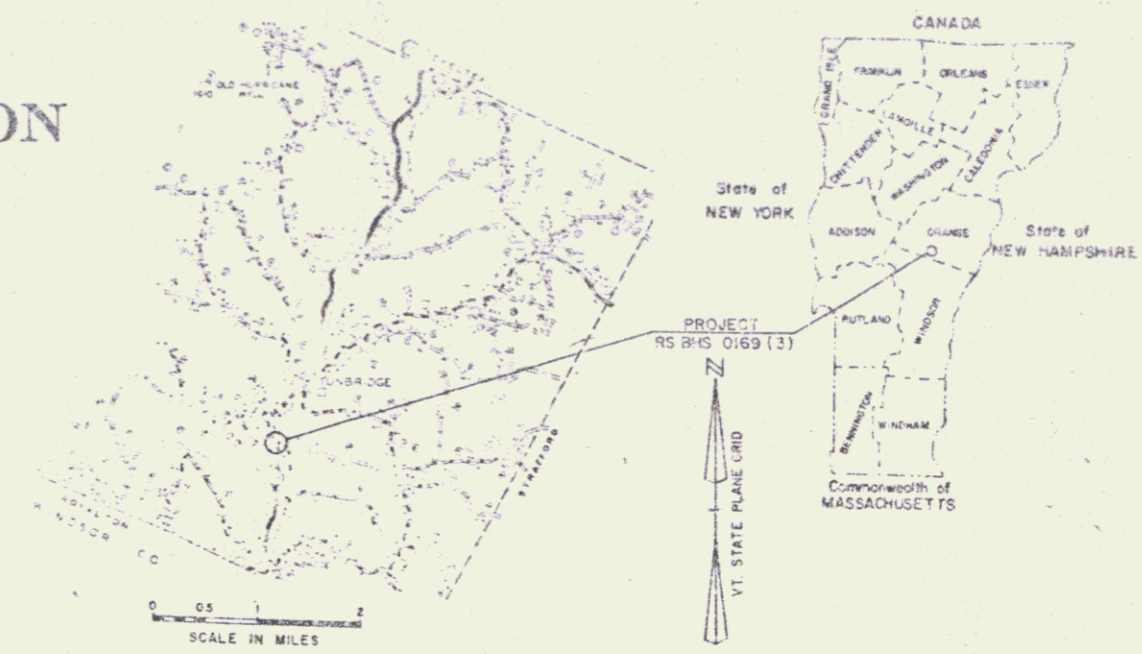



PROJECT DESCRIPTION

WORK TO BE PERFORMED UNDER THIS PROJECT INCLUDES REMOVAL OF EXISTING BRIDGE. NEW CONSTRUCTION CONSISTS OF BUILDING A NEW BRIDGE AND APPROACHES ON IMPROVED ALIGNMENT. APPROACH WORK CONSISTS OF GRADING, DRAINAGE, SUBBASE, PAVEMENT & GUARD RAIL.

CONVENTIONAL SIGNS

COUNTY LINE	---
TOWN LINE	---
LIMITS OF ACCESS	---
POINT OF ACCESS	X
FENCE LINE	---
STONE WALL	---
TRAVELED RD.	---
GUARD RAIL	---
RAILROAD	---
SURVEY LINE	---
CULVERT	---
POWER POLE	○
TELEPHONE POLE	○
TREES	○
CONTROL OF ACCESS	---
PROPERTY LINE	---
R.O.W. TAKING LINE	---
SLOPE RIGHTS	SR
TOP OF CUT	---
TOE OF SLOPE	---

DATUM
VERTICAL 1970 1922
HORIZONTAL N/A

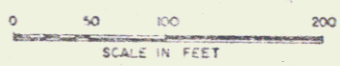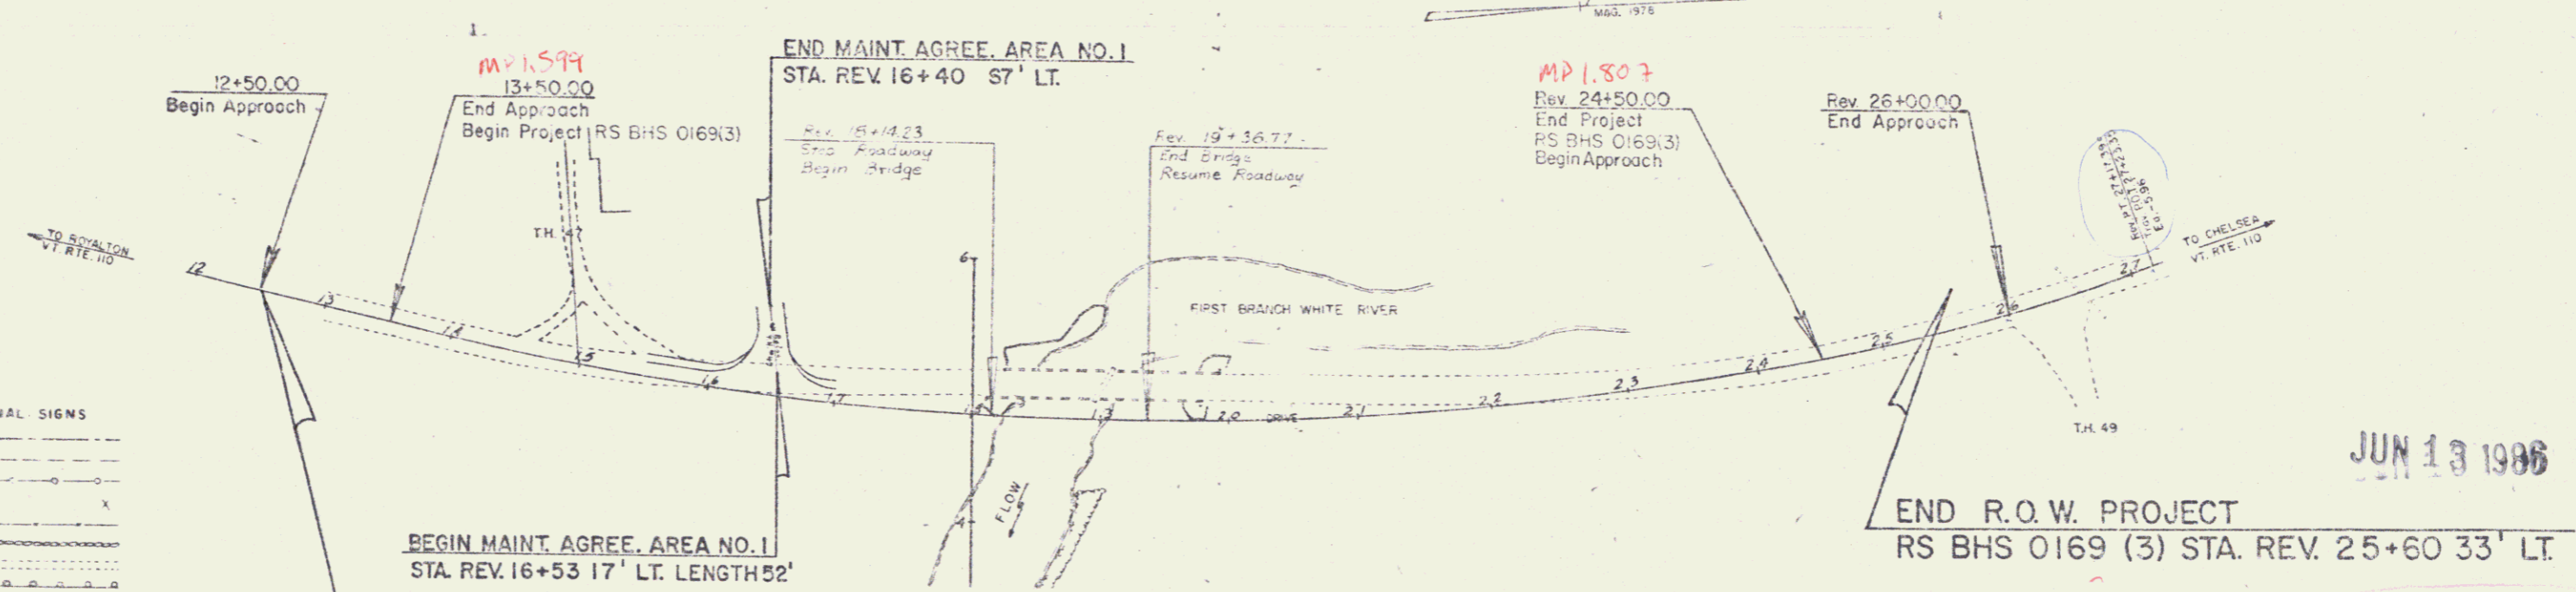

JUN 13 1986

END R.O.W. PROJECT
RS BHS 0169 (3) STA. REV. 25+60 33' LT.

These plans are subject to such engineering changes as may be required by the Federal Highway Administration or the Director of Engineering and Construction.
Construction is to be carried on in accordance with these plans and the Standard Specifications for Highway and Bridge Construction dated March, 1976, as approved by the Federal Highway Administration on October 27, 1976, for use on this project, including all subsequent revisions and such revised specifications and special provisions as are incorporated in those plans.

Submitted by ORDER OF THE STATE TRANSPORTATION BOARD
Din# 77B035
APPROVED: S. J. G. P. DATE 11-1-84
DIRECTOR OF ENGINEERING AND CONSTRUCTION
APPROVED: W. R. J. DATE 10-30-84
CHIEF PROPERTY ADMINISTRATION
PROJ. TUNBRIDGE
NO. RS BHS 0169 (3)
SHEET 1 OF 10
D:G SRS 12/10/84