

RESEARCH DRAWER SET

INDEX OF SHEETS




RIGHT-OF-WAY DIVISION  
TOWN FILE  
PERPETUAL  
Towns of Manchester-Dorset US RTE #7  
(To Be Returned To R.O.W. Division)

STATE OF VERMONT  
AGENCY OF TRANSPORTATION



PROPOSED IMPROVEMENT  
**TOWNS OF MANCHESTER & DORSET**  
COUNTY OF BENNINGTON Plan # 77E179  
**U.S. ROUTE 7**

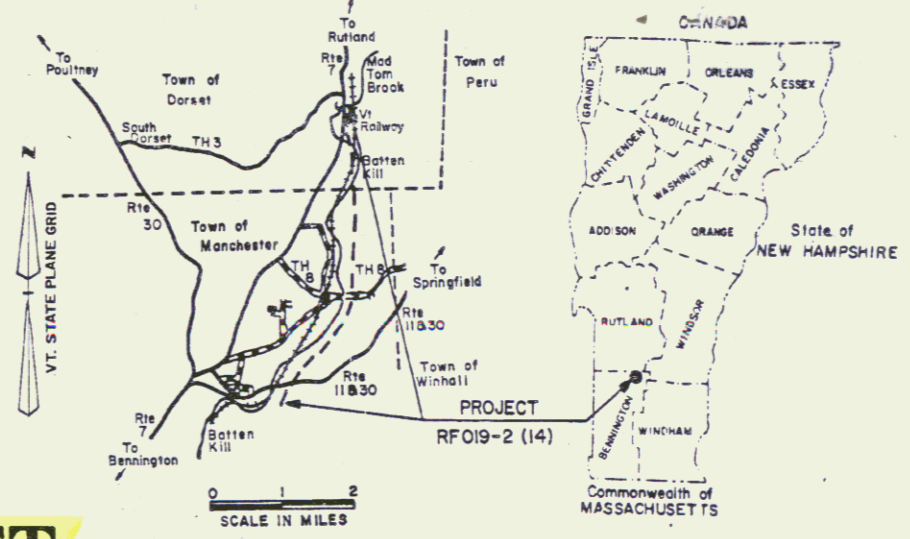


BEGIN R.O.W. PROJECT MM 0468  
RFO19-2(14) SECT. I S.B. 1656+00 698' LT.

R.O.W. PLANS

Beginning at a point 3.052 miles southerly of the Manchester-Dorset town line and extending northerly 1.829 miles.

Length of Roadway 9385.58 Feet = 1.777 Miles  
Length of Bridges 272.38 Feet = 0.052 Mile  
Length of Project 9657.96 Feet = 1.829 Miles  
Length of ROW Project 12,541 Feet = 2.38 Miles

N.B. 170+00  
End Project RFO19-2(14)  
End Contract 2

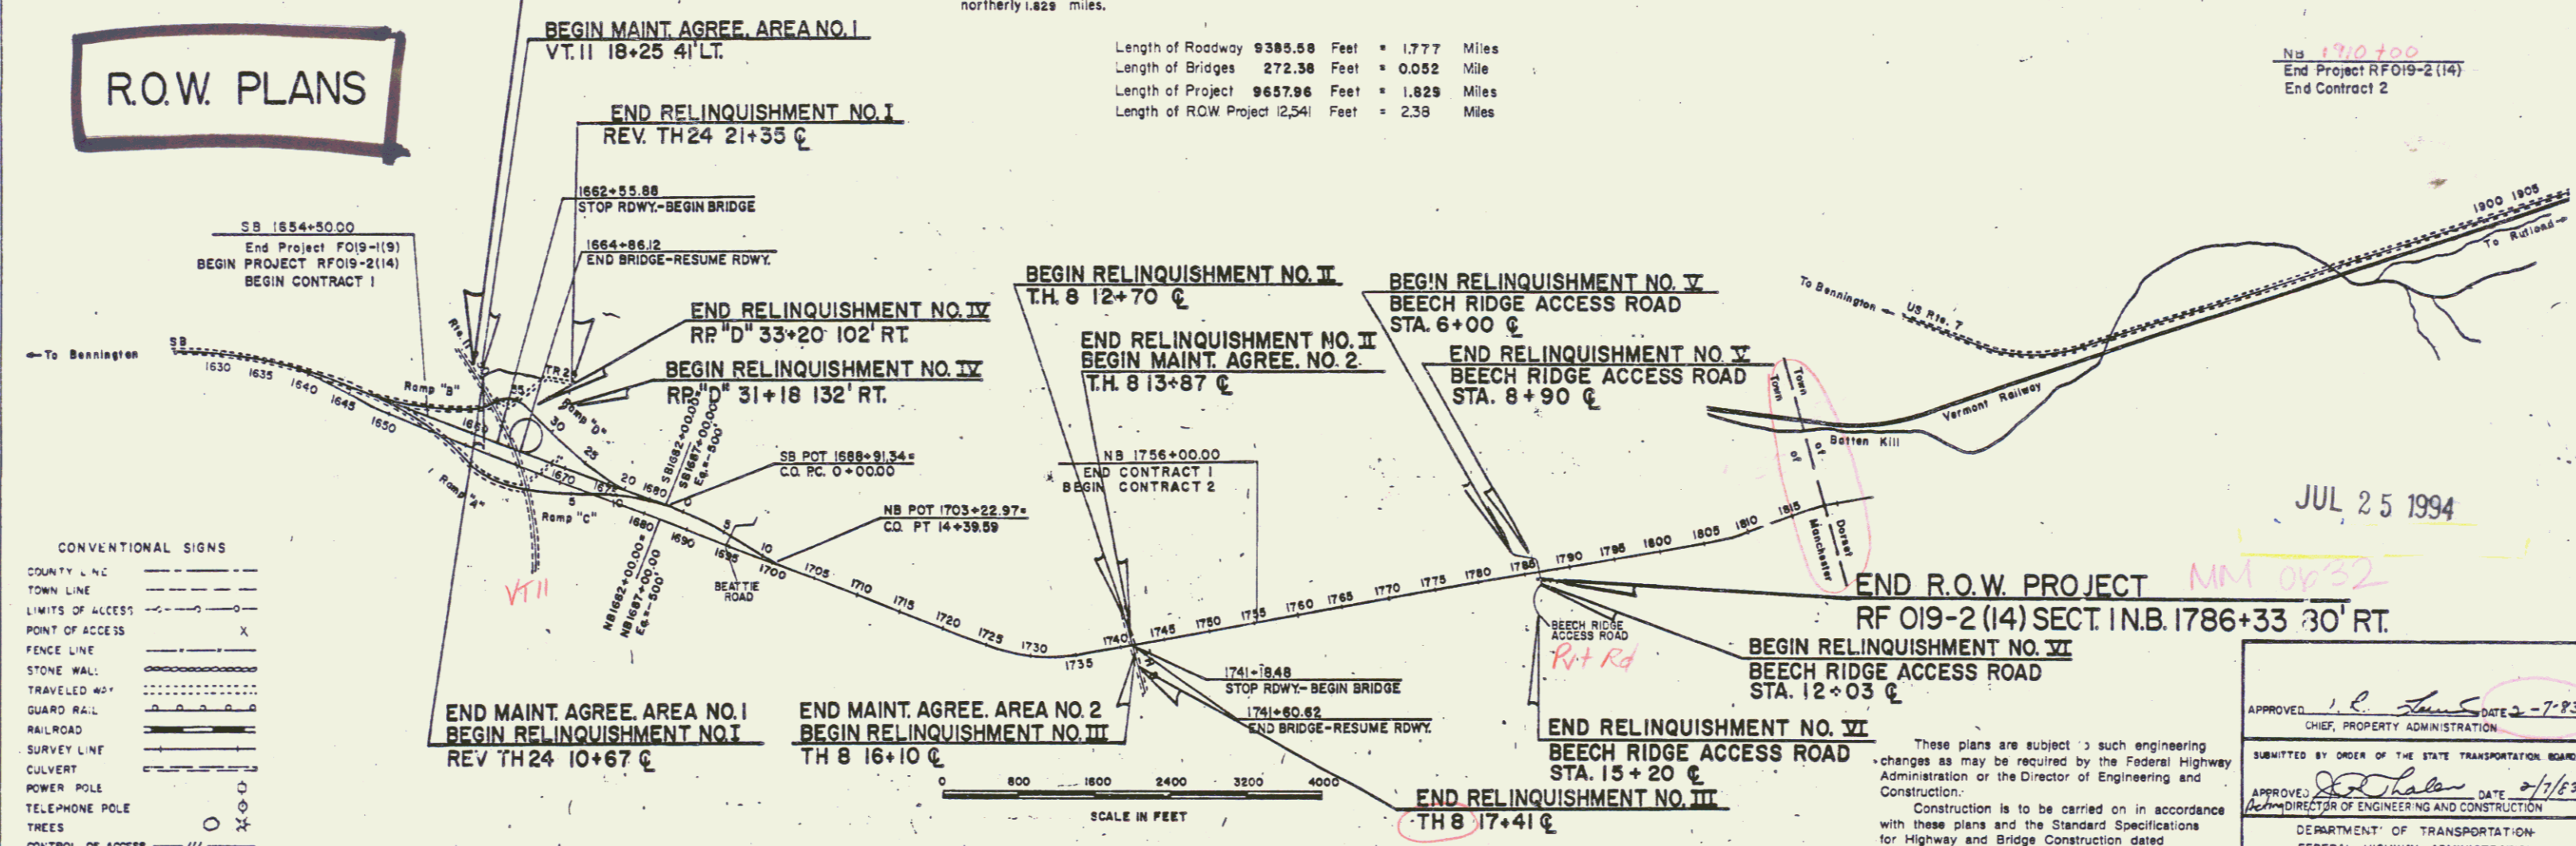

CONVENTIONAL SIGNS

COUNTY LINE	---
TOWN LINE	- - - -
LIMITS OF ACCESS	---
POINT OF ACCESS	X
FENCE LINE	---
STONE WALL	---
TRAVELED RD	---
RAILROAD	---
SURVEY LINE	---
CULVERT	---
POWER POLE	○
TELEPHONE POLE	○
TREES	○
CONTROL OF ACCESS	---
PROPERTY LINE	---
ROW TAKING LINE	---
SLOPE RIGHTS	△
TOP OF CUT	△
TOE OF SLOPE	○

DATUM  
VERTICAL NGVD 1929  
HORIZONTAL NAD 1927

END R.O.W. PROJECT MM 0432  
RFO19-2(14) SECT. I N.B. 1786+33 30' RT.

These plans are subject to such engineering changes as may be required by the Federal Highway Administration or the Director of Engineering and Construction.  
Construction is to be carried on in accordance with these plans and the Standard Specifications for Highway and Bridge Construction dated March, 1976, as approved by the Federal Highway Administration on October 27, 1976 for use on this project, including all subsequent revisions and such revised specifications and special provisions as are incorporated in these plans.

APPROVED: [Signature] DATE 7-83  
CHIEF, PROPERTY ADMINISTRATION

SUBMITTED BY ORDER OF THE STATE TRANSPORTATION BOARD  
APPROVED: [Signature] DATE 7/83  
DIRECTOR OF ENGINEERING AND CONSTRUCTION

DEPARTMENT OF TRANSPORTATION  
FEDERAL HIGHWAY ADMINISTRATION

APPROVED: \_\_\_\_\_ DATE \_\_\_\_\_  
DIVISION ADMINISTRATOR

MANCHESTER-DORSET  
RFO19-2(14) SECTION 1  
SHEET 1 OF 44 SHEETS

JUL 25 1994