
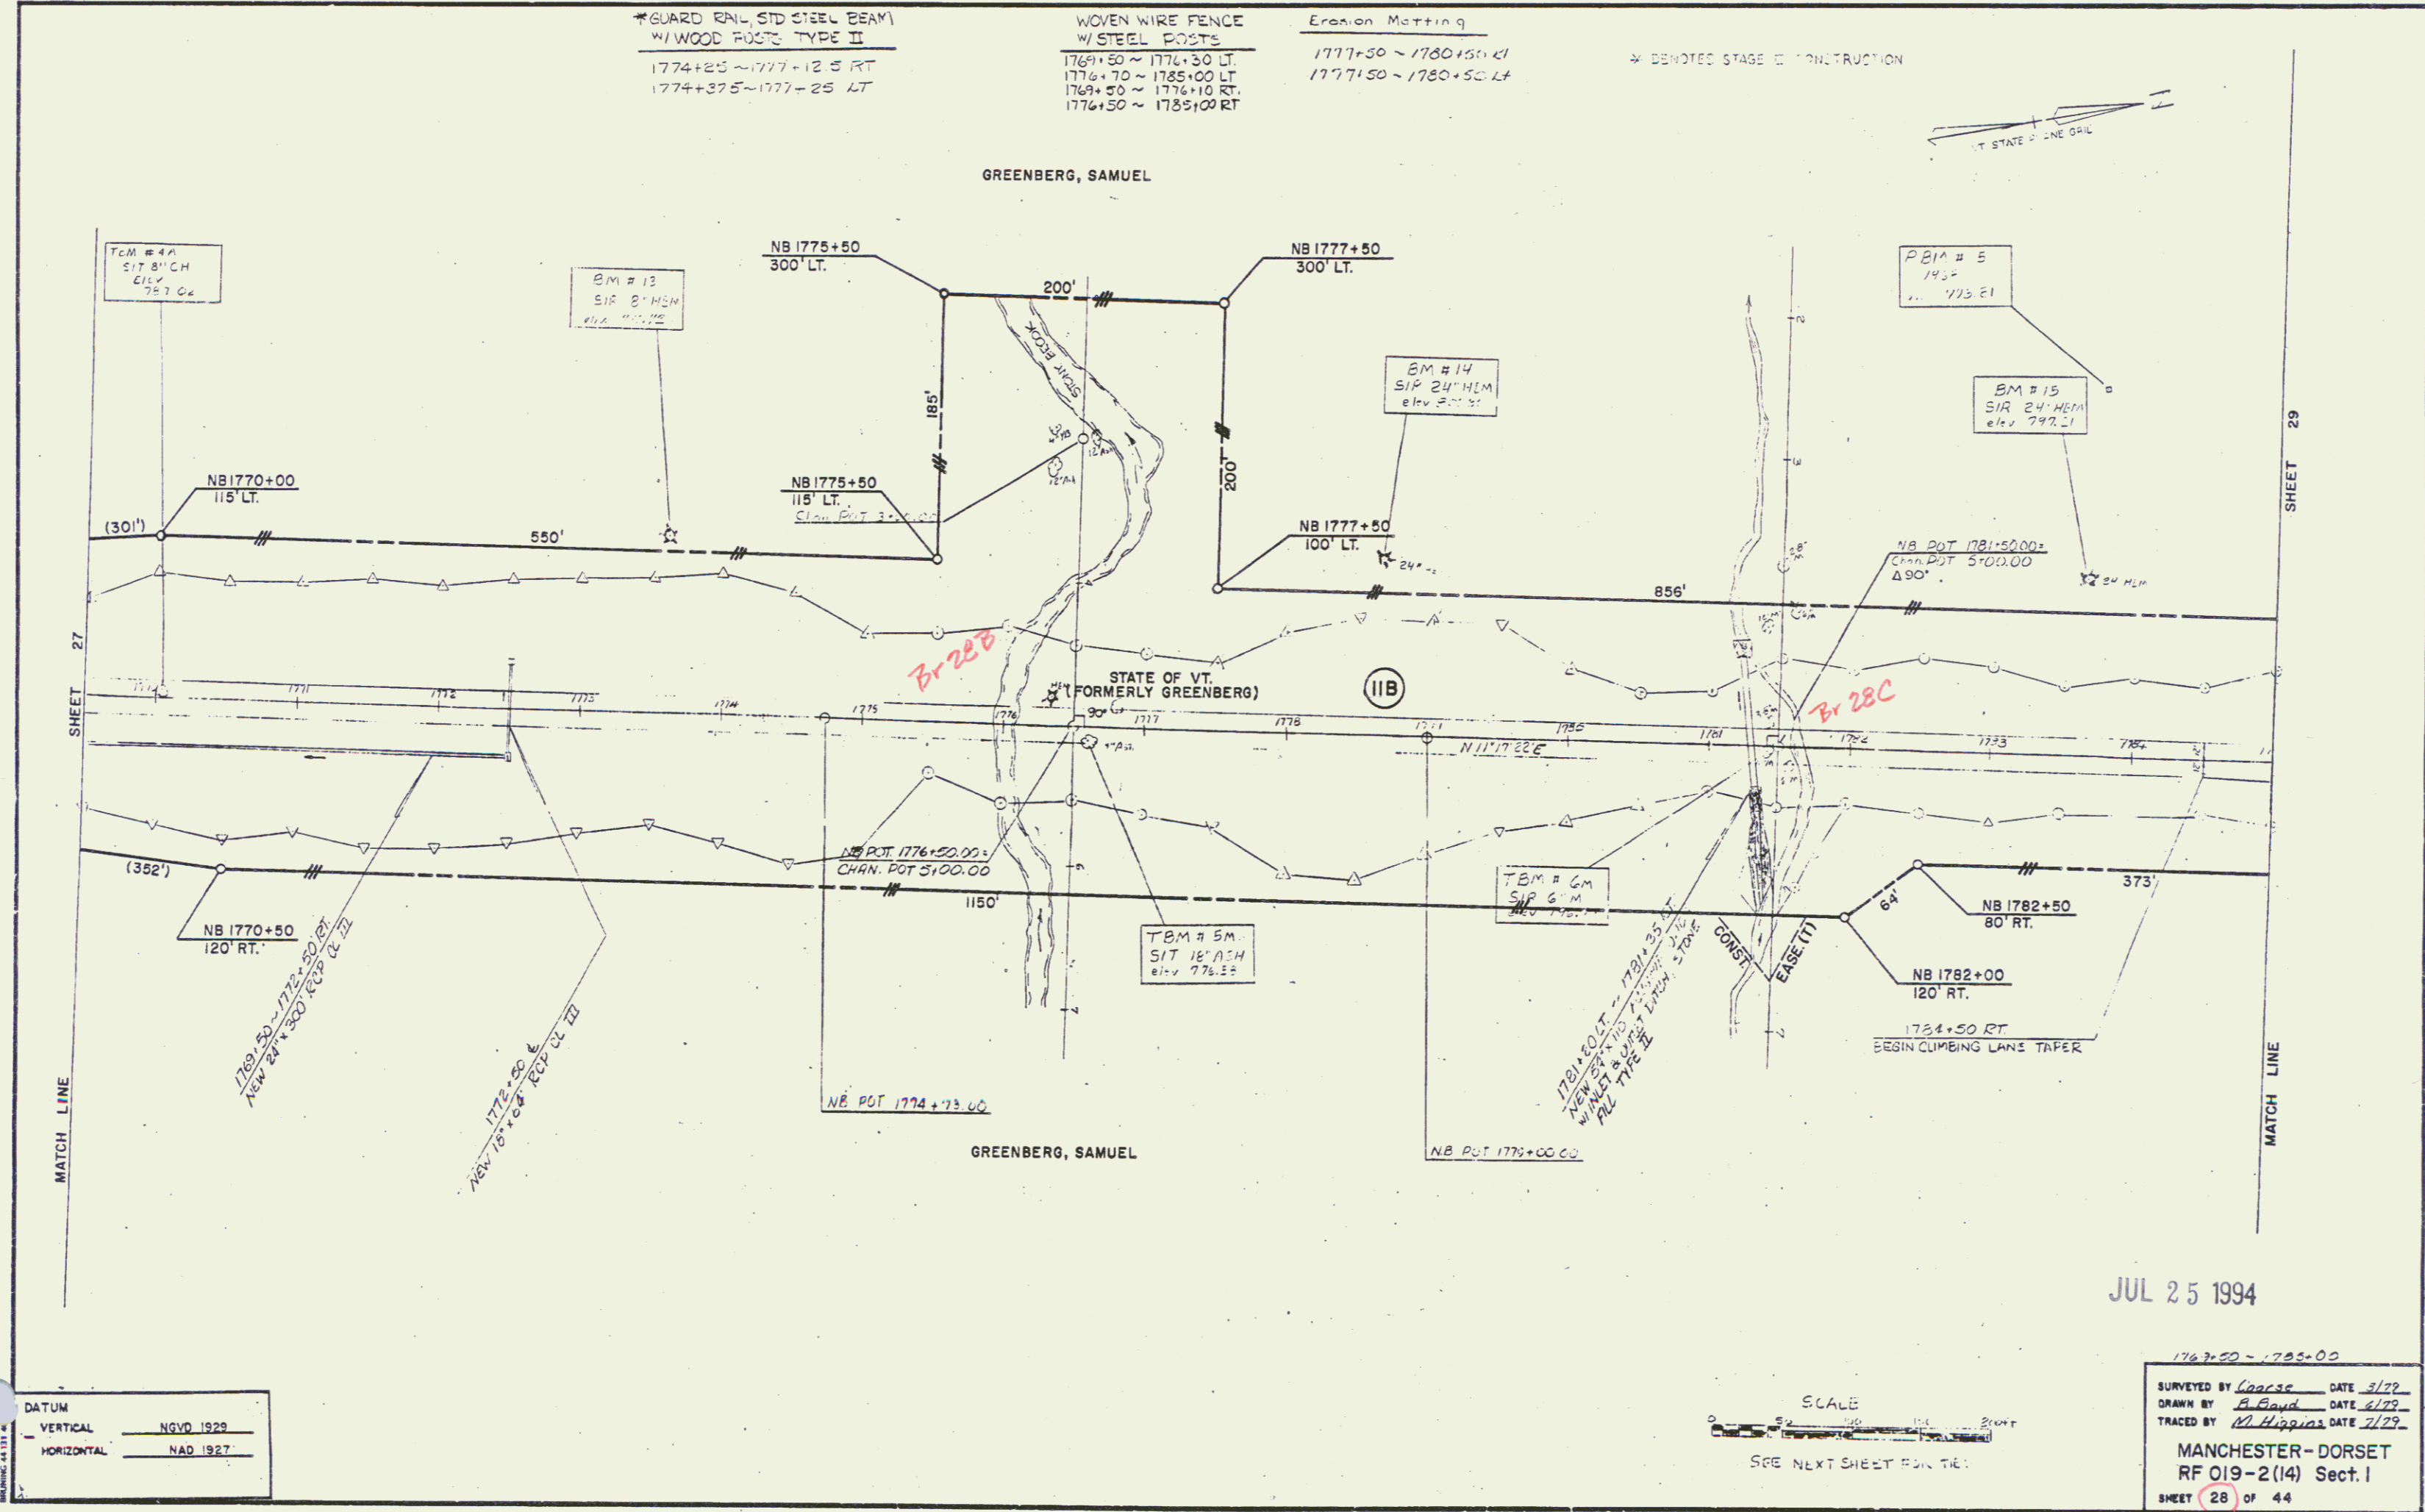


\* GUARD RAIL, STD STEEL BEAM / W/ WOOD POSTS TYPE II  
 1774+25 ~ 1777+12.5 RT  
 1774+37.5 ~ 1777+25 LT  
 WOVEN WIRE FENCE / W/ STEEL POSTS  
 1769+50 ~ 1776+30 LT  
 1776+70 ~ 1785+00 LT  
 1769+50 ~ 1776+10 RT  
 1776+50 ~ 1785+00 RT  
 Erosion Matting  
 1777+50 ~ 1780+50 LT  
 1777+50 ~ 1780+50 LT  
 \* DENOTES STAGE II CONSTRUCTION

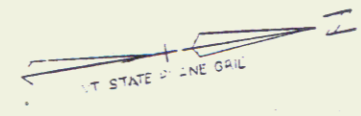

SHEET 27

SHEET 29

DATUM  
 VERTICAL NGVD 1929  
 HORIZONTAL NAD 1927

SCALE  
 1" = 100'

JUL 25 1994

1767+50 - 1783+00  
 SURVEYED BY Loose DATE 3/29  
 DRAWN BY E. Boyd DATE 6/22  
 TRACED BY M. Higgins DATE 7/29  
 MANCHESTER-DORSET  
 RF 019-2(14) Sect. 1  
 SHEET 28 OF 44