
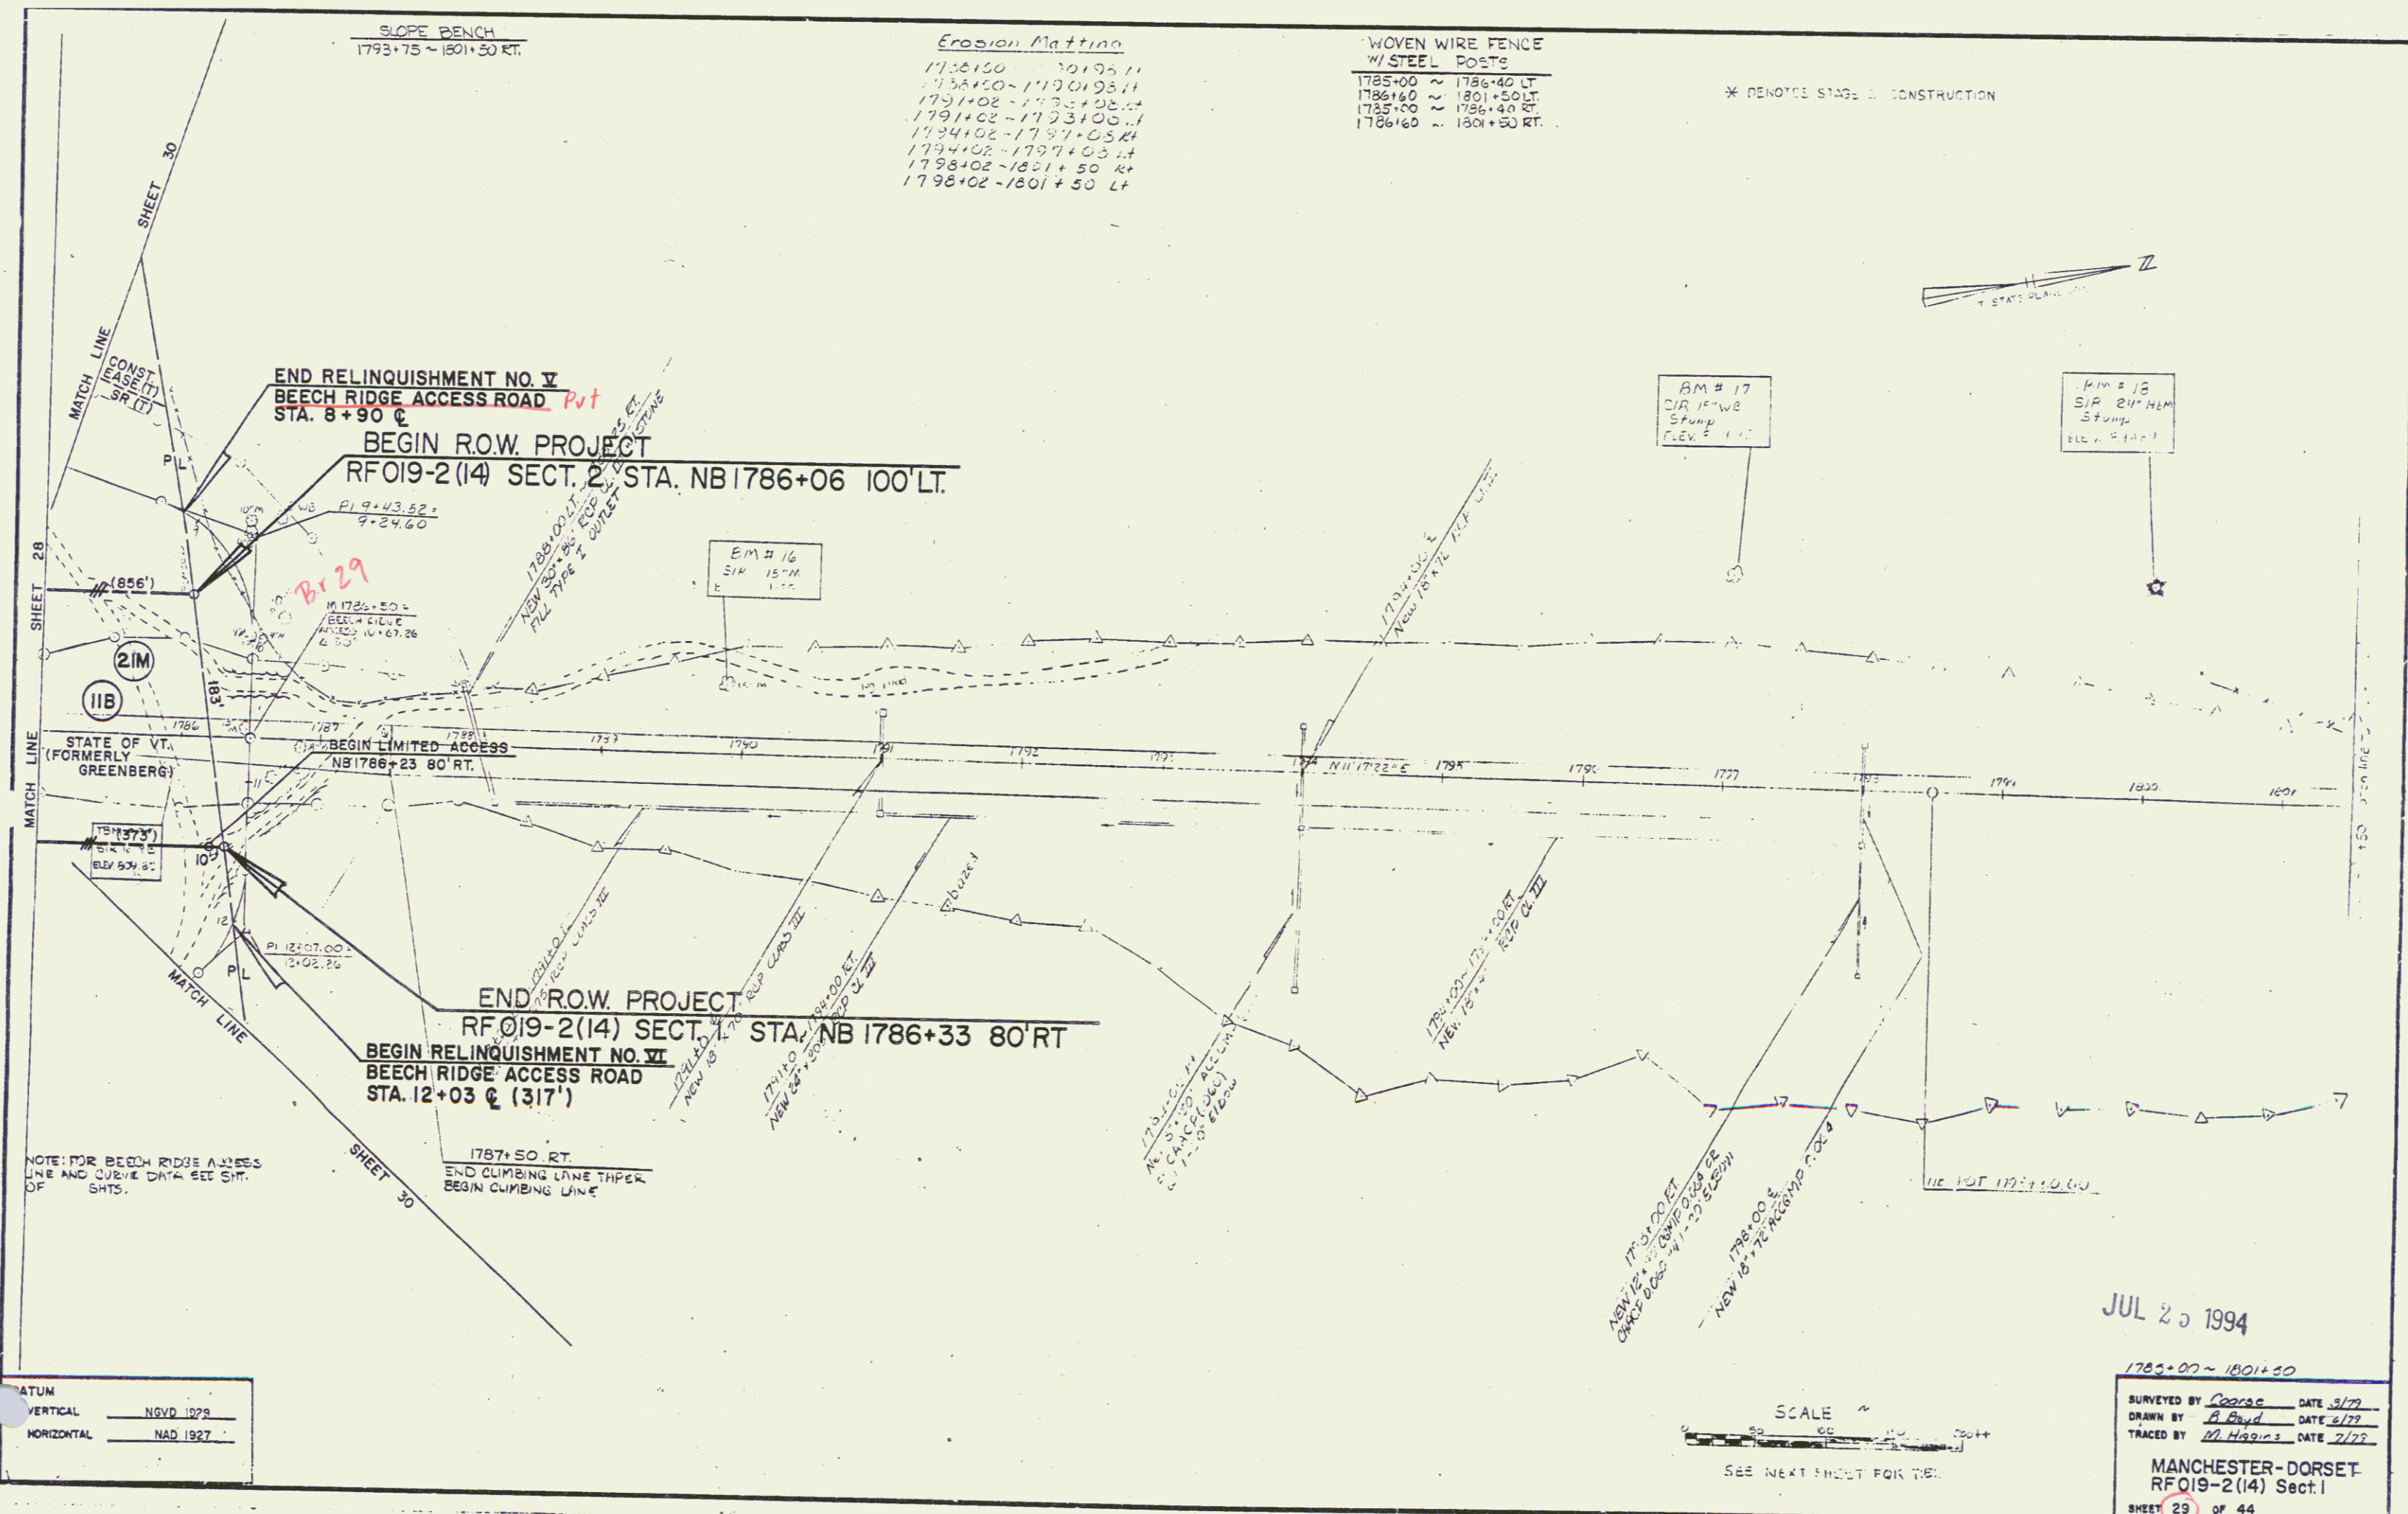


SLOPE BENCH
1793+75 ~ 1801+50 RT.

Erosion Matting
1793+150 ~ 1801+50 RT.
1793+150 ~ 1797+00 RT.
1797+00 ~ 1799+00 RT.
1799+00 ~ 1799+31.00 RT.
1799+31.00 ~ 1799+31.00 RT.
1799+31.00 ~ 1799+31.00 RT.
1799+31.00 ~ 1799+31.00 RT.
1799+31.00 ~ 1801+50 RT.


WOVEN WIRE FENCE
W/STEEL POSTS
1785+00 ~ 1786+40 LT.
1786+40 ~ 1801+50 LT.
1785+00 ~ 1786+40 RT.
1786+40 ~ 1801+50 RT.

* DENOTES STAGE II CONSTRUCTION

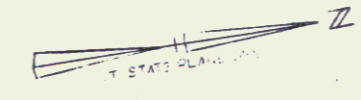

NOTE: FOR BEECH RIDGE ACCESS LINE AND CURVE DATA SEE SHT. OF SHTS.

VERTICAL	NGVD 1979
HORIZONTAL	NAD 1927

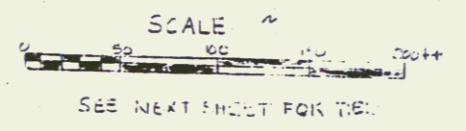

JUL 20 1994

1785+00 ~ 1801+50

SURVEYED BY C. G. G. DATE 3/79
 DRAWN BY A. Boyd DATE 6/79
 TRACED BY M. Higgins DATE 7/79

MANCHESTER-DORSET
RFO19-2(14) Sect. I

SHEET 29 OF 44