


PLAN
NOTE BOOK
No. _____



JUL 25 1994

PROFILE
NOTE BOOK
No. _____

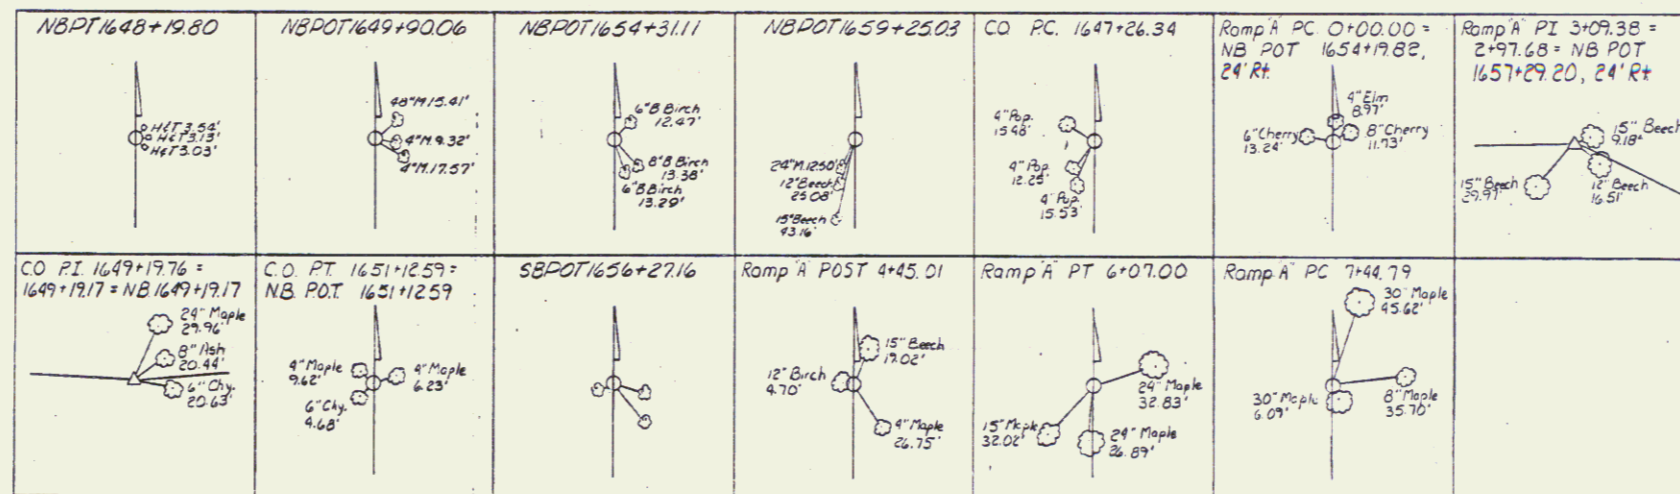