


PLAN
 SHEET NO. 34
 PROJECT: MANCHESTER-DARSET
 DRAWING NO. 019-2(18)
 DATE: JUL 20 1994

PROFILE
 SHEET NO. 34
 PROJECT: MANCHESTER-DARSET
 DRAWING NO. 019-2(18)
 DATE: JUL 20 1994

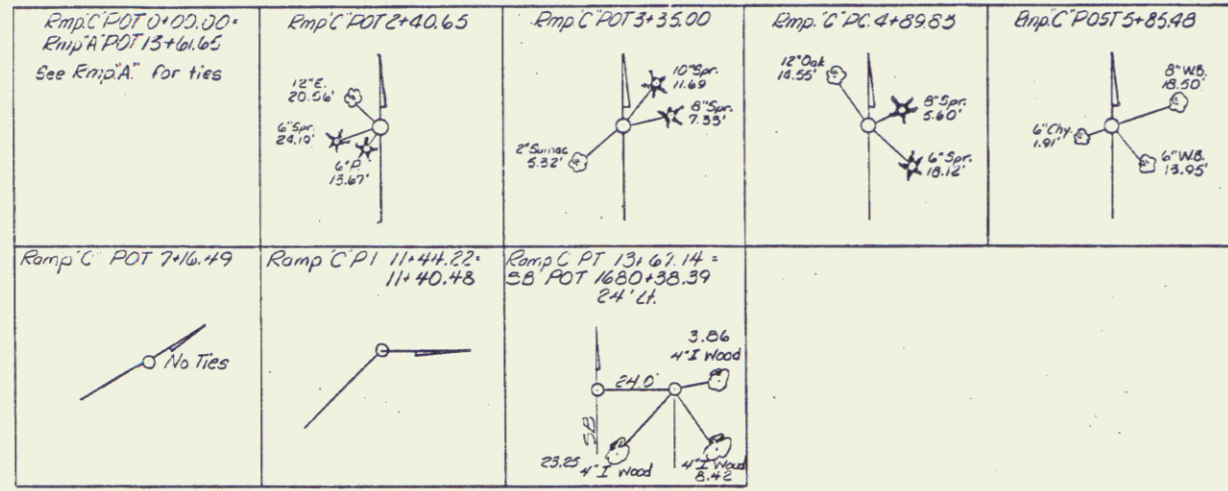

JUL 20 1994

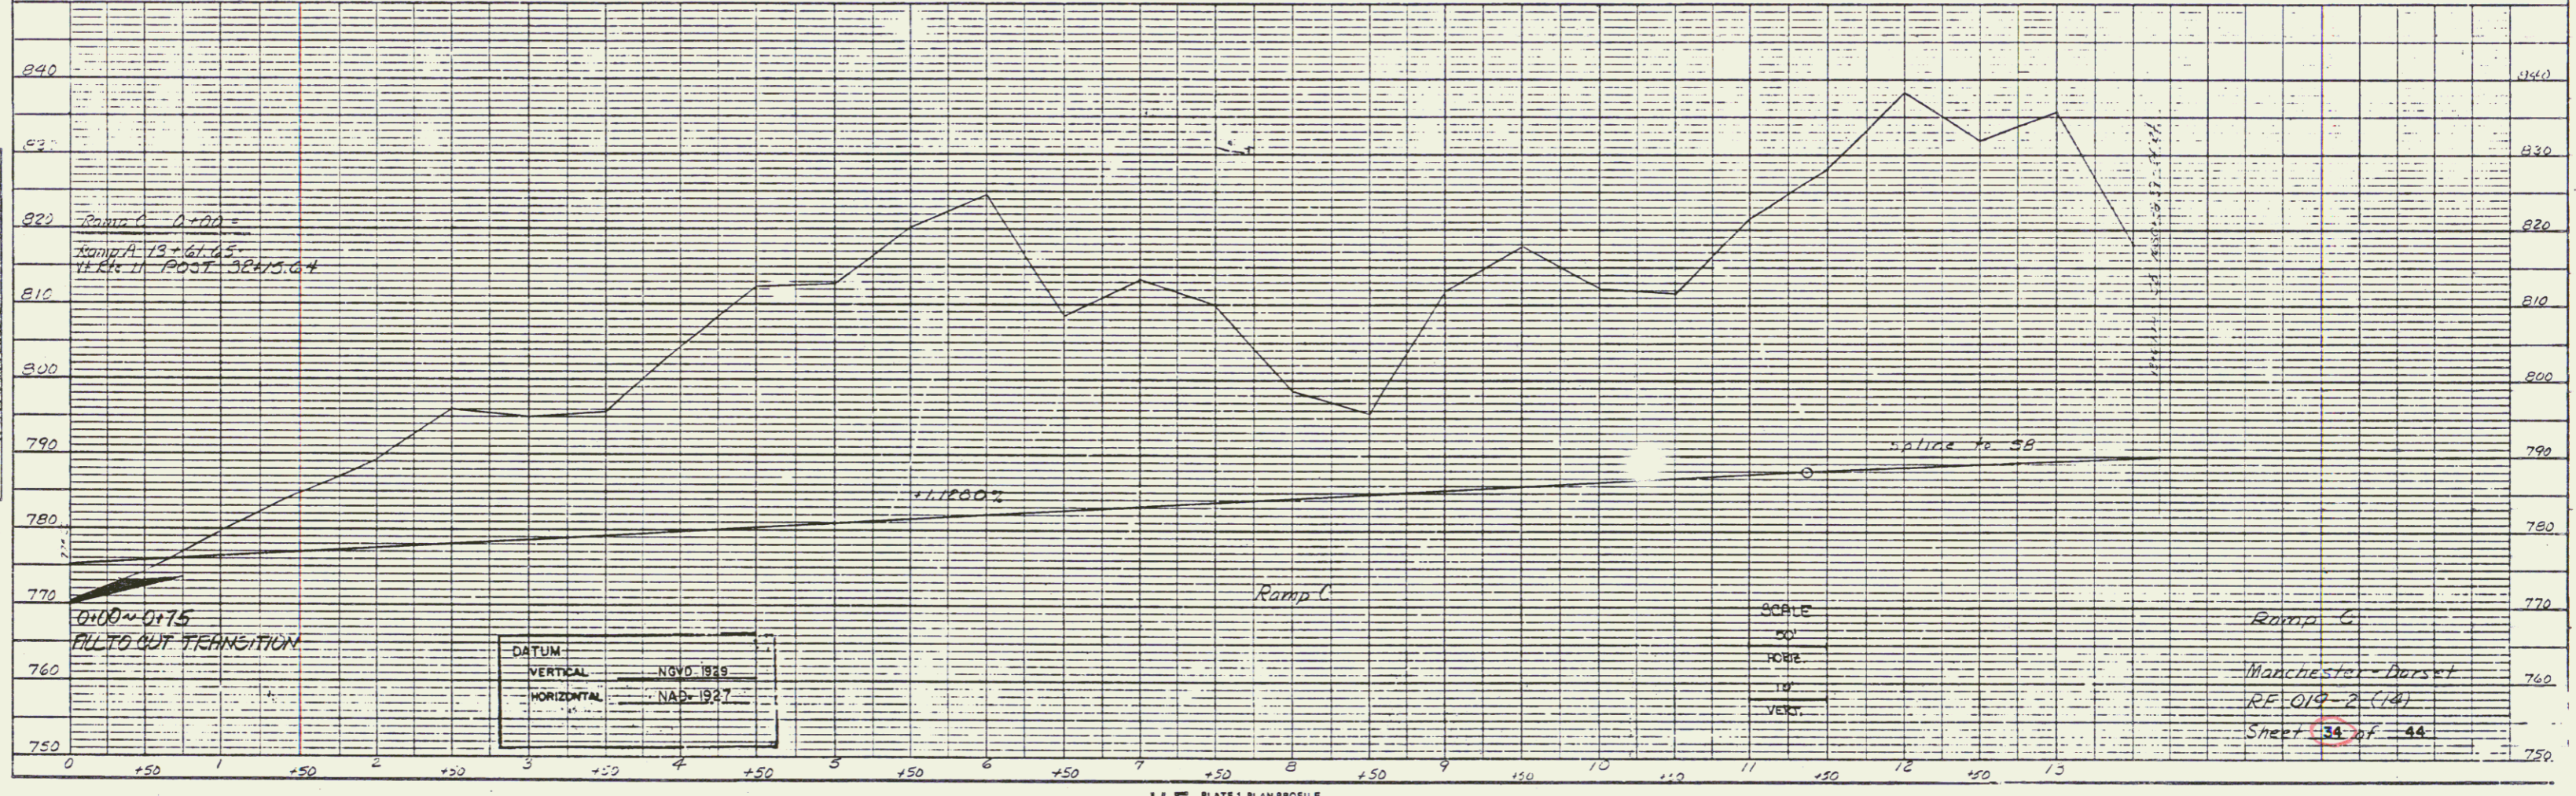


PLATE 1, PLAN PROFILE