


PLAN	DATE
PROJECT	
NOTE BOOK	
NO.	

PROFILE	DATE
PROJECT	
NOTE BOOK	
NO.	

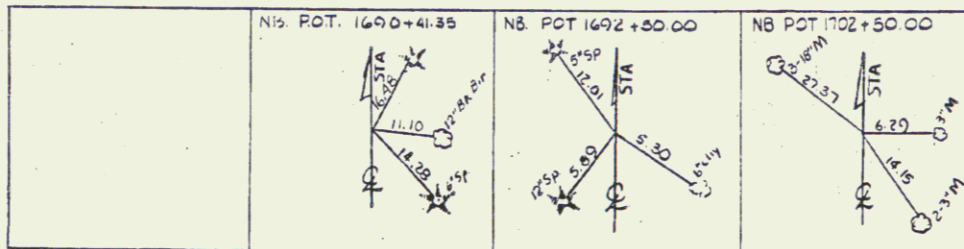

JUL 25 1994

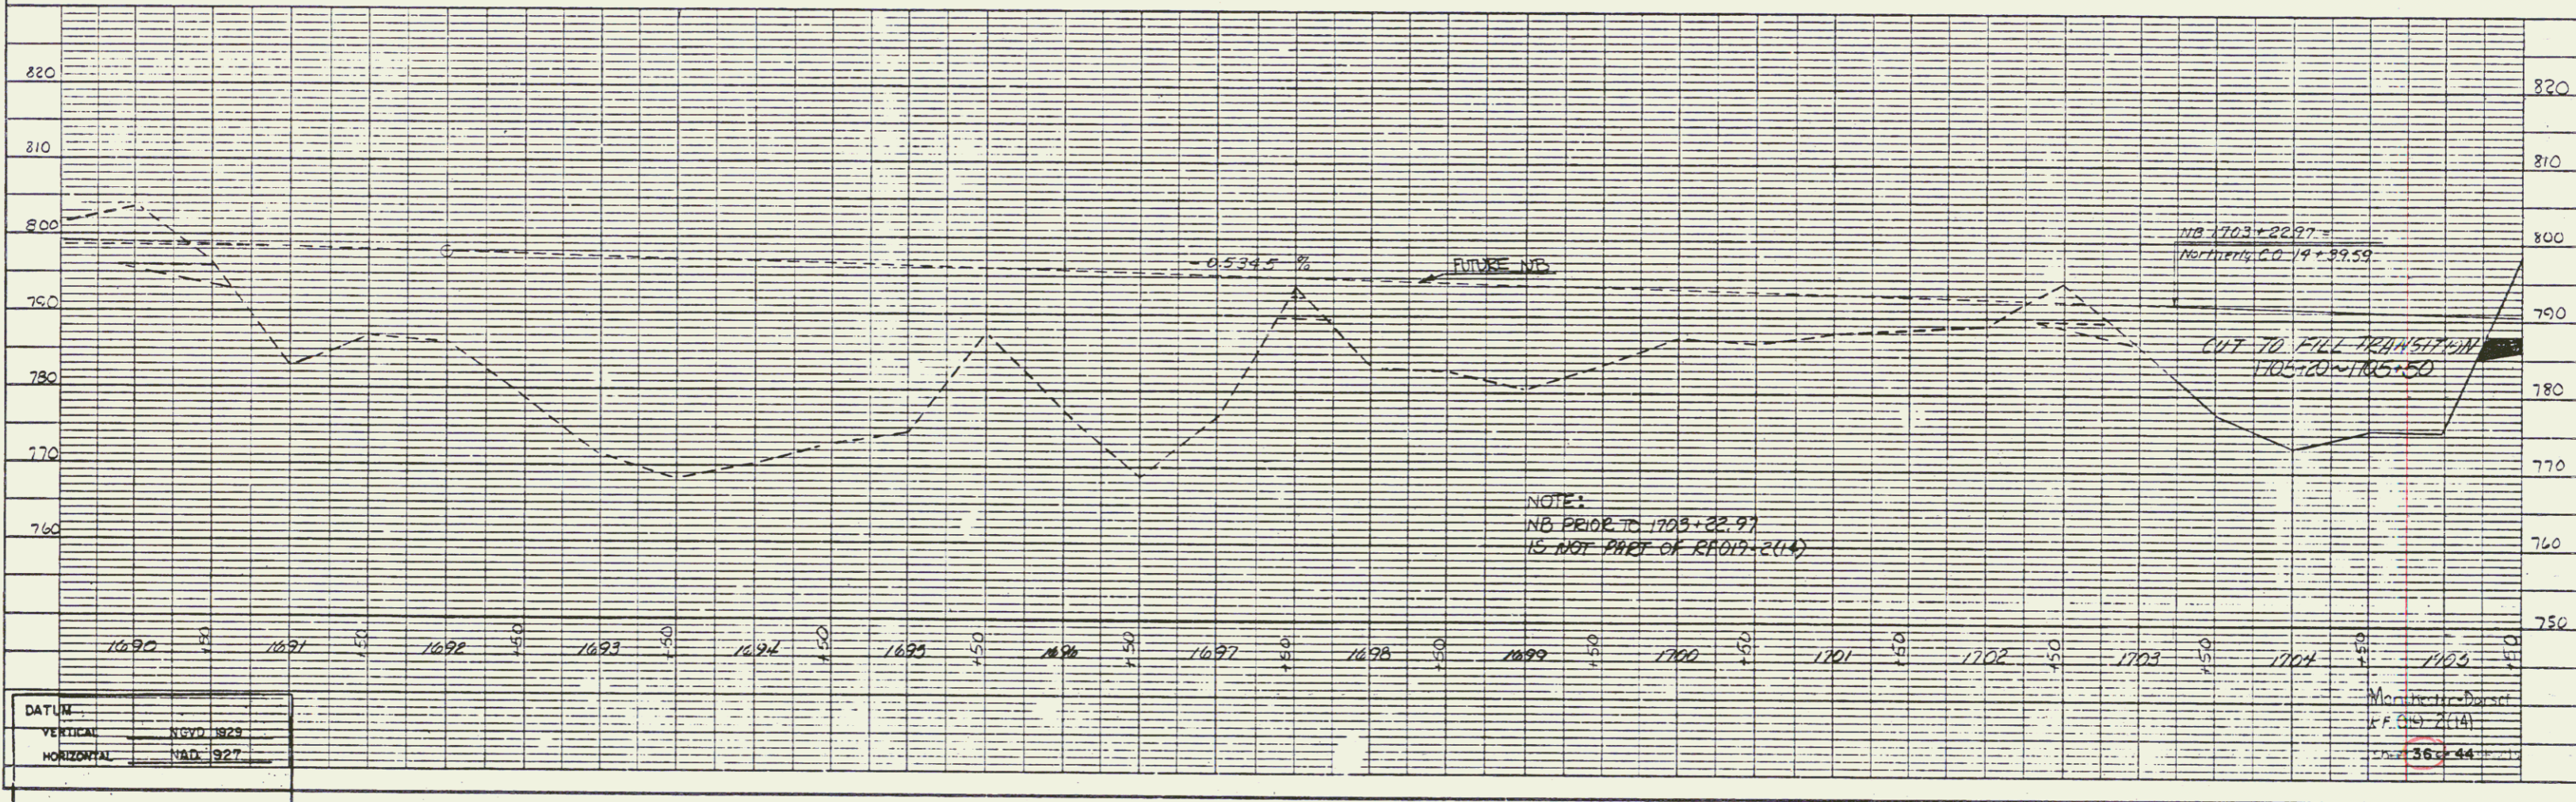


PLATE 1, PLAN PROFILE