


PLAN  
 NOTE BOOK  
 NO. \_\_\_\_\_



JUL 25 1994

PROFILE  
 NOTE BOOK  
 NO. \_\_\_\_\_

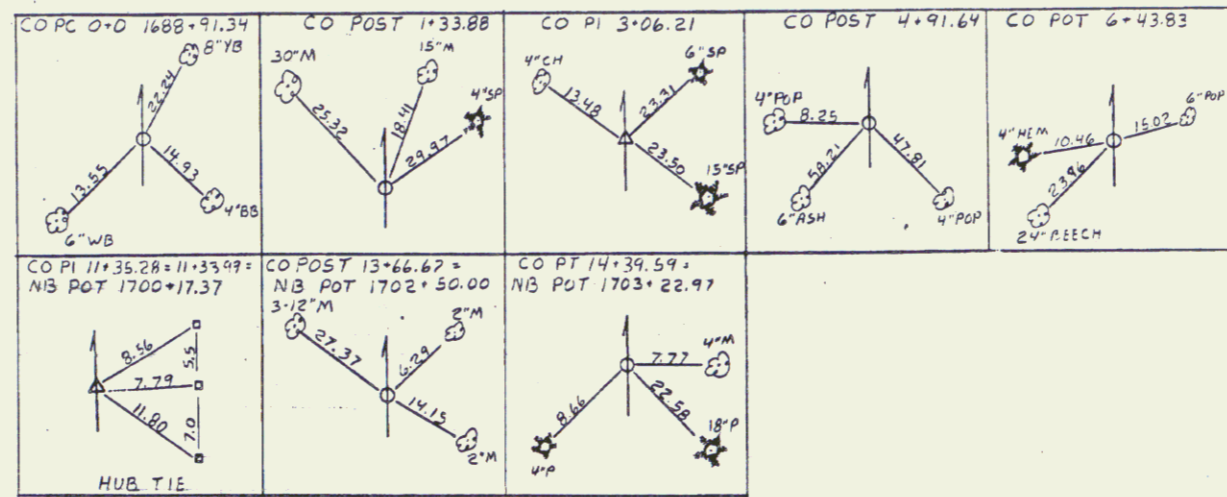