


PLAN  
 SHEET NO. 38 OF 44 SHEETS  
 PROJECT NO. 100-1000-1000  
 DATE: JUL 25 1994

PROFILE  
 SHEET NO. 38 OF 44 SHEETS  
 PROJECT NO. 100-1000-1000  
 DATE: JUL 25 1994



JUL 25 1994

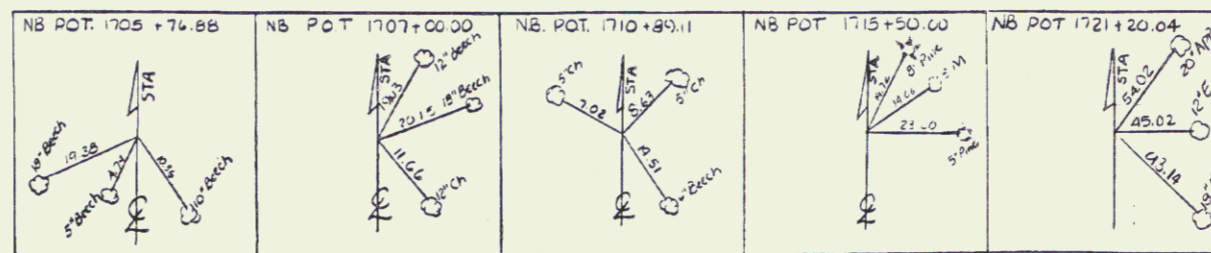