



PLAN
 PROJECT: _____
 DRAWING NO.: _____
 DATE: _____

PROFILE
 PROJECT: _____
 DRAWING NO.: _____
 DATE: _____

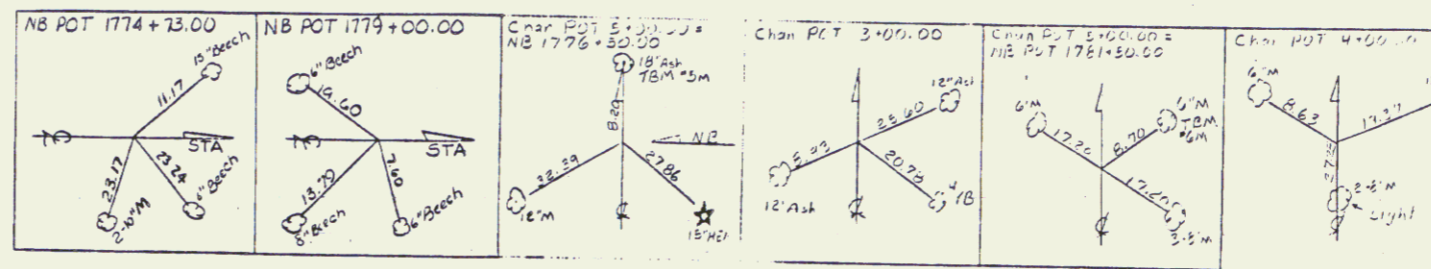

JUL 25 1994

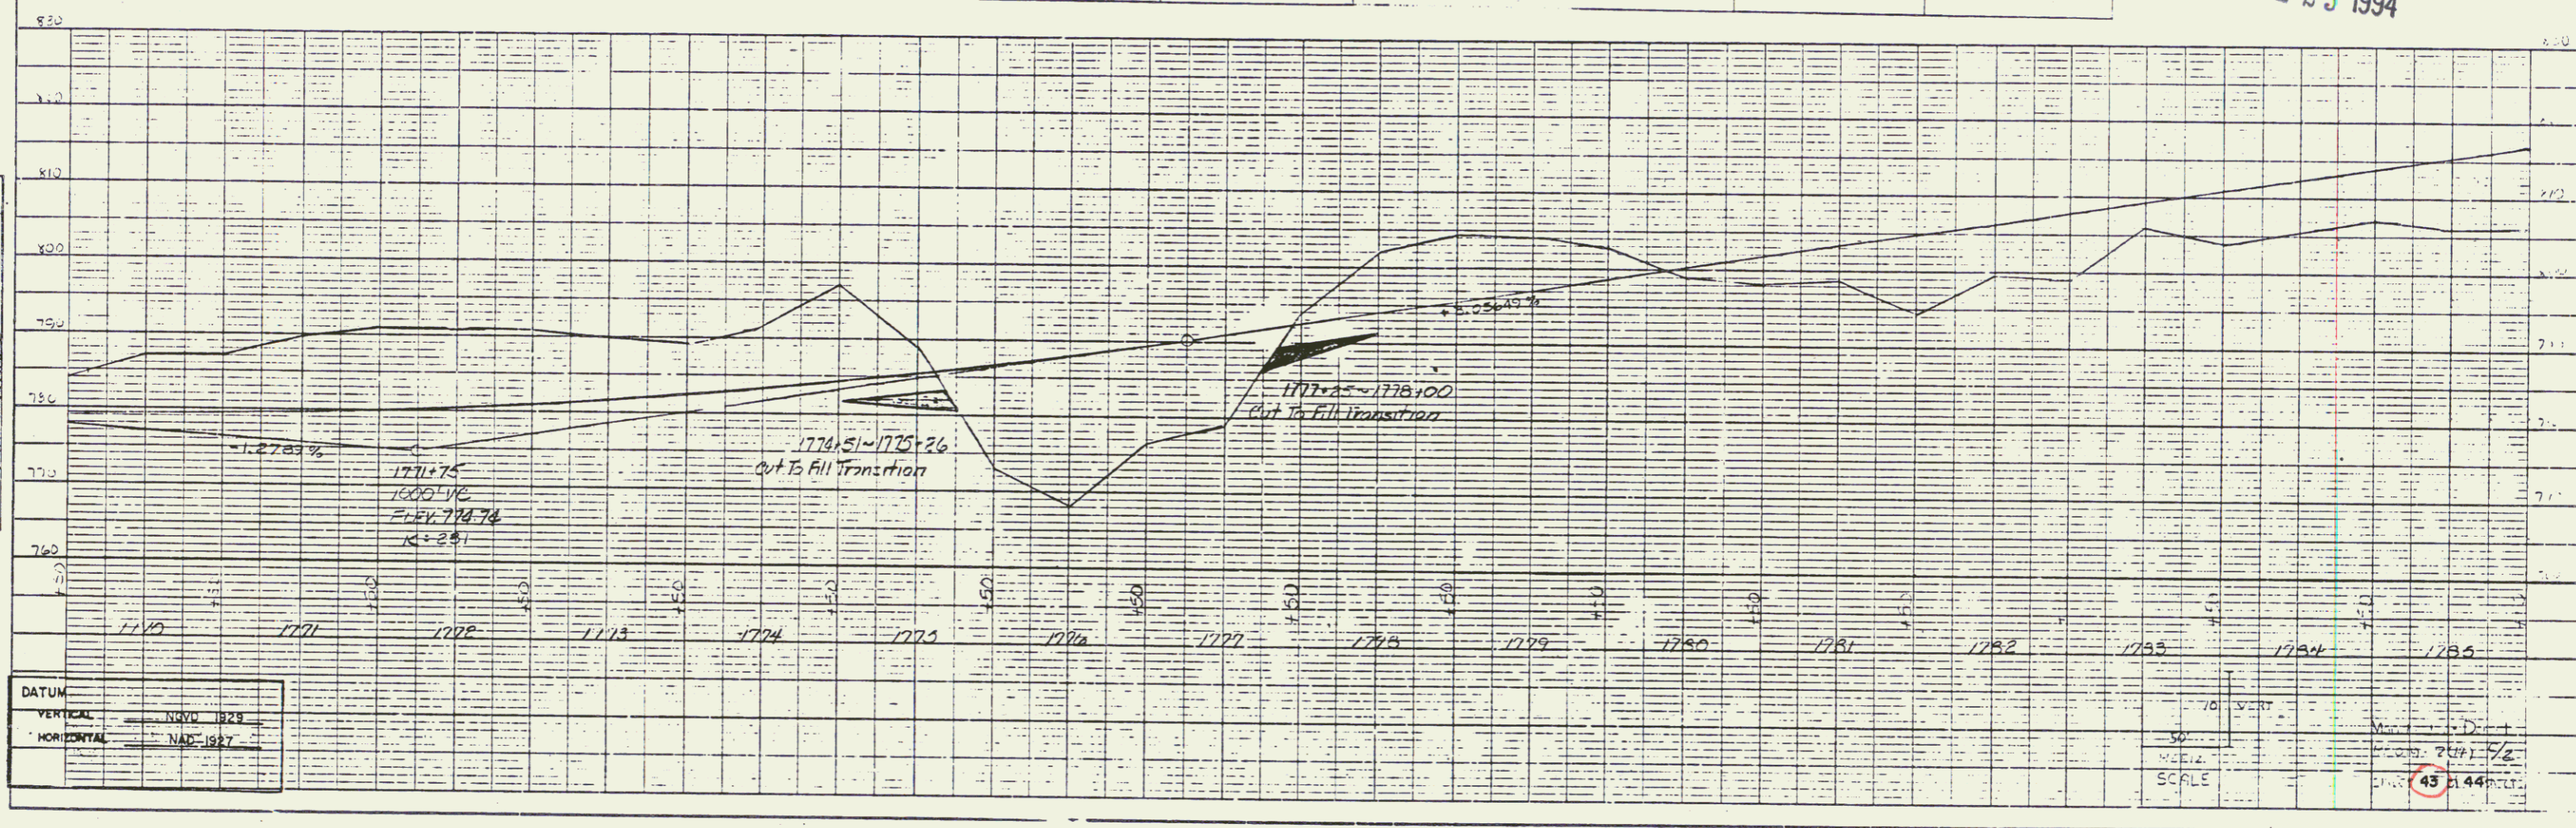

DATUM
 VERTICAL: NAVD 83
 HORIZONTAL: NAD 83

SCALE
 1" = 40' VERT
 1" = 50' HORIZ
 43 1/44