


PLAN
 DATE: _____
 PROJECT: _____
 DRAWN BY: _____
 CHECKED BY: _____
 SCALE: _____

PROFILE
 DATE: _____
 PROJECT: _____
 DRAWN BY: _____
 CHECKED BY: _____
 SCALE: _____



JUL 25 1994

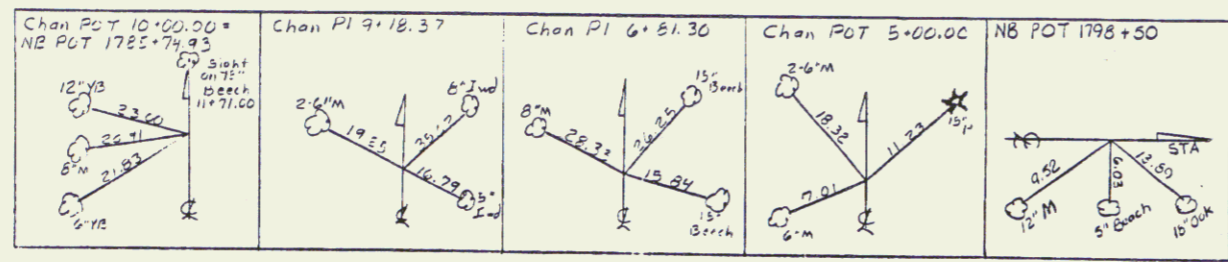