

RESEARCH DRAWER SET


INDEX OF SHEETS

1	2	3	100
---	---	---	---	---	---	---	---	---	----	----	-----

STATE OF VERMONT  
AGENCY OF TRANSPORTATION



PROPOSED IMPROVEMENT  
TOWNS OF MANCHESTER & DORSET  
COUNTY OF BENNINGTON  
U.S. ROUTE 7

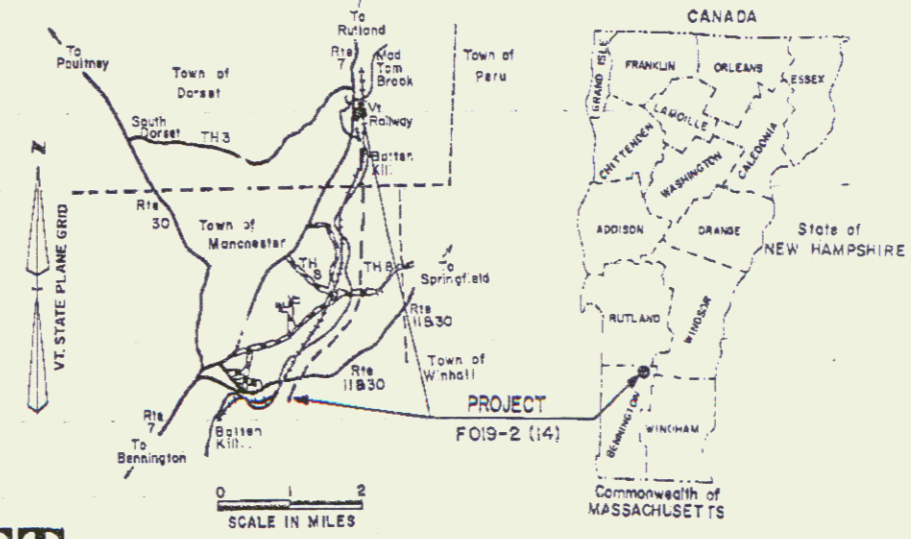


Beginning at a point 1.205 miles southerly of the Manchester-Dorset town line and extending northerly 2.916 miles.  
Length of R.O.W. Project 12364.00 Feet = 2.341 Miles  
Length of Roadway 15293.44 Feet = 2.896 Miles  
Length of Bridges 104.12 Feet = 0.020 Mile  
Length of Project 15397.56 Feet = 2.916 Miles

RIGHT-OF-WAY DIVISION  
TOWN FILE  
PERPETUAL  
Town of Manchester-Dorset US RTE #7  
(To Be Returned To R.O.W. Division)

This project consists of the construction of U.S. Route 7 on a completely new location.

R.O.W. PLANS

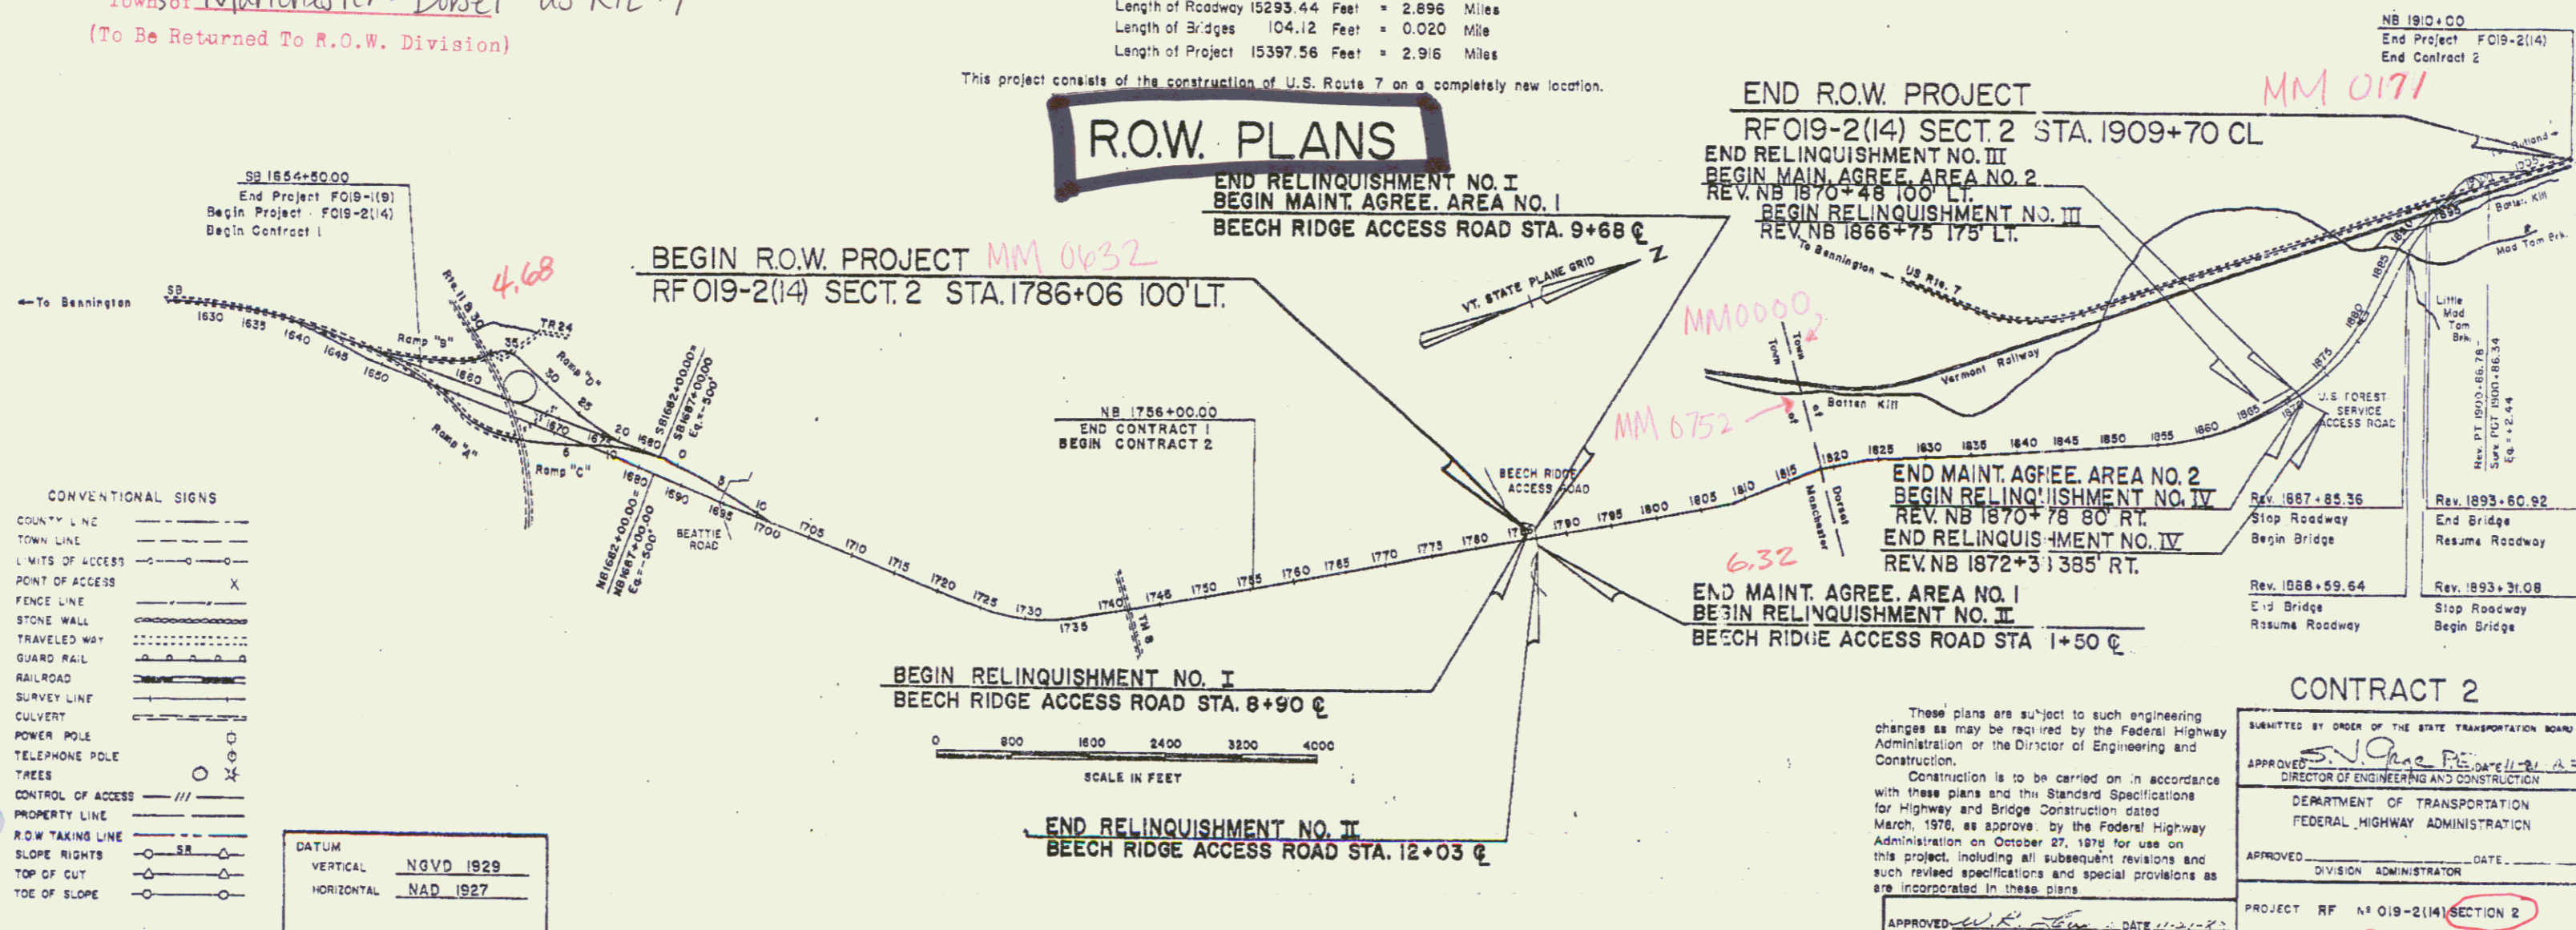

AUG 2 1994

45