

SEEDING FORMULA ITEM 651.0  
RURAL AREAS  
(SPECIAL MIX)

% WT.	LBS/A	NAME	% PUR	% GERM.
17	10	ORCHARD GRASS	80	85
17	10	CREeping RED FESCUE	98	85
8	5	RED TOP	92	85
17	10	FLAT PEA (VAR. LATHCO)	90	80
16	10	PERENNIAL RYE GRASS (VAR. PENNFIRE)	95	85
25	15	ALFALFA (VAR. SARANAC)	98	85
100	60			

THE SEED MIXTURE SHALL NOT HAVE A WEED CONTENT EXCEEDING 0.40% BY WEIGHT AND SHALL BE FREE FROM ALL NOXIOUS WEED SEED.

GENERAL NOTES

FERTILIZER, ITEM 651.15, SHALL BE MIXED AS FOLLOWS  
NITROGEN 10%  
PHOSPHORUS 20%  
POTASH 10%

FERTILIZER SHALL BE DELIVERED IN BAGS OF NOT TO EXCEED 100 LBS EACH AND IS TO BE APPLIED AT THE RATE OF 500 LBS PER ACRE.

AGRICULTURAL LIMESTONE, ITEM 651.20, TO BE APPLIED TO ALL EARTH SLOPES AT THE RATE OF TWO TONS PER ACRE OR AS DIRECTED BY THE ENGINEER.

WOOD MARKER POSTS, ITEM 619.15, TO BE PLACED AS DIRECTED BY THE ENGINEER.

FOR ROUNDING OF SLOPES SEE STANDARD SHEET 8-5





HAIR MULCH, ITEM 651.25, TO BE PLACED ON ALL EARTH SLOPES AT THE RATE OF TWO TONS PER ACRE

## TYPICAL SECTIONS

ITEMS ABOVE SUBGRADE NOT PART OF STAGE 1 CONSTRUCTION

3" BITUMINOUS CONCRETE PAVEMENT, ITEM 406.25 (2 1/4") 1 1/4" WEARING COURSE OVER 1 1/4" BINDER COURSE  
5" PLANT MIXED COURSE, ITEM 303.25 (2 1/2" FOR TOTAL THICKNESS) TWO 2 1/4" COURSES  
24" SUBBASE OF DENSE GRADED CRUSHED STONE, ITEM 301.35 (2")  
SHOULDERS 1 1/4" BITUMINOUS CONCRETE PAVEMENT, ITEM 406.25 WITH ITEM 404.40

0-24" SAND BORROW, ITEM 203.31, IN CUT (2") TO BE PLACED AS NOTED ON PLANS OR AS DIRECTED BY ENGINEER.  
0-12" GRANULAR BORROW, ITEM 203.32, IN FILL (2") TOLERANCES IN PARENTHESIS APPLY TO THICKNESS ONLY

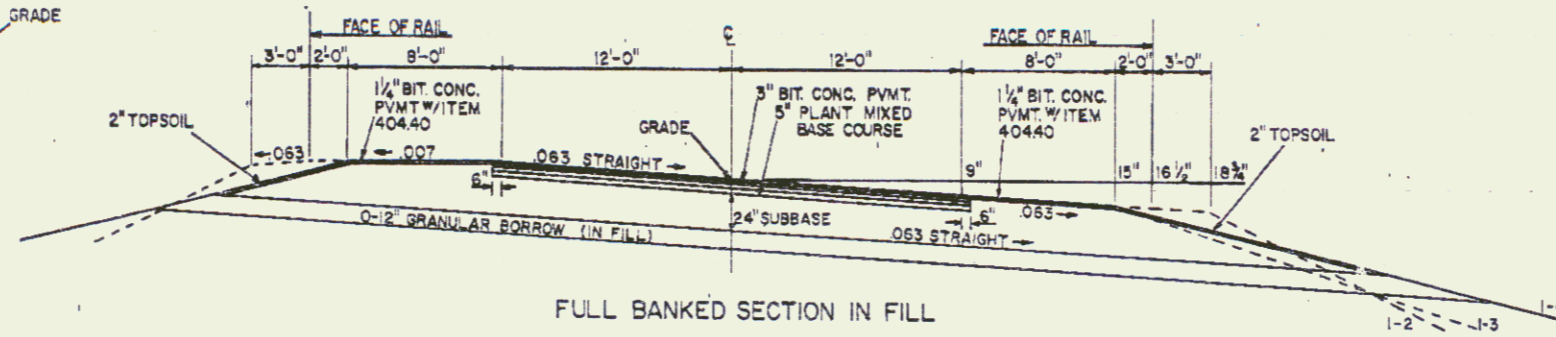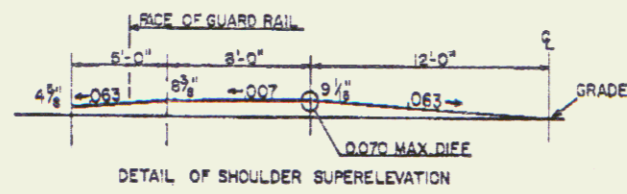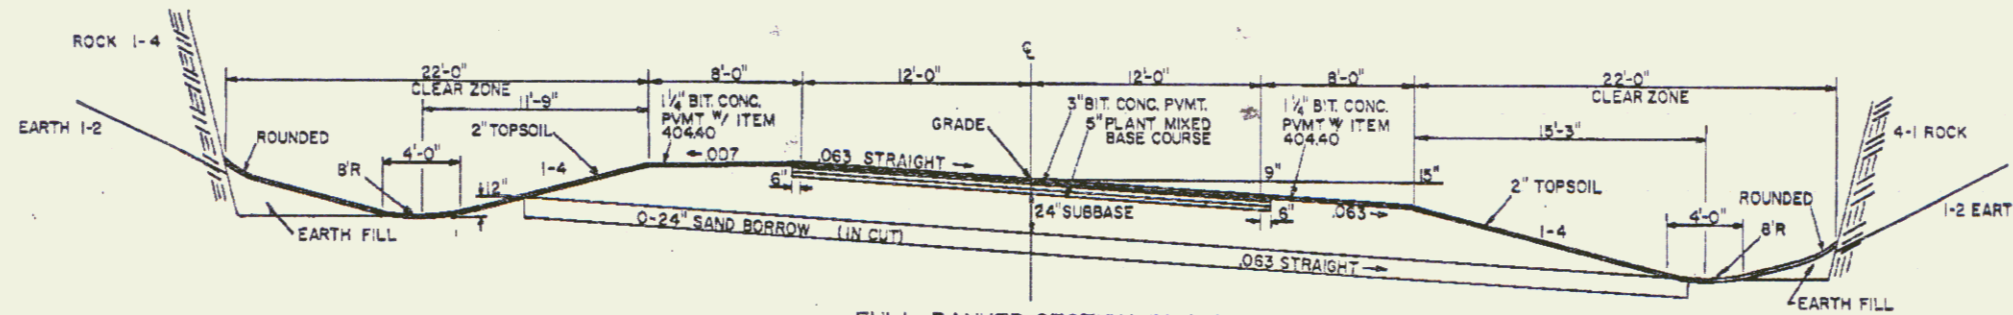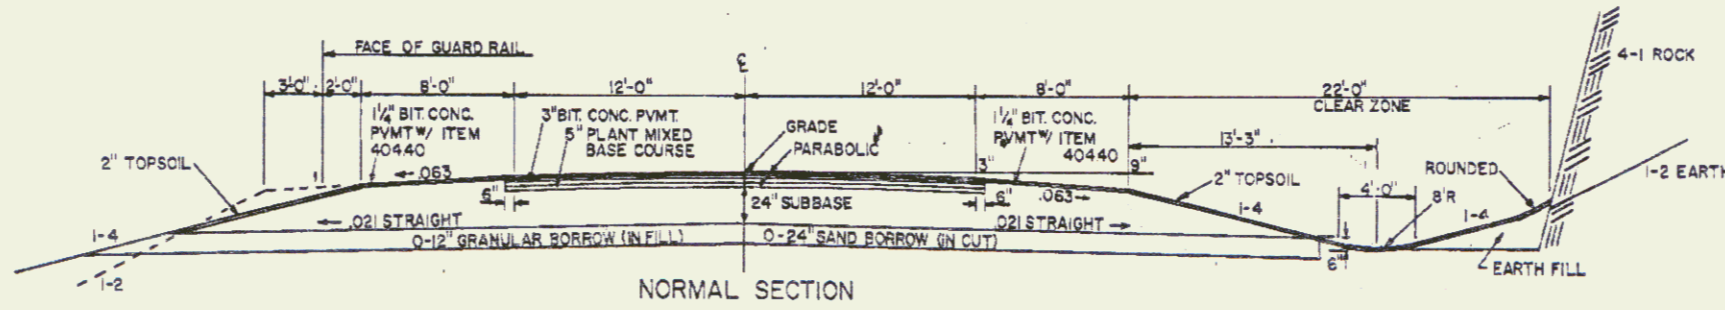

CONTRACT 2

AUG 9 1994

DRAWN BY B. BOYD DATE 5-82  
TRACED BY SK. JANAWICZ DATE 1-82  
MANCHESTER-DORSET  
PROJ. RF NO. 019-2 (14) SECT. 2  
SHEET 2 OF 28