
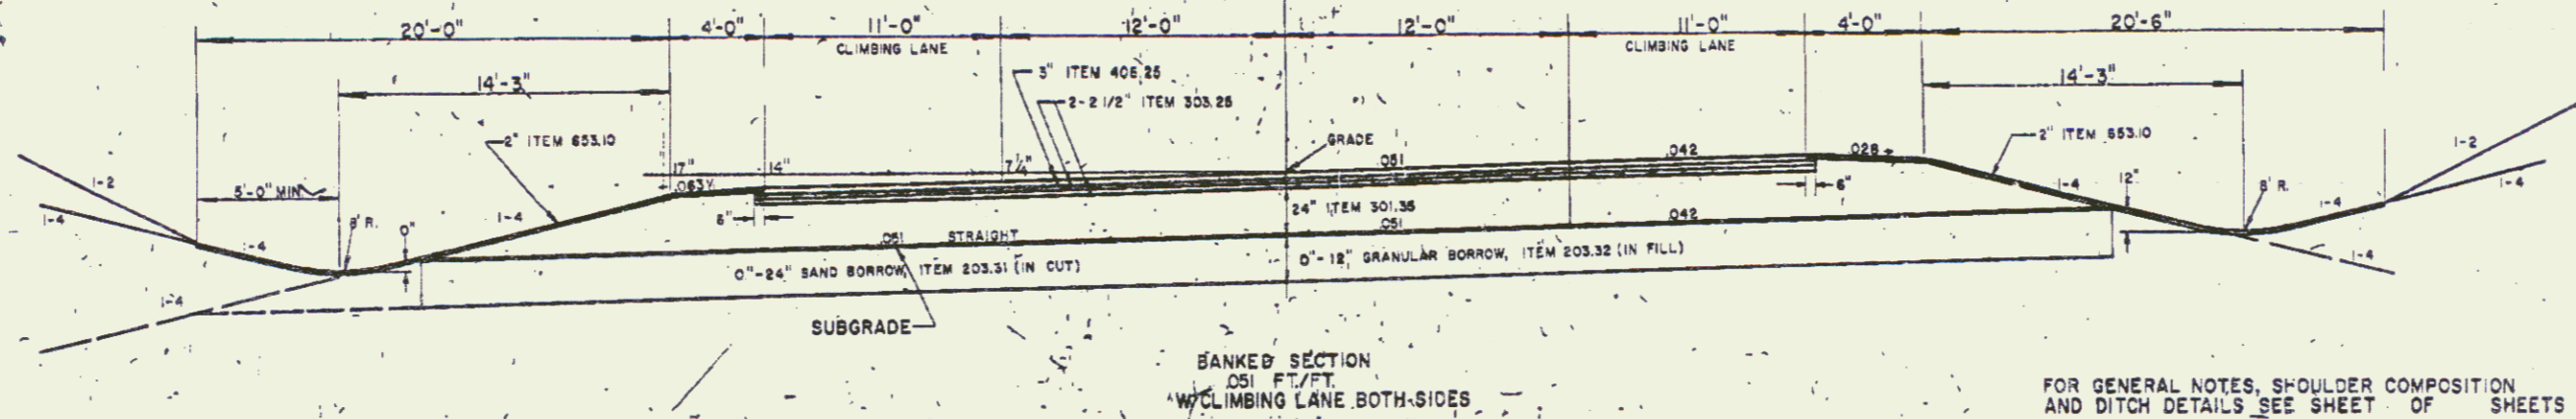
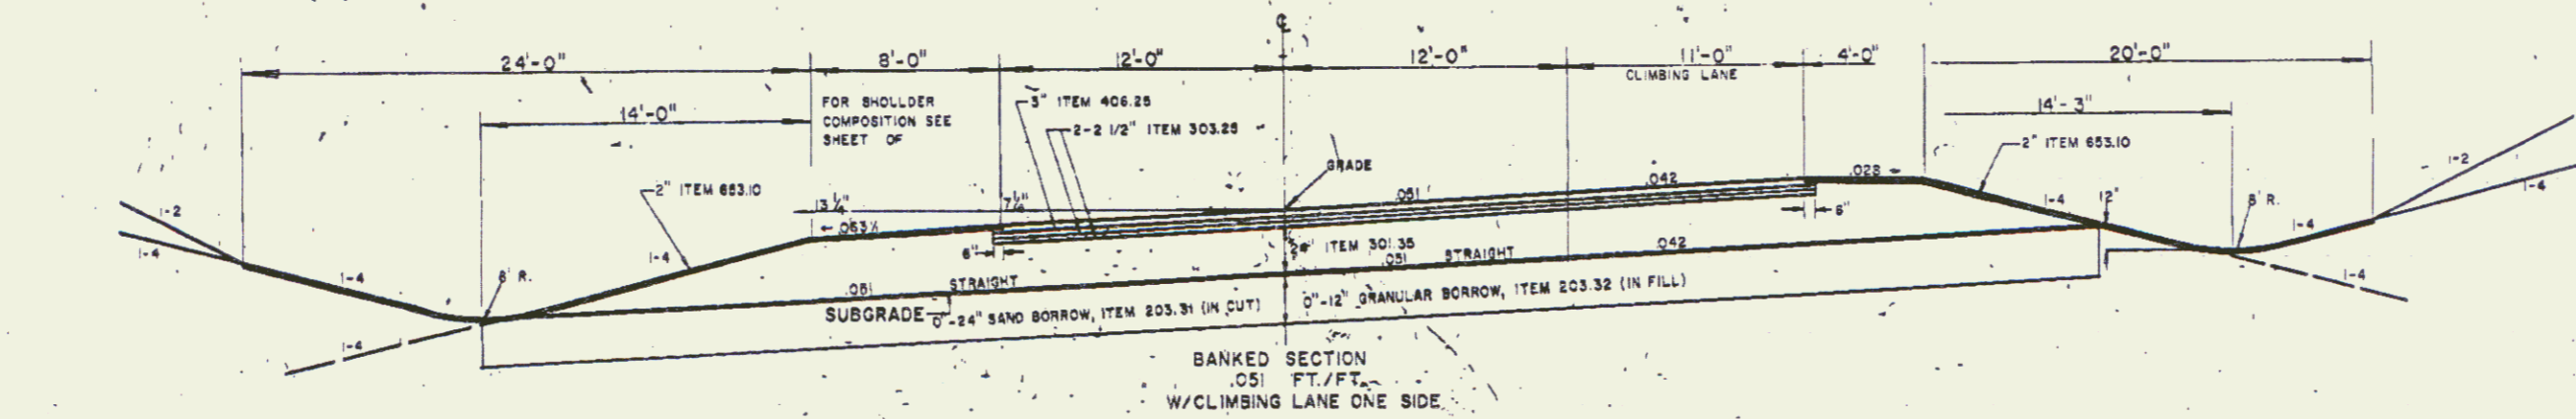


TYPICAL SECTIONS WITH CLIMBING LANE

THESE ITEMS ARE NOT A PART OF STAGE I CONSTRUCTION.

3" BITUMINOUS CONCRETE PAVEMENT, ITEM 406.25, ($\pm 1/4"$) 1-1/4" WEARING COURSE OVER 1-3/4" BINDER COURSE
 5" PLANT MIXED BASE COURSE, ITEM 303.25, ($\pm 1/2"$ FOR TOTAL THICKNESS) TWO 2-1/2" COURSES
 24" SUB-BASE OF DENSE GRADED CRUSHED STONE, ITEM 301.35 ($\pm 1"$)
 SHOULDERS: 1 1/4" BITUMINOUS CONCRETE PAVEMENT, ITEM 406.25

0"-24" SAND BORROW, ITEM 203.31, ($\pm 1"$) IN CUT TO BE PLACED AS NOTED ON THE PLANS OR AS DIRECTED BY THE ENGINEER.
 0"-12" GRANULAR BORROW, ITEM 203.32 ($\pm 1"$) IN FILL
 PERMISSIBLE TOLERANCES IN PARENTHESIS APPLY TO THICKNESS ONLY.

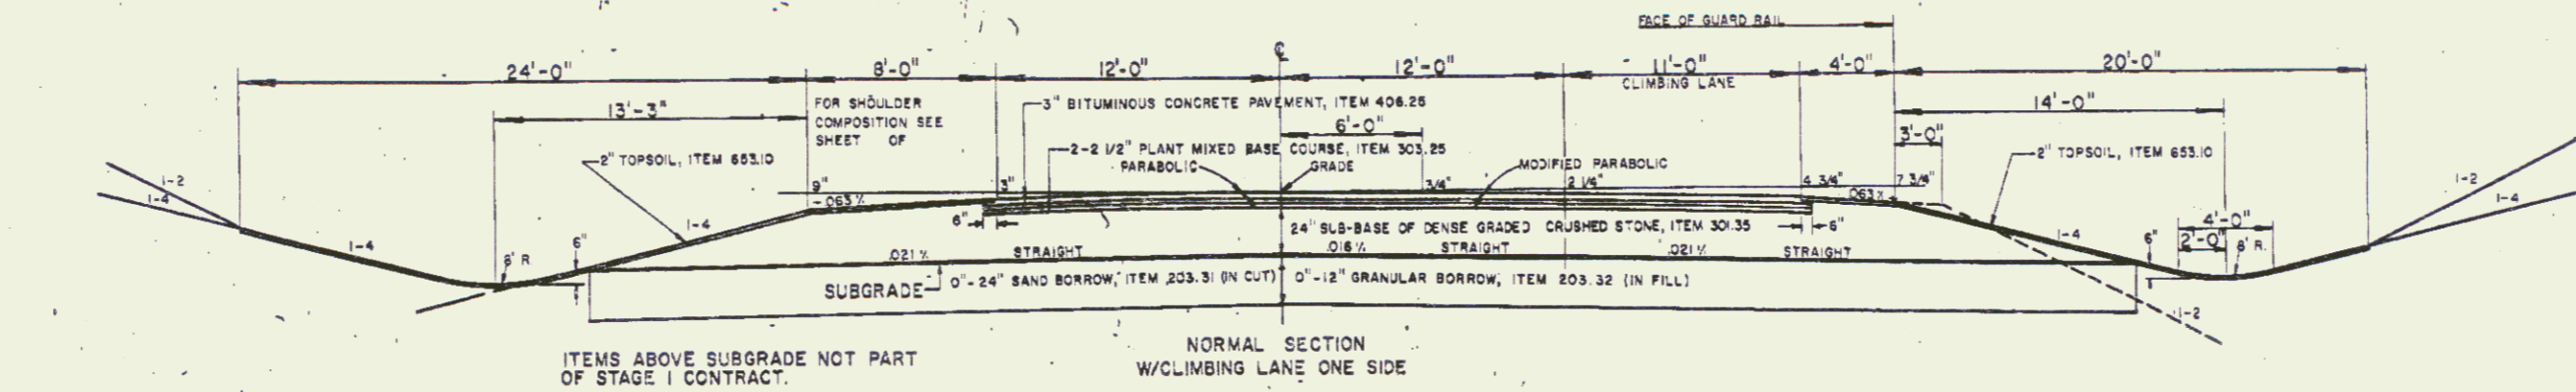

FOR GENERAL NOTES, SHOULDER COMPOSITION AND DITCH DETAILS SEE SHEET OF SHEETS

CONTRACT 2
MANCHESTER-DORSET

SURVEYED BY _____ DATE _____
 DRAWN BY B. BOYD DATE 10/88
 TRACED BY DUFFY DATE 11/88

STAGE I CONSTRUCTION

PROJ. RF NO. 019-2(14) SECT. 2

SHEET 3 OF 28

AUG 2 1994