
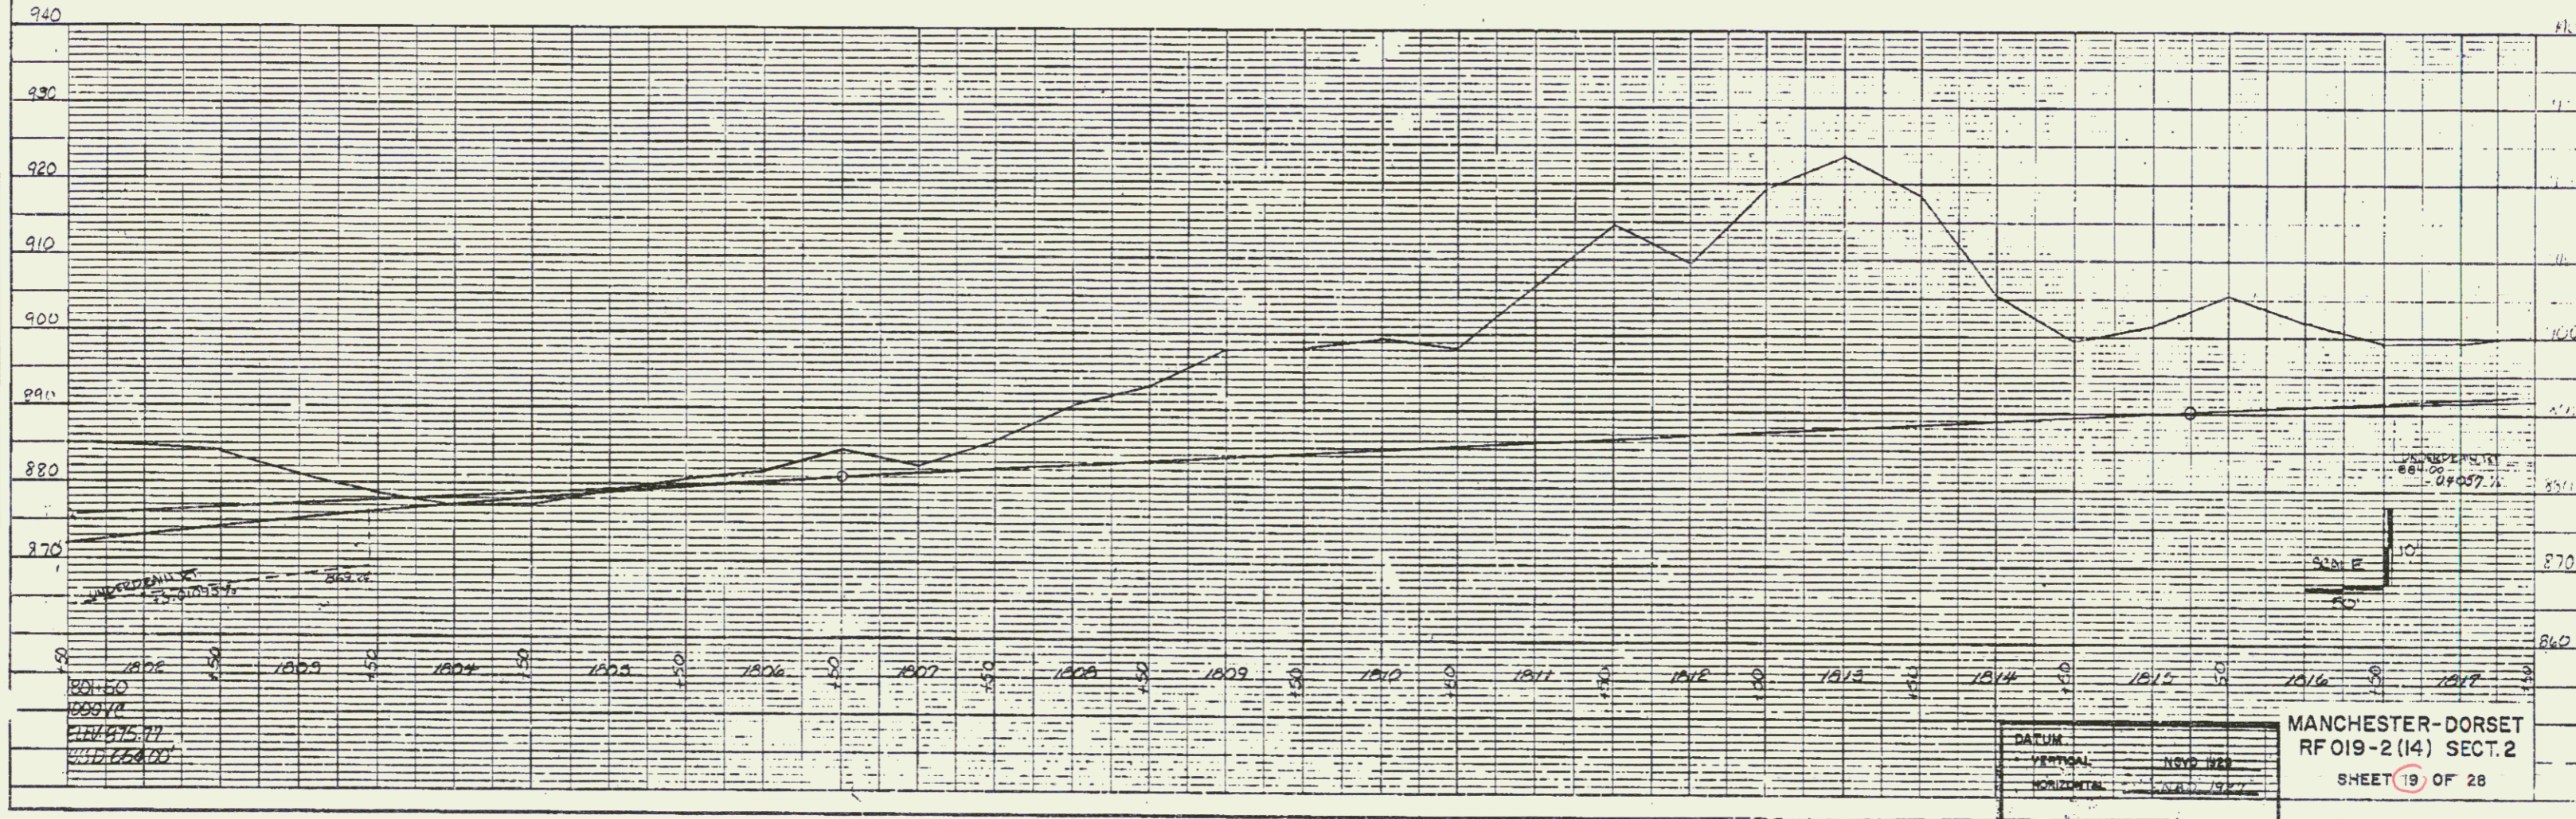


PLAN
 DATE: 10/1/94
 DRAWN BY: [blank]
 CHECKED BY: [blank]
 NO. OF SHEETS: 28

PROFILE
 DATE: 10/1/94
 DRAWN BY: [blank]
 CHECKED BY: [blank]
 NO. OF SHEETS: 28

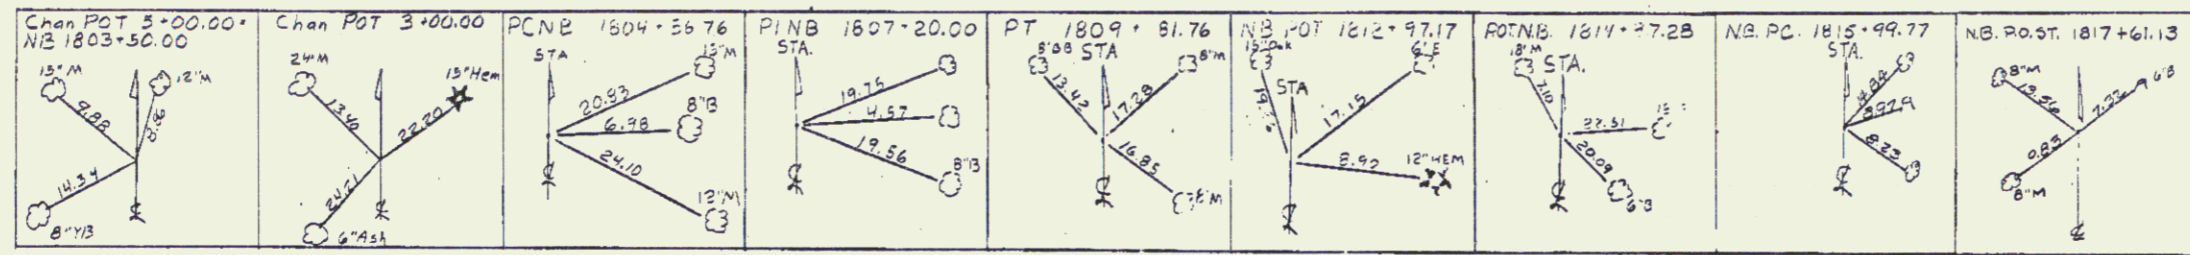

DATUM
 VERTICAL: NSVD 1985
 HORIZONTAL: L.M.A.D. 1987

MANCHESTER-DORSET
 RF 019-2 (14) SECT. 2
 SHEET 19 OF 28

K-E PLAN & PROFILE
 1/4" = 100' & 1" = 10'

AUG 2 1994 63