
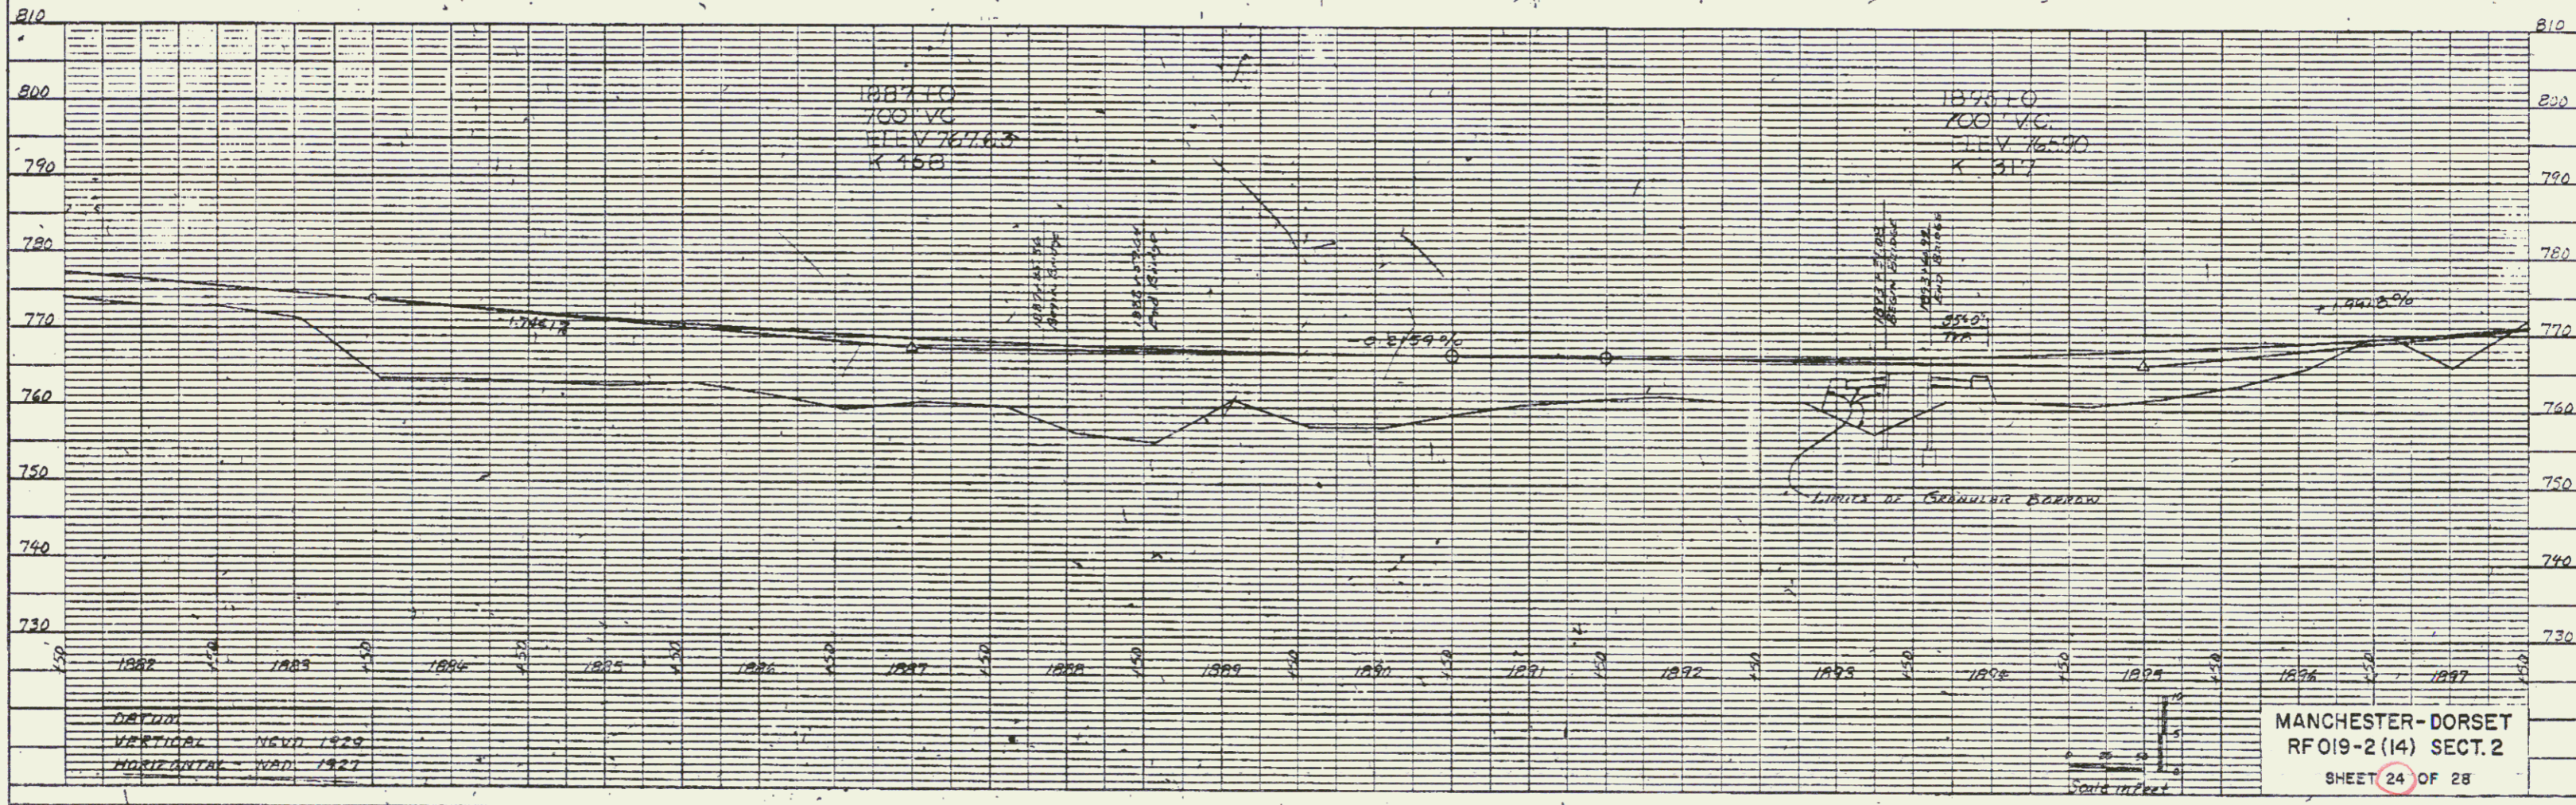


PLAN
 DRAWN BY: []
 CHECKED BY: []
 DATE: []

PROFILE
 DRAWN BY: []
 CHECKED BY: []
 DATE: []

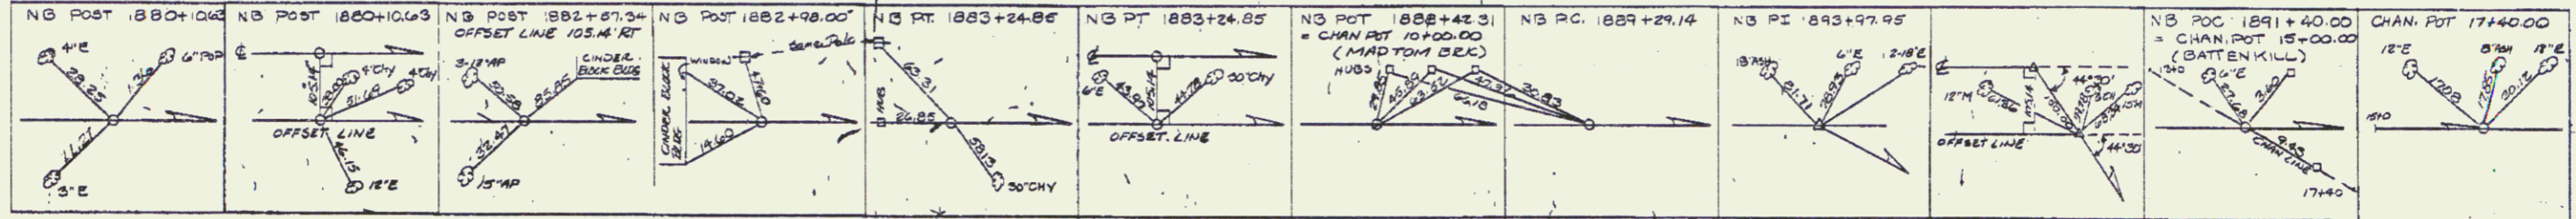

DATUM
 VERTICAL - NGVD 1929
 HORIZONTAL - NAD 1927

MANCHESTER-DORSET
 RF 019-2 (14) SECT. 2
 SHEET 24 OF 28

K&E PLATE 1, PLAN/PROFILE
 SCALE: 1/4" = 100'

AUG 2 1994 68