
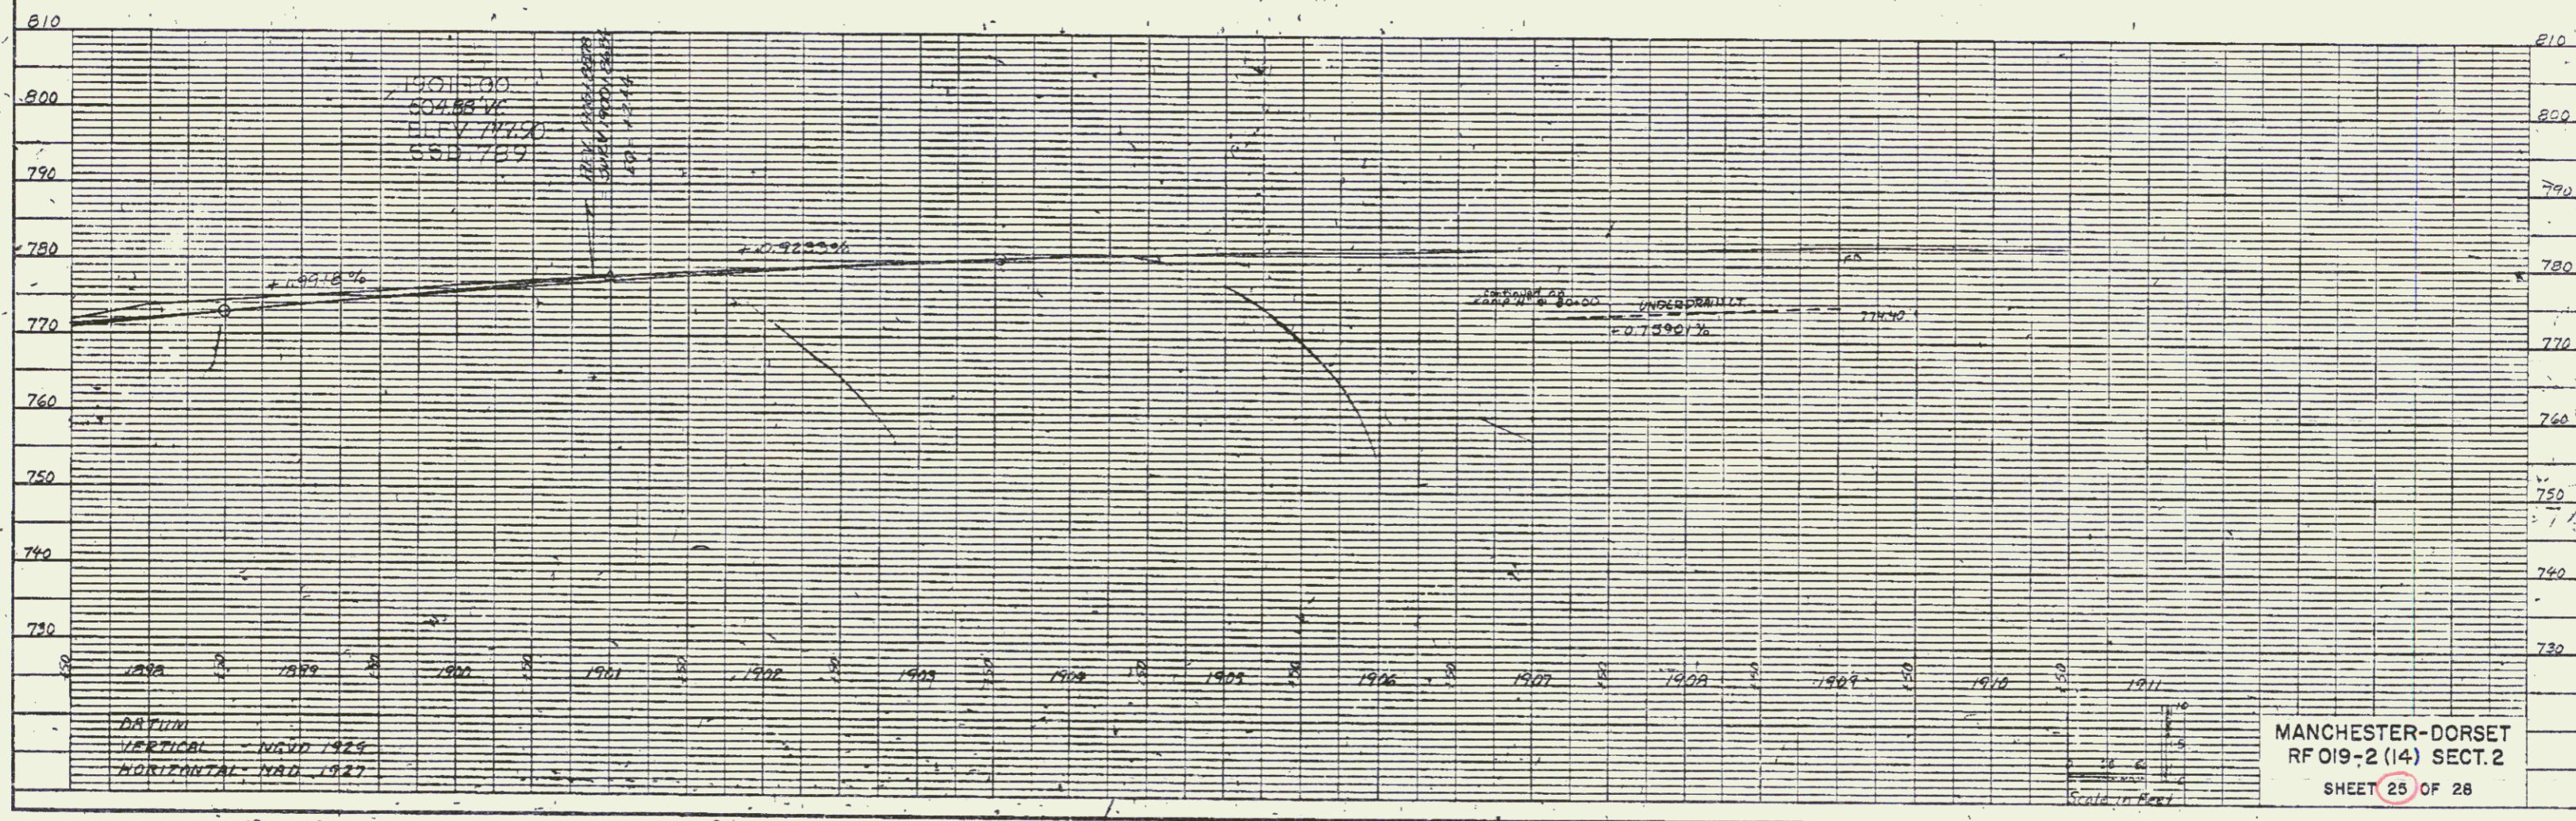


PLAN
 DATE BOOK
 PROJECT
 SHEET NO.

PROFILES
 DATE BOOK
 PROJECT
 SHEET NO.

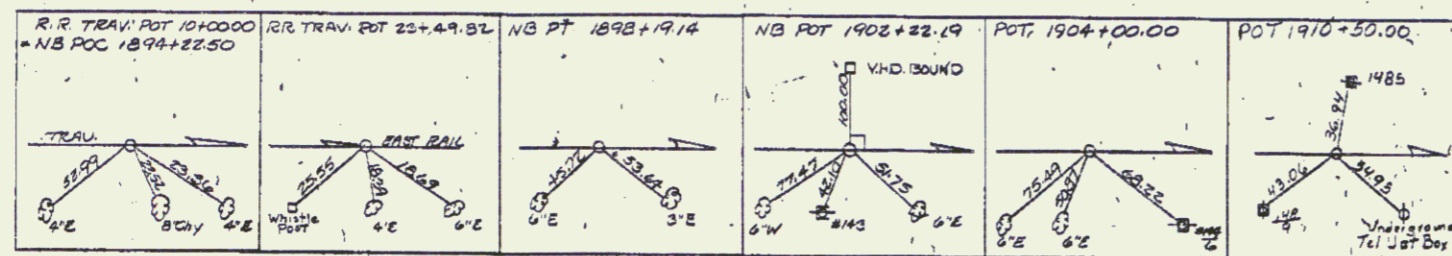

K&E PLATS, PLAN/PROFILE

AUG 2 1994

69