

DATE	
BY	
DESIGNED BY	
CHECKED BY	
IN CHARGE	
DATE	
BY	
DESIGNED BY	
CHECKED BY	
IN CHARGE	

DATE	
BY	
DESIGNED BY	
CHECKED BY	
IN CHARGE	
DATE	
BY	
DESIGNED BY	
CHECKED BY	
IN CHARGE	

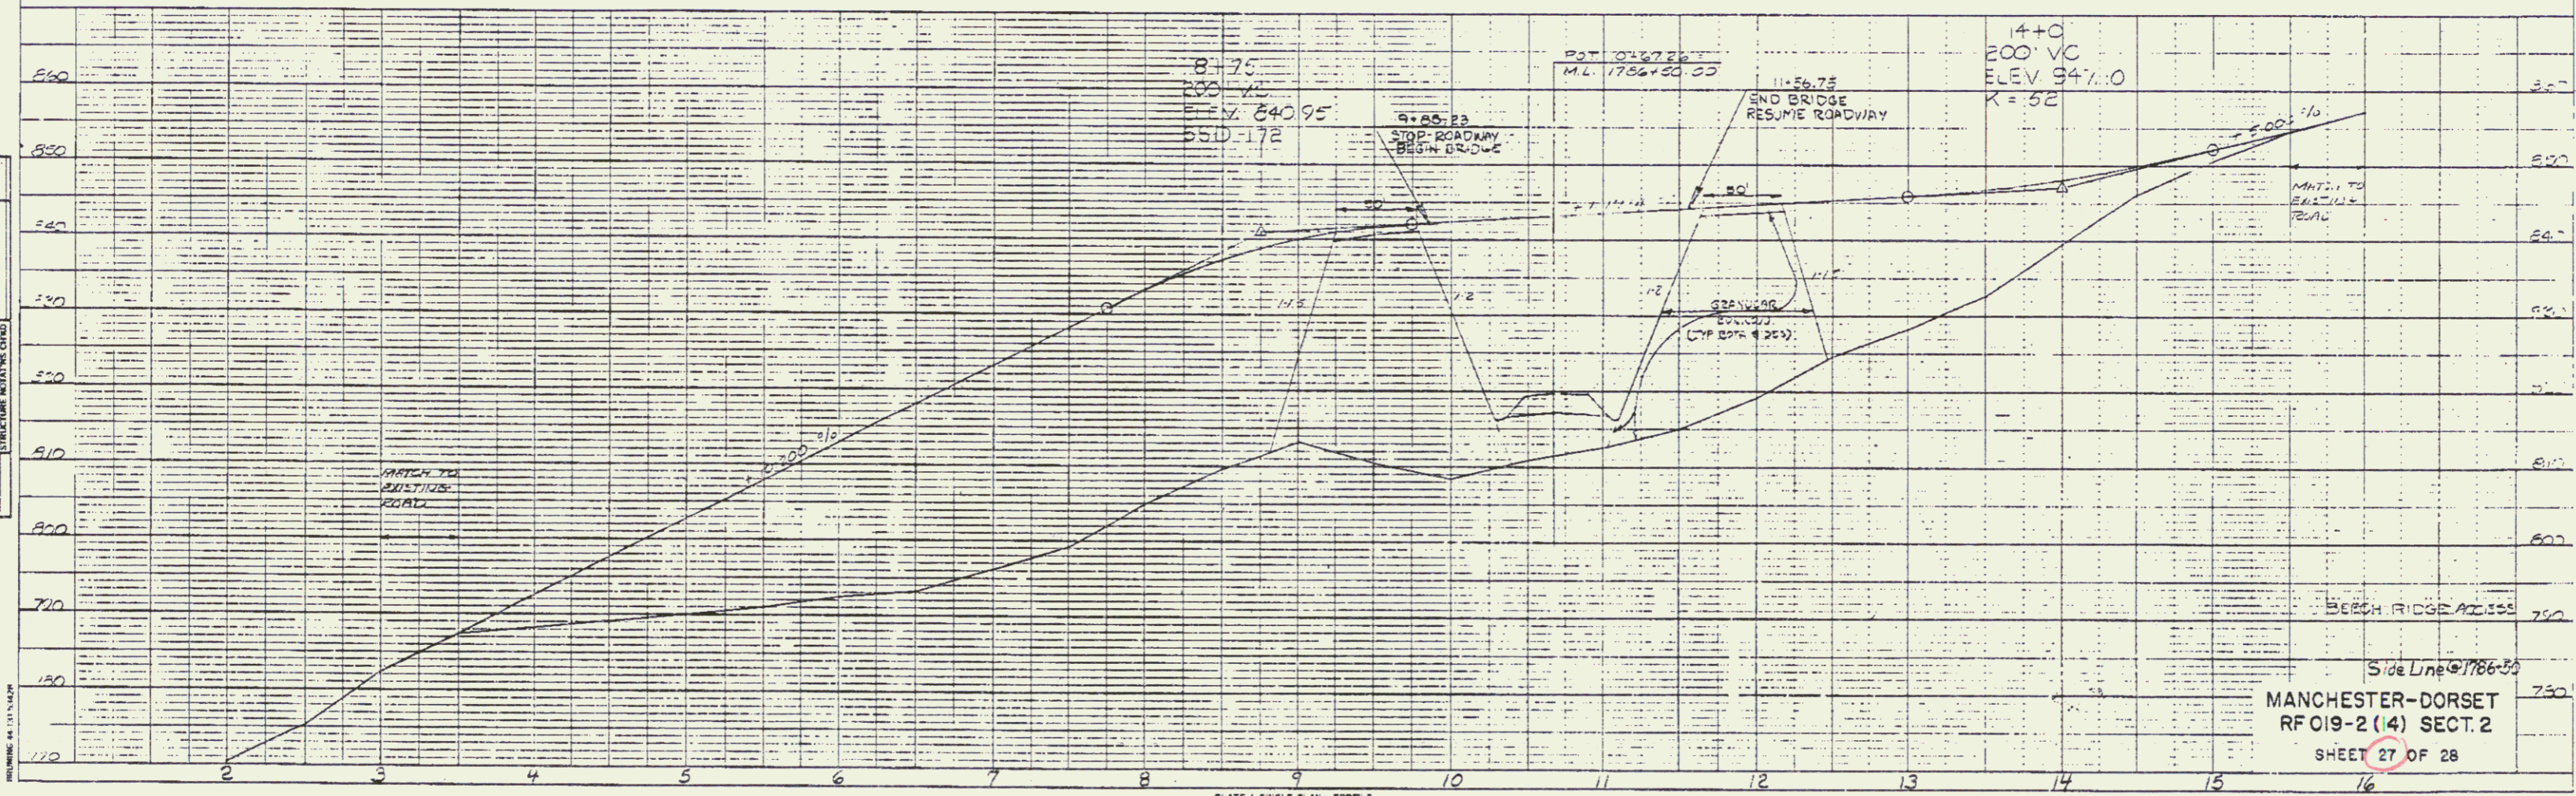
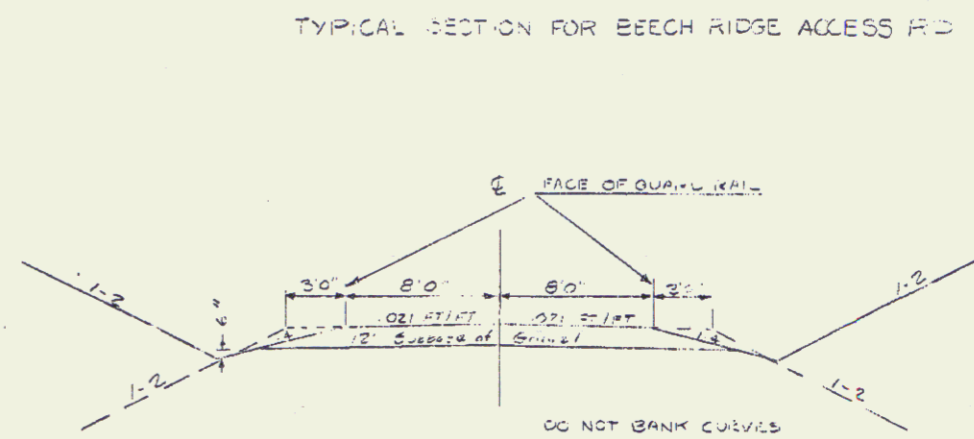
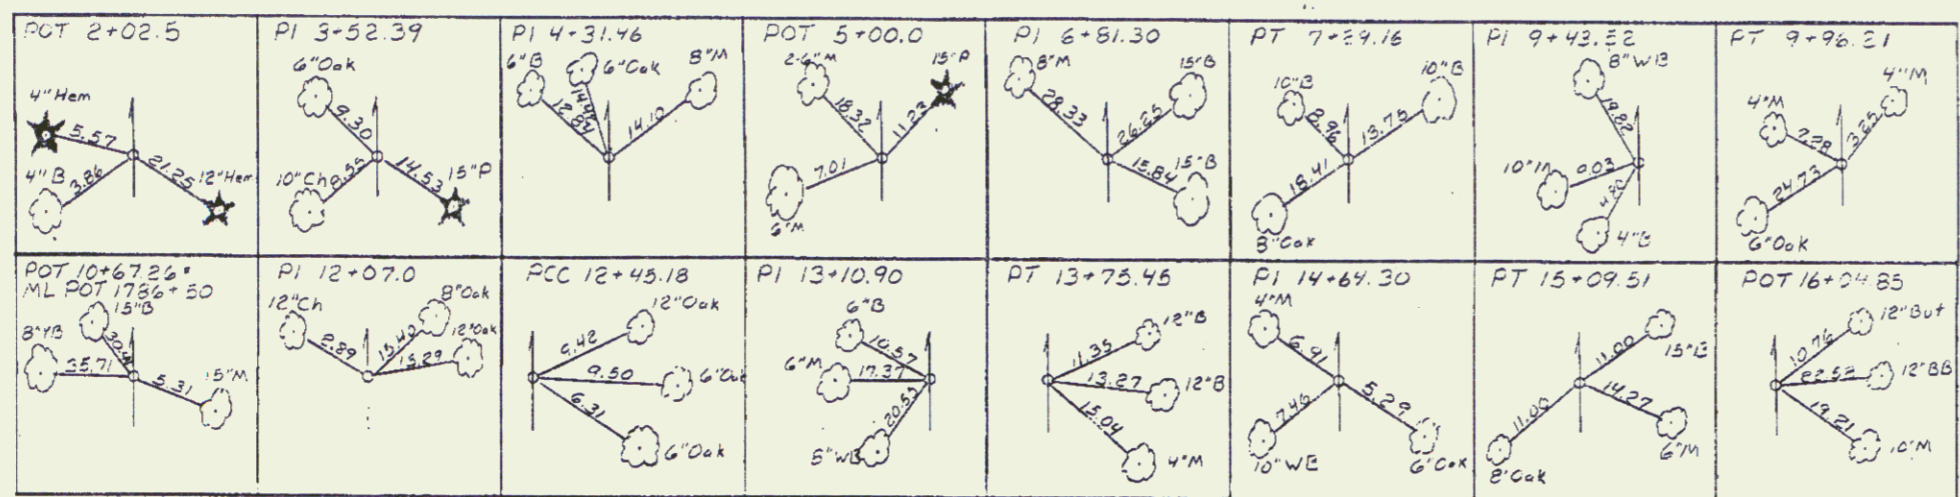


PLATE 1 SINGLE PLAN - PROFILE  
CHARLES BRUNING CO.

71  
AUG 2 1934