
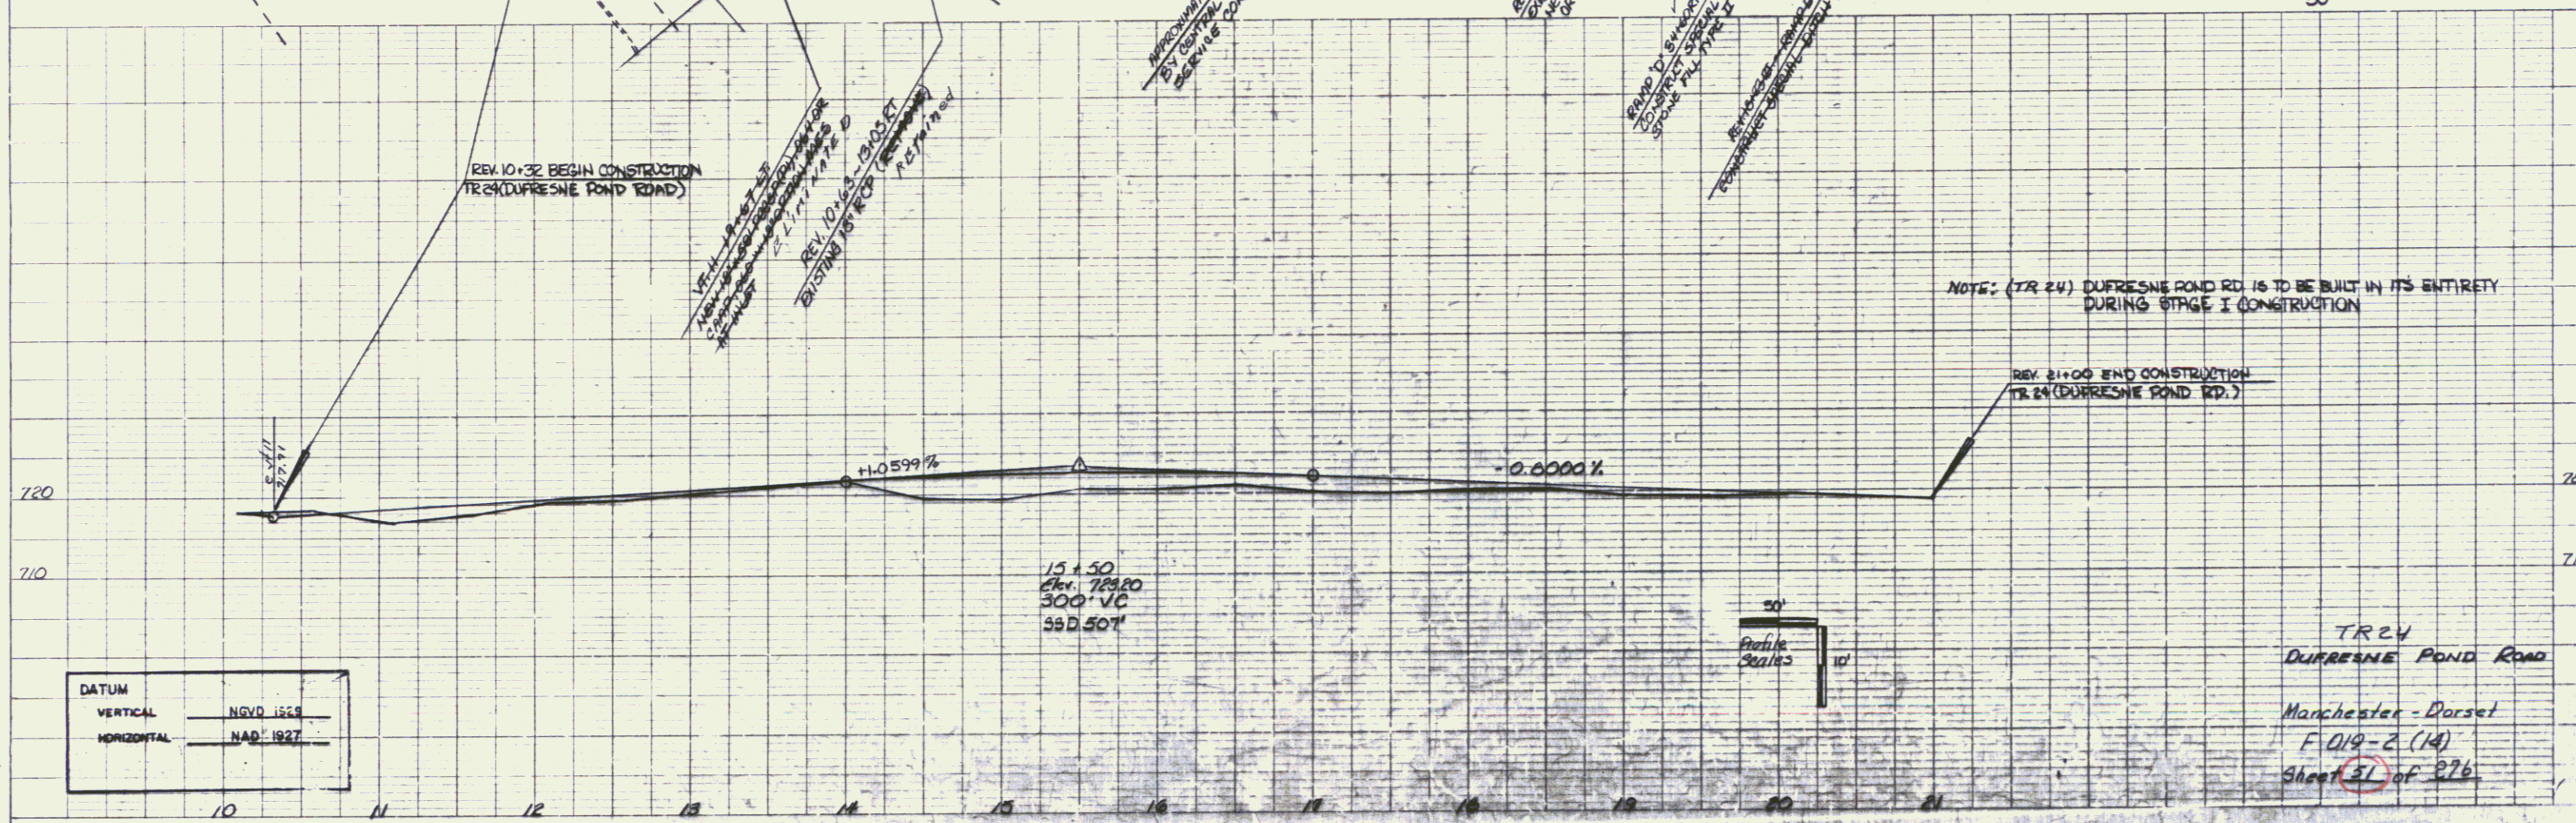
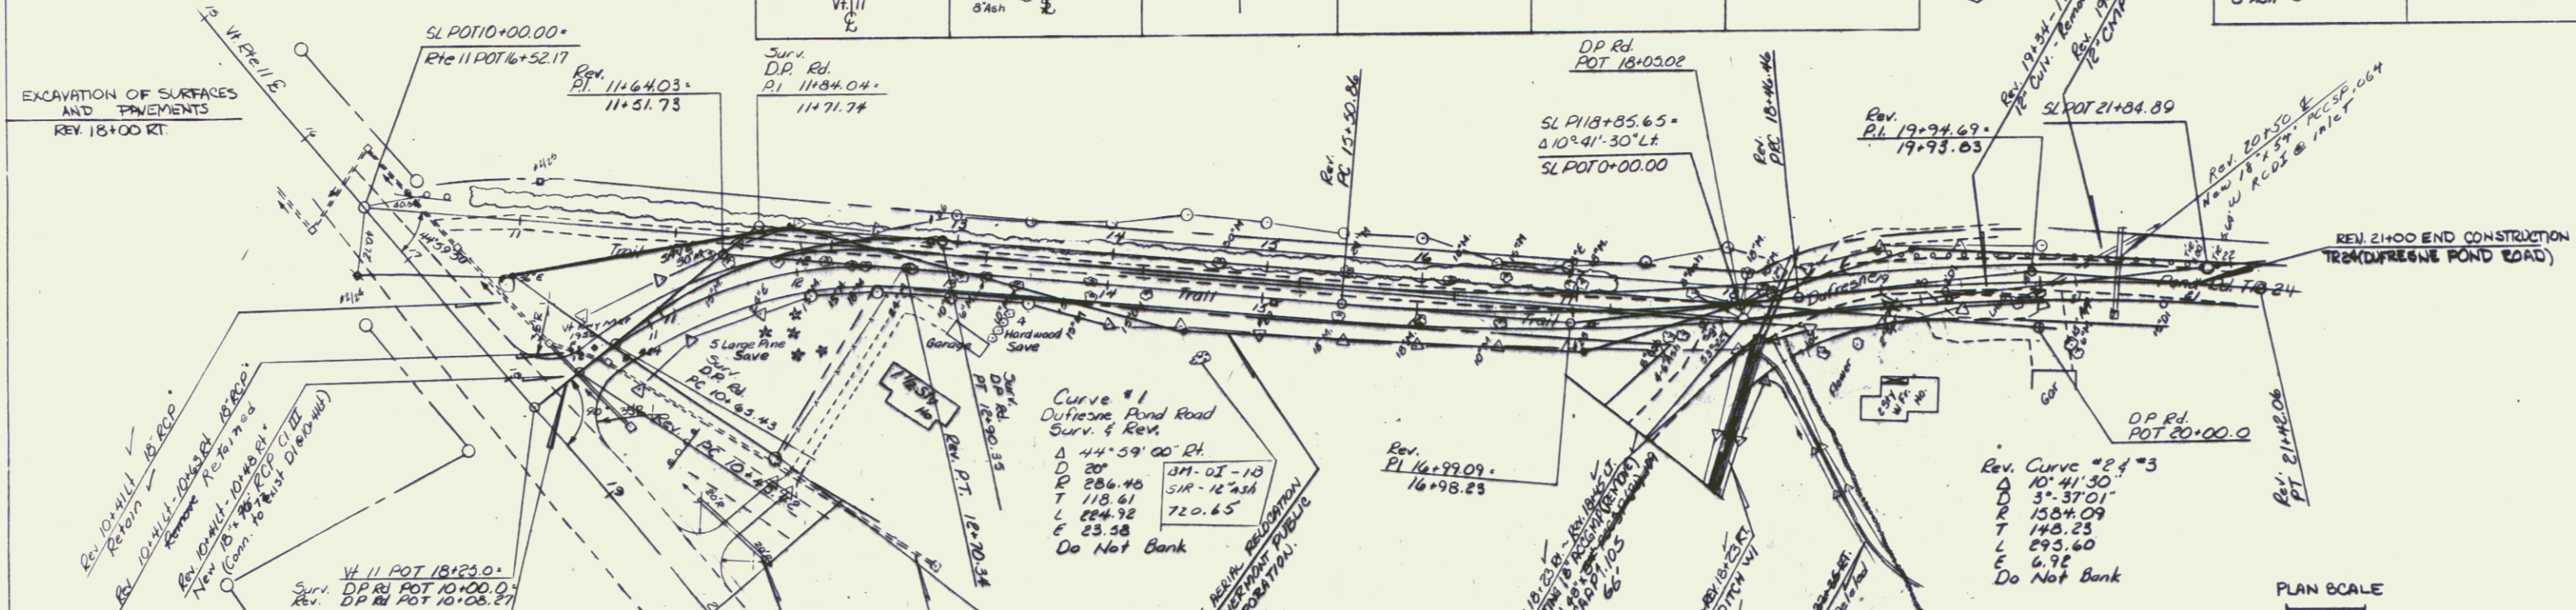
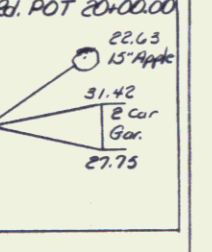
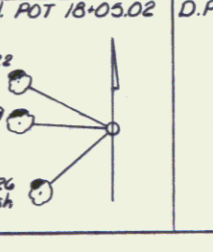
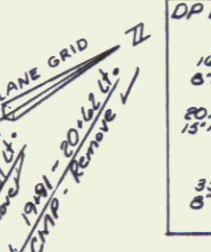
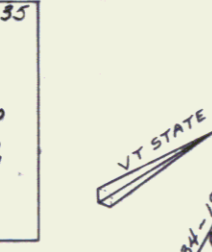
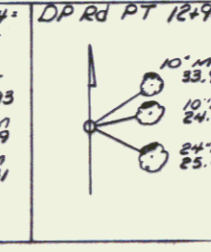
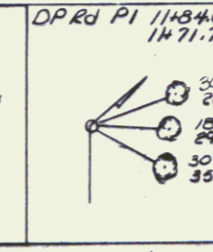
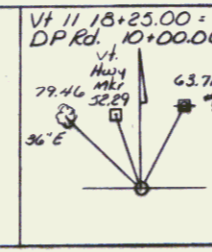
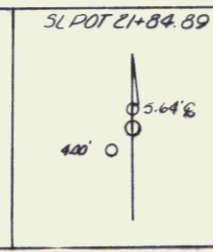
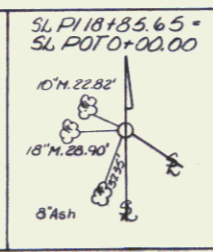


**CONSTRUCT DRIVE**  
 REV. 18+65 LT.  
 REV. 19+20 RT.  
 REV. 20+00 RT.  
 Vt. 11 19+67, Lt.

**CABLE GUARD RAIL**  
 REV. 11+86 LT. ~ REV. 18+65 LT. 18+40  
 REV. 19+66 LT. ~ REV. 20+92 LT. 18+92  
 21+10

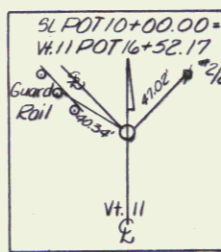

DATUM	
VERTICAL	NGVD 1958
HORIZONTAL	NAD 1927

TR 24  
 DUFRESNE POND ROAD  
 Manchester - Dorset  
 F 019-2 (14)  
 Sheet 31 of 276