


DRILLING AND BLASTING
OF SOLID ROCK SUBGRADE
1801+50 ~ 1818+00 ✓

* STEEL BEAM GUARD RAIL
1817+125 ~ 1818+0 LT

CONSTRUCT CONCRETE
SAFTY BARRIER
1807+42 ~ 1807+58
1813+24 ~ 1813+40

WOVEN WIRE FENCE
W/ STEEL POSTS
1801+50 ~ 1818+00 LT ✓
1801+50 ~ 1818+00 RT ✓

* DENOTES STAGE II CONSTRUCTION

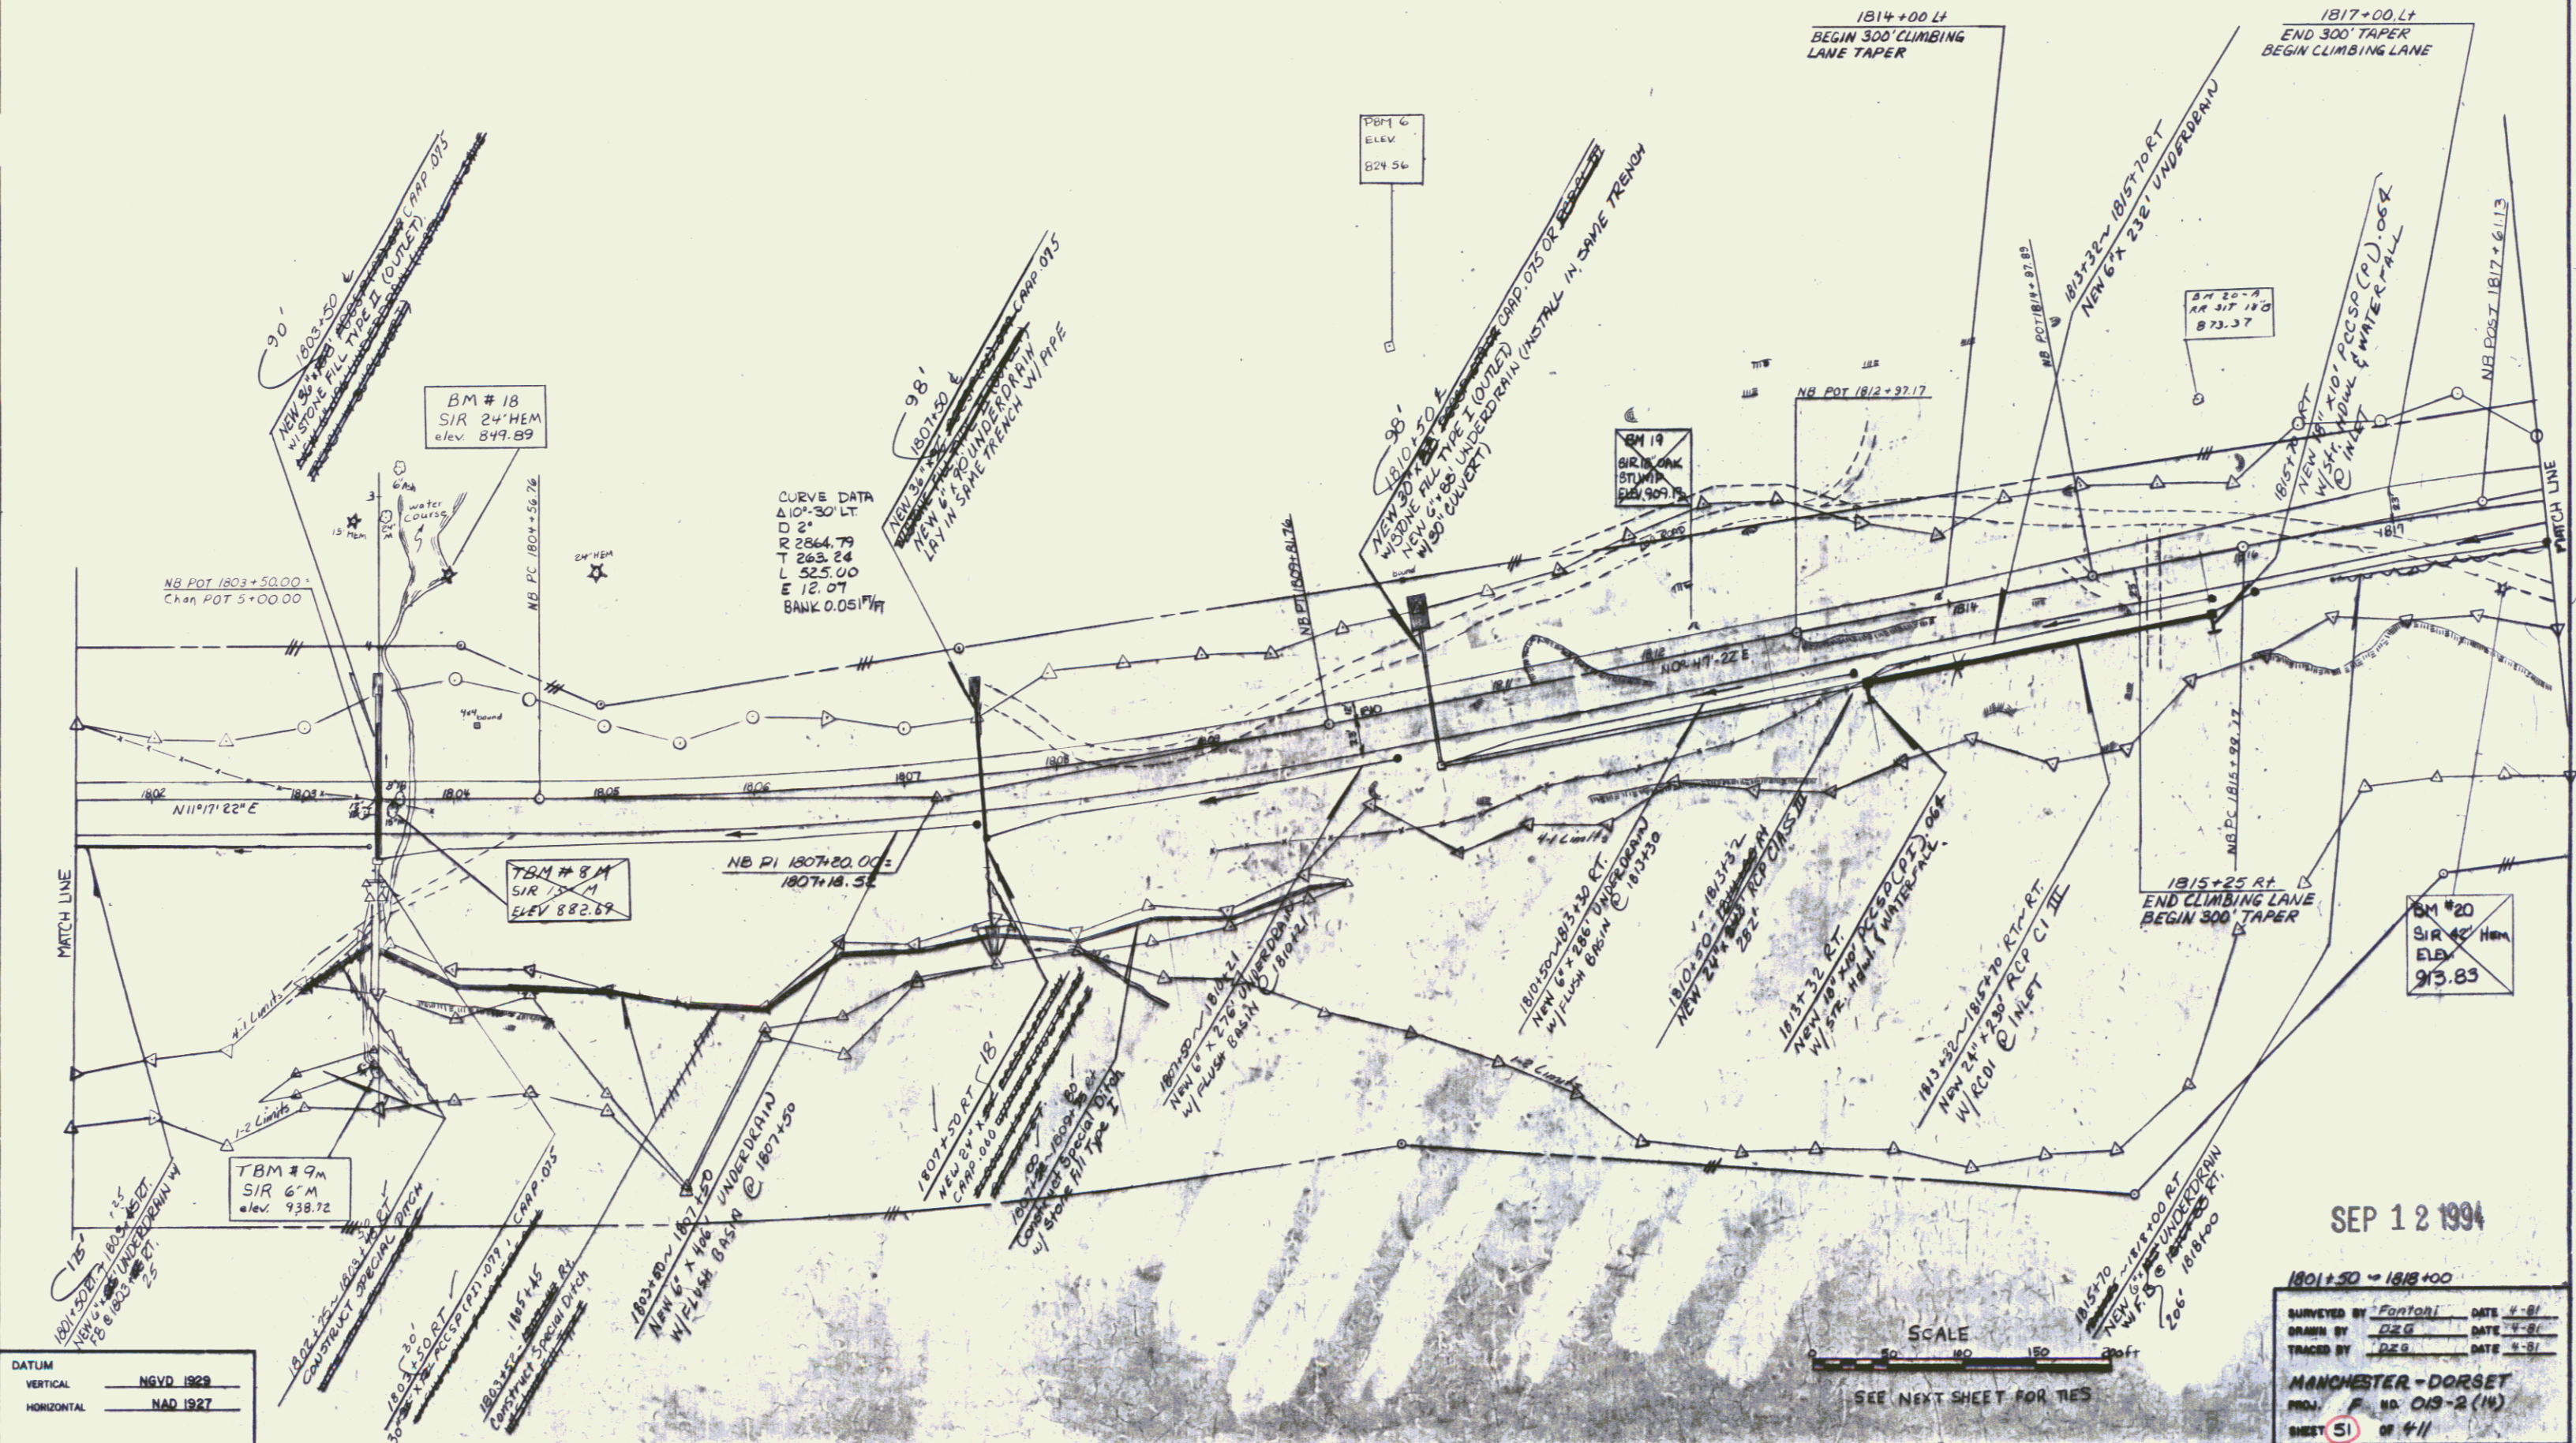

DATUM
VERTICAL: NGVD 1929
HORIZONTAL: NAD 1927

SCALE
0 50 100 150 200
feet
SEE NEXT SHEET FOR TIES

SEP 12 1994
1801+50 ~ 1818+00
SURVEYED BY: Fontana DATE: 4-91
DRAWN BY: DEG DATE: 3-91
TRACED BY: DEG DATE: 3-91
MANCHESTER-DORSET
PROJ. NO. 013-2 (14)
SHEET 51 OF 41

90