

DRILLING AND BLASTING
OF SOLID ROCK SUBGRADE
1818+00 ~ 1825+25 1834+00
1827+75 ~ 1834+00



DRILLING AND BLASTING
OF SOLID ROCK
1818+25 ~ 1827+25 LT
1827+75 ~ 1829+75 LT

*TREATED TIMBER CURB
1825+00 ~ 1834+00 LT

*STEEL BEAM GUARD RAIL
1818+0 ~ 1834+0 LT

CONSTRUCT CONCRETE
SAFETY BARRIER
1821+44 ~ 1821+56
1829+96 ~ 1830+04

WOVEN WIRE FENCE
W/STEEL POSTS
1818+00 ~ 1834+00 LT ✓
1818+00 ~ 1834+00 RT ✓

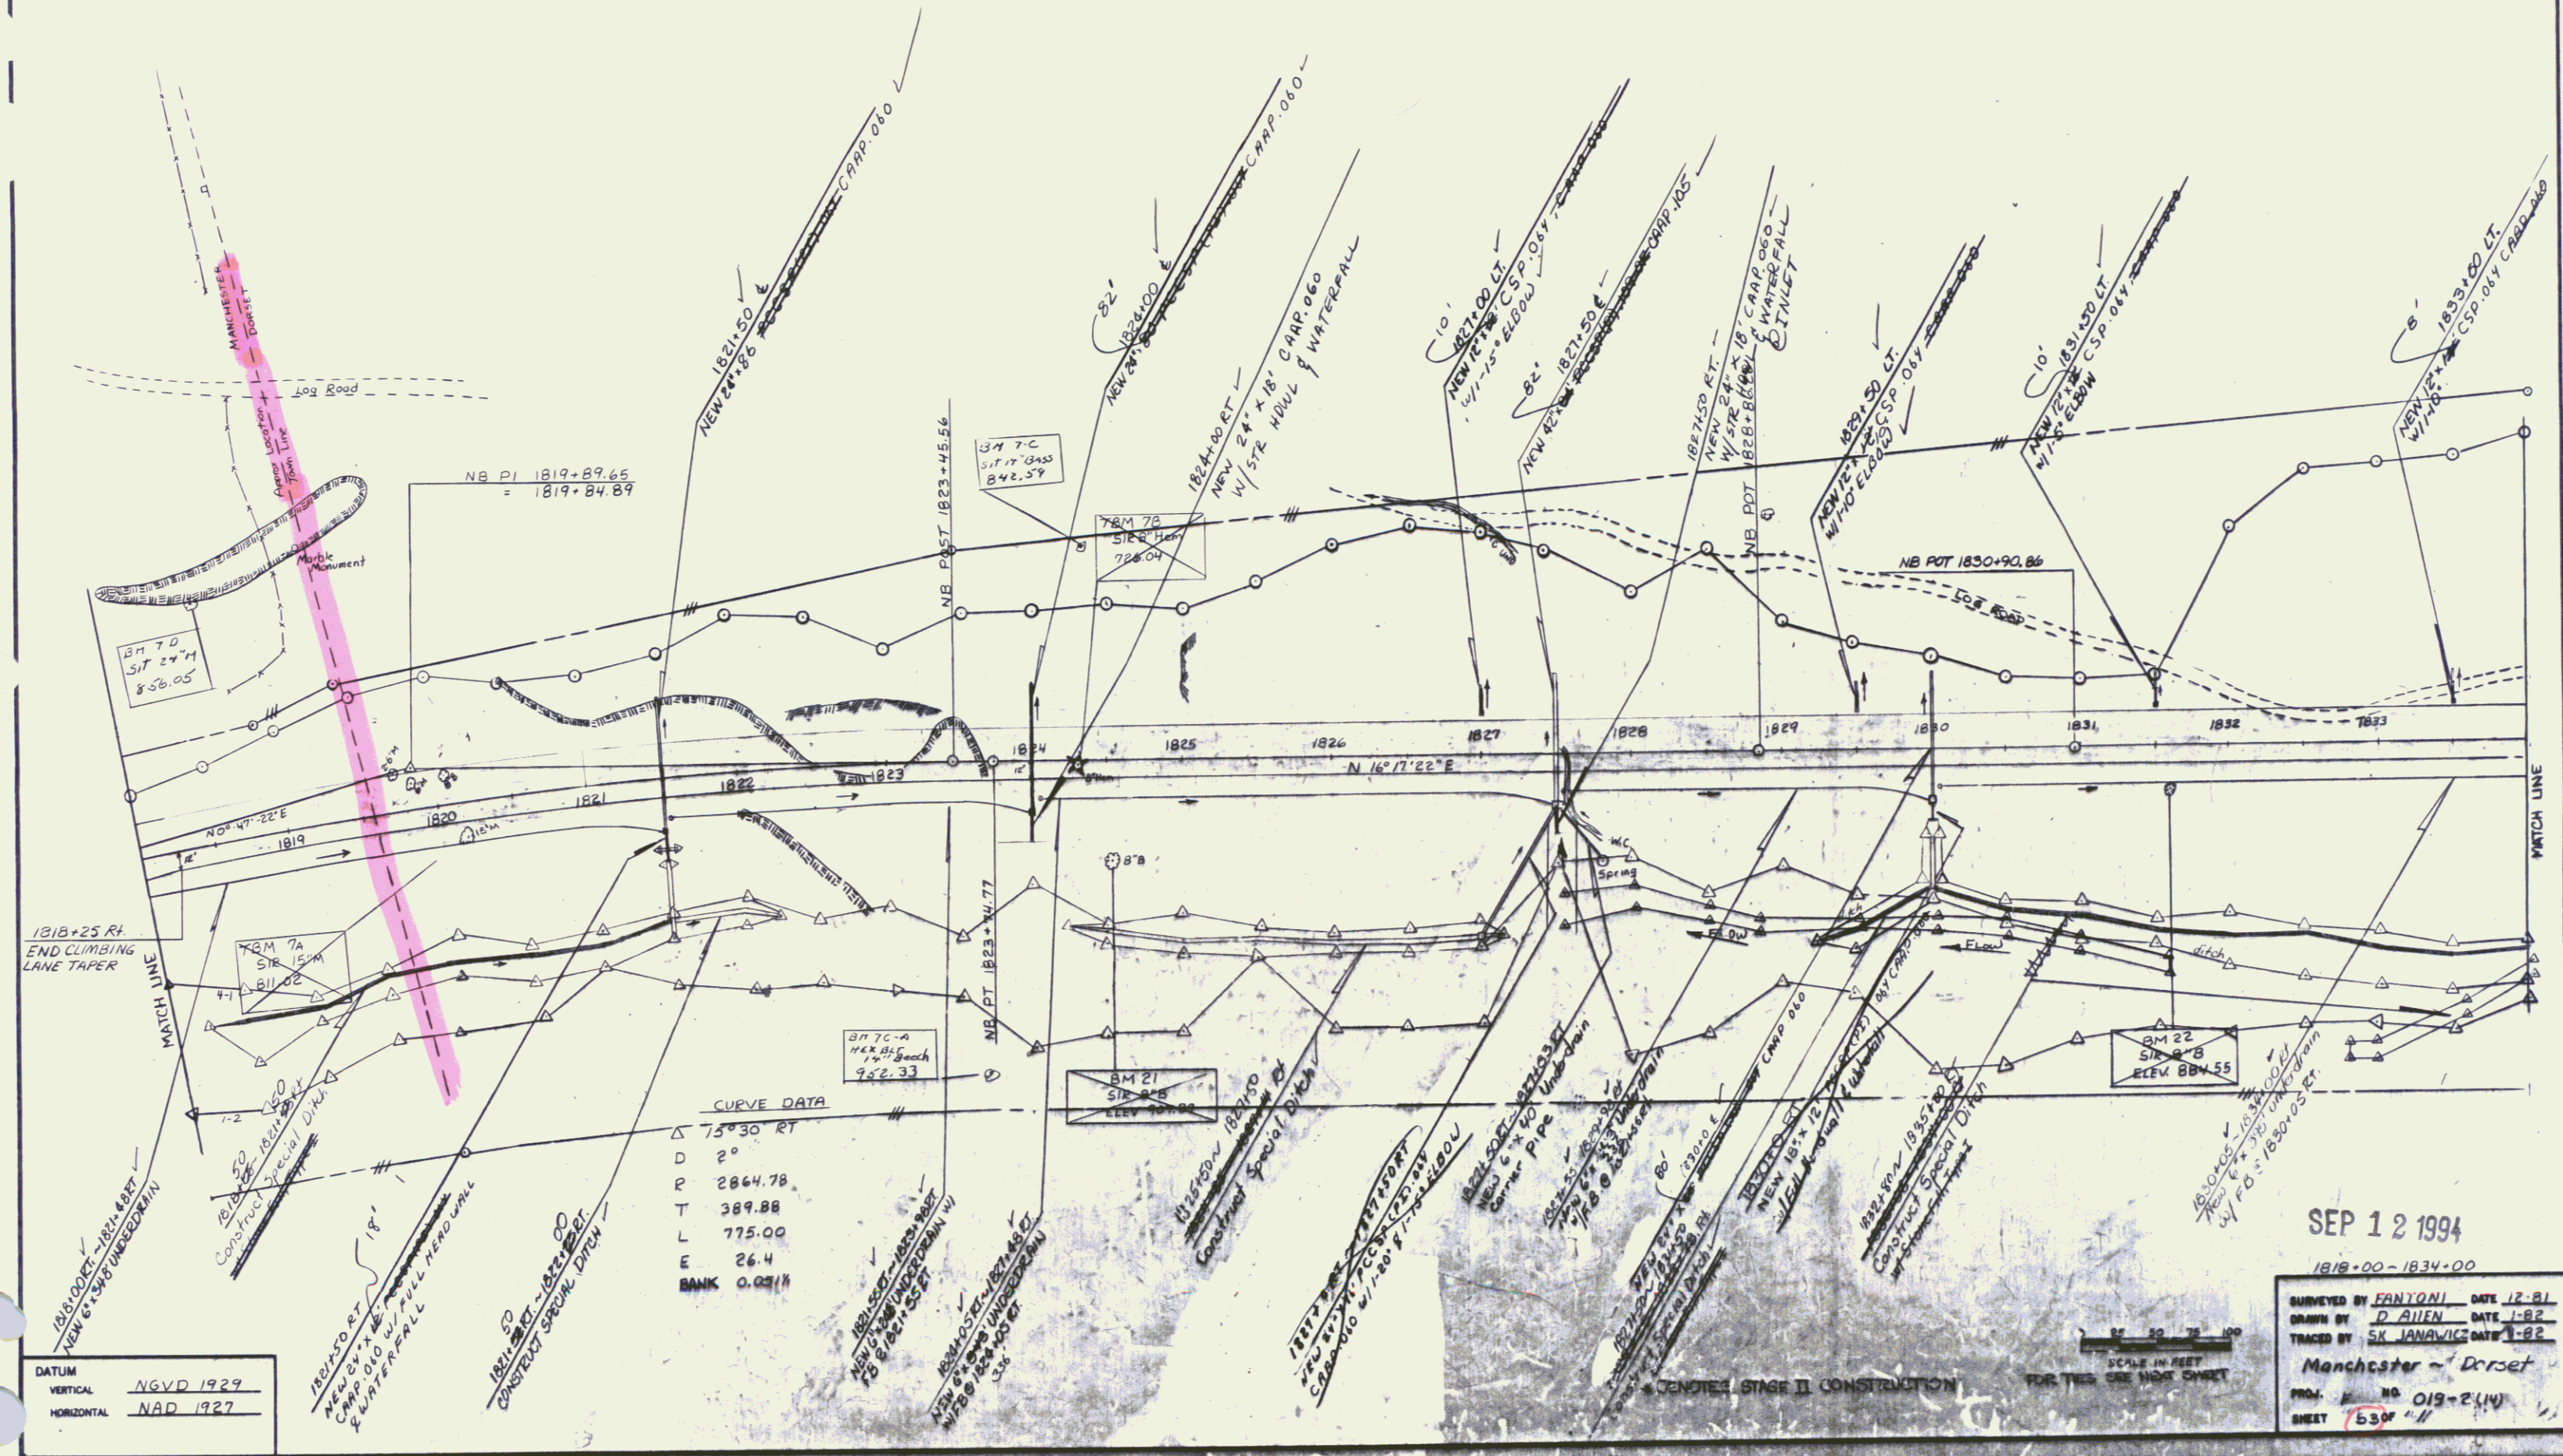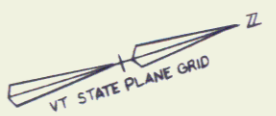

DATUM
VERTICAL NGVD 1929
HORIZONTAL NAD 1927

CURVE DATA
Δ 75°30' RT
D 2°
R 2864.78
T 389.88
L 775.00
E 26.4
BANK 0.02/11

SEP 12 1994
1818+00 ~ 1834+00
SURVEYED BY FANTONI DATE 12-81
DRAWN BY D ALLEN DATE 1-82
TRACED BY SK JANAVIC DATE 1-82
Manchester - Drset
PROJ. NO. 019-2(14)
SHEET 5307